
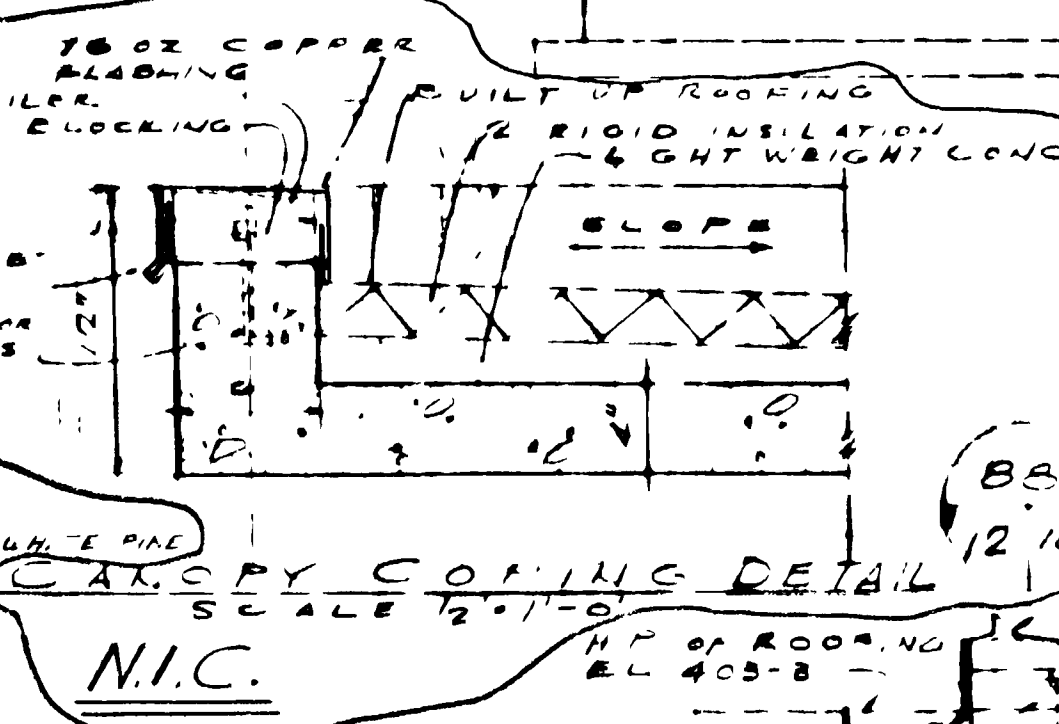


RESTRICTED
SECURITY INFORMATION

Unclassified

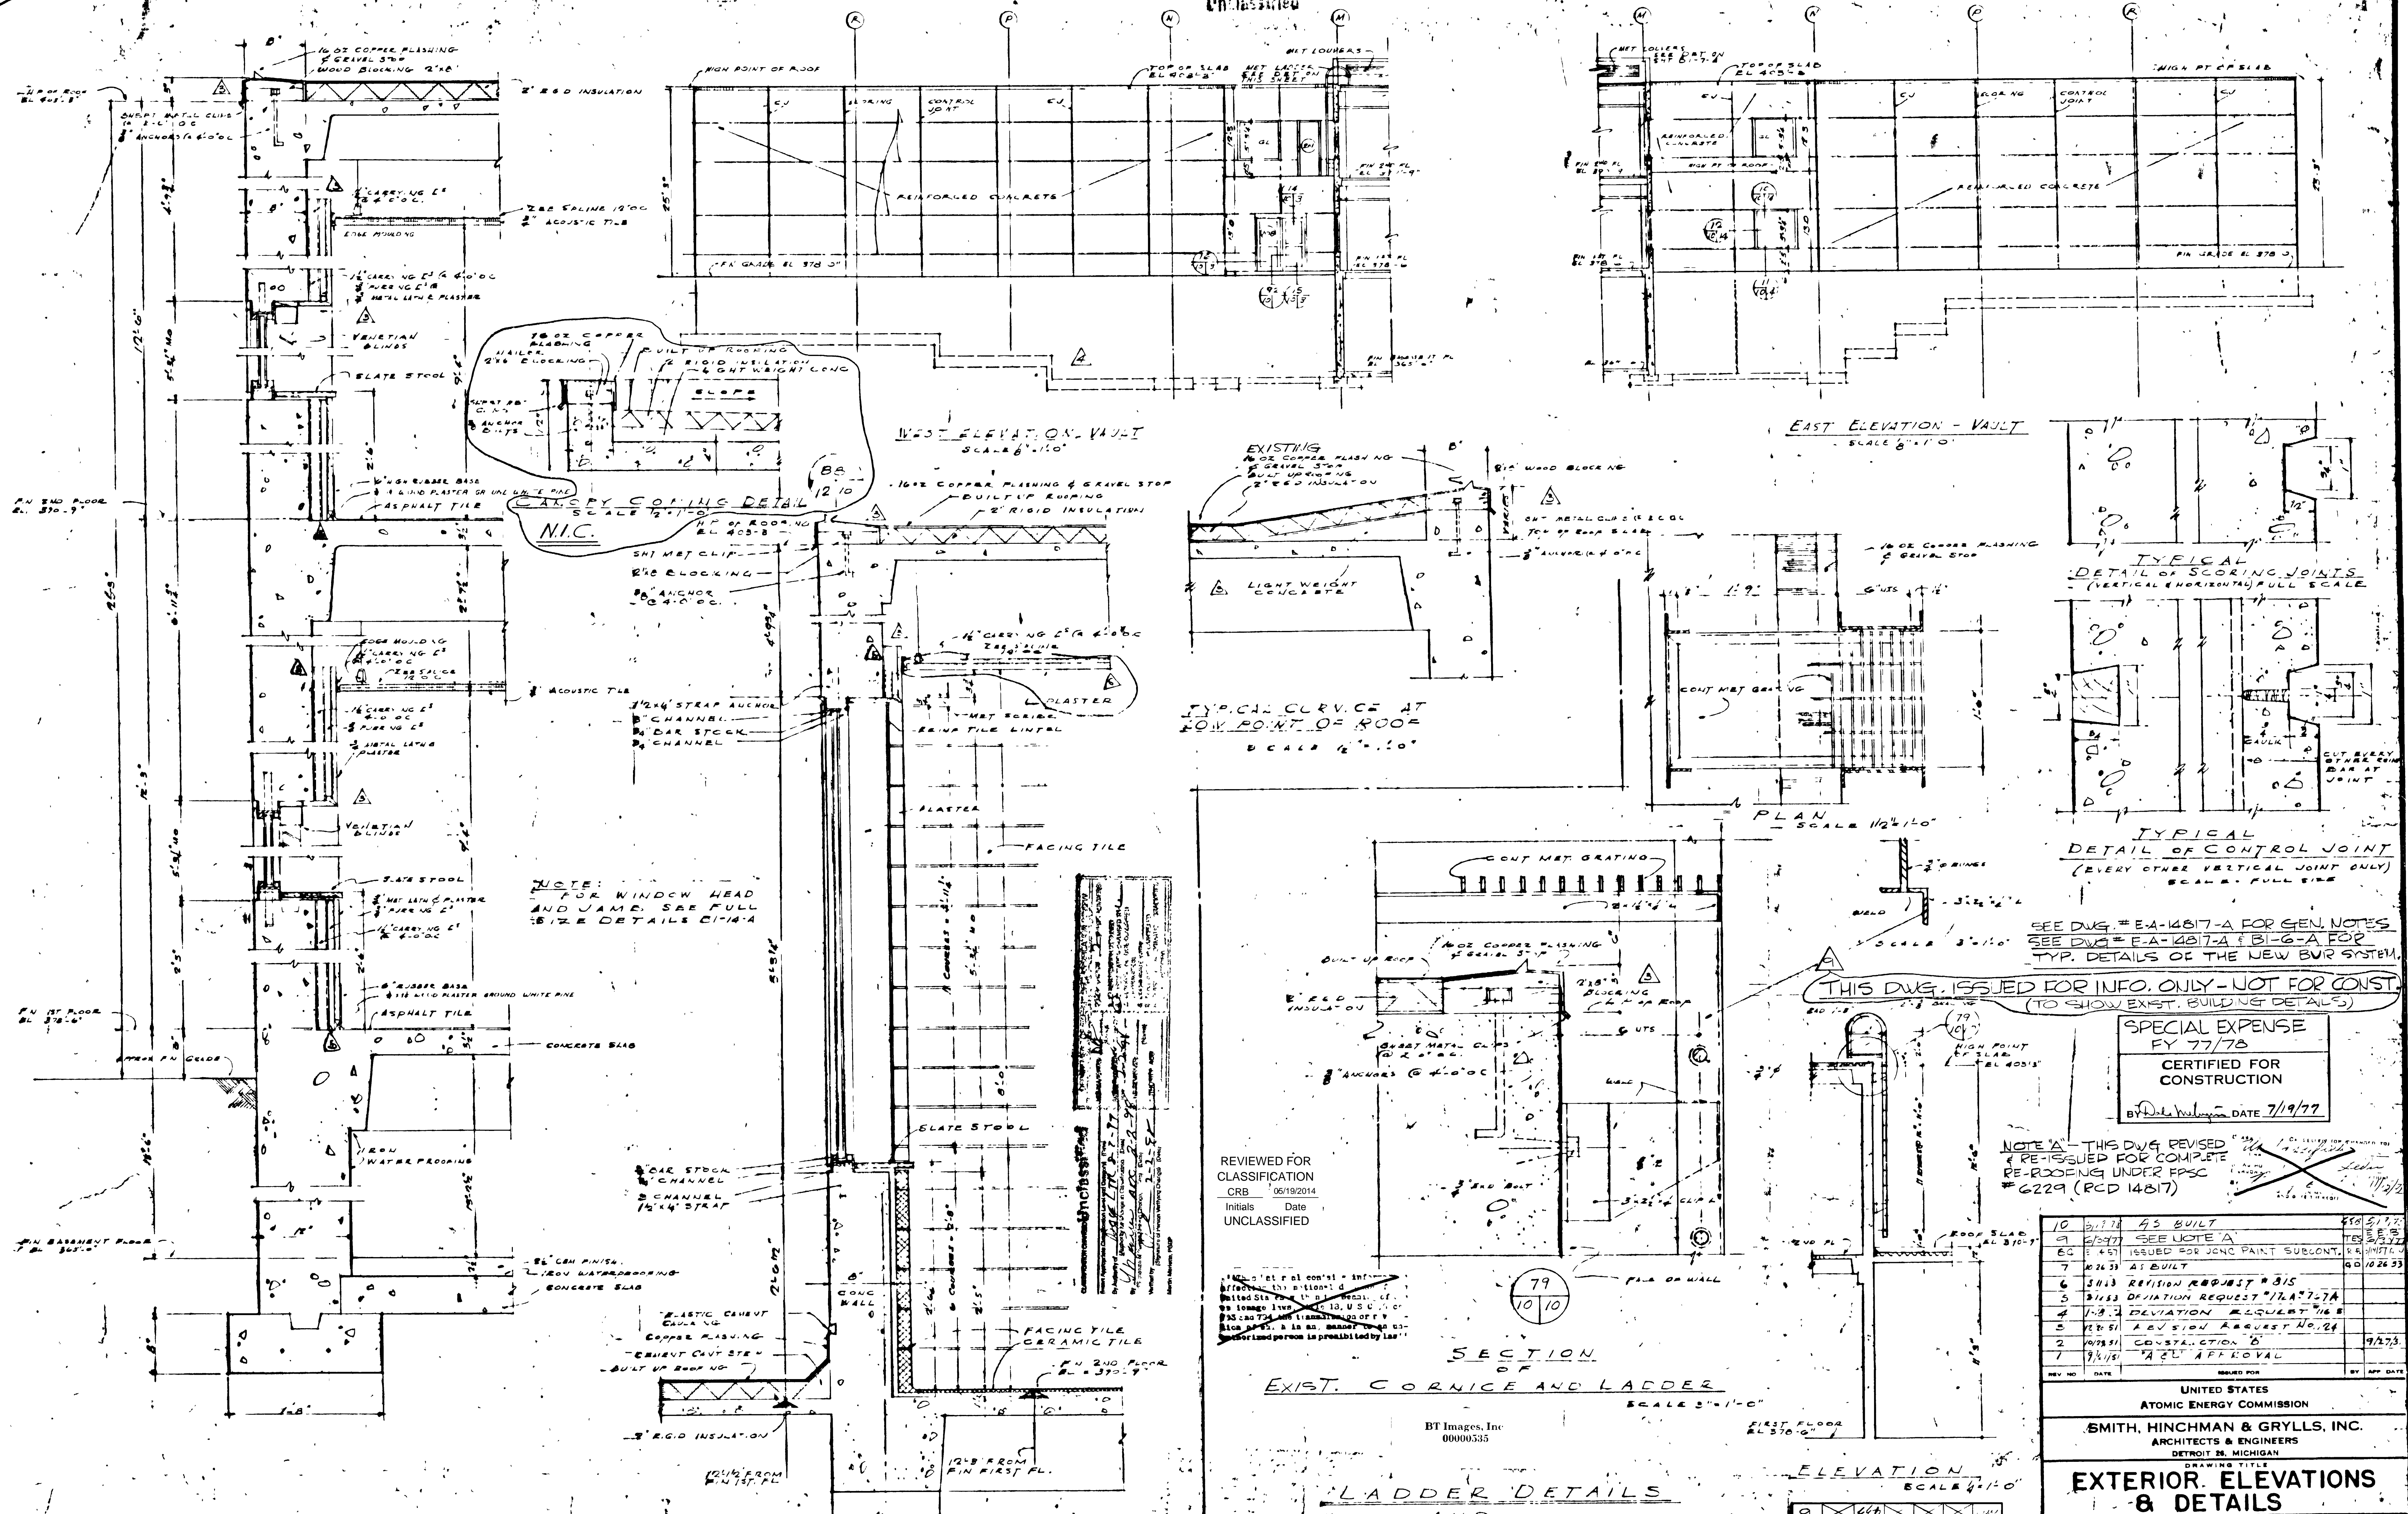

NOTE:
FOR WINDOW HEAD
AND JAMB: SEE FULL
SIZE DETAILS C171-A

TYPICAL
DETAIL OF SCORING JOINTS
(VERTICAL & HORIZONTAL FULL SCALE)

TYPICAL
DETAIL OF CONTROL JOINT
(EVERY OTHER VERTICAL JOINT ONLY)
SCALE: FULL SIZE

SEE DWG. # EA-14817-A FOR GEN. NOTES
SEE DWG. # EA-14817-A & BI-10-A FOR
TYP. DETAILS OF THE NEW E.V.R. SYSTEM.

THIS DWG. ISSUED FOR INFO. ONLY - NOT FOR CONST.
(TO SHOW EXIST. BUILDING DETAILS)

SPECIAL EXPENSE
FY 77/78
CERTIFIED FOR
CONSTRUCTION
BY [Signature] DATE 7/19/77

NOTE 'A' - THIS DWG. REVISED
& RE-ISSUED FOR COMPLETE
RE-ROOFING UNDER FPSC
6229 (PCD 14817)

REVIEWED FOR
CLASSIFICATION
CRB 05/19/2014
Initials Date
UNCLASSIFIED

BT Images, Inc.
00000535

REV NO	DATE	ISSUED FOR	BY	APP. DATE
10	5/1/78	AS BUILT	ES	5/1/78
9	2/2/77	SEE NOTE 'A'	TES	2/2/77
8	4/5/77	ISSUED FOR CONC. PAINT SUBCONTRACT	ES	4/5/77
7	10/26/73	AS BUILT	ES	10/26/73
6	3/14/73	REVISION REQUEST #315	ES	3/14/73
5	3/14/73	DEVIATION REQUEST #71A-727A	ES	3/14/73
4	1/18/73	DEVIATION REQUEST #16	ES	1/18/73
3	12/21/71	REVISION REQUEST NO. 24	ES	12/21/71
2	10/28/71	CONSTRUCTION	ES	10/28/71
1	9/14/71	AS BUILT APPROVAL	ES	9/14/71

UNITED STATES
ATOMIC ENERGY COMMISSION
SMITH, HINCHMAN & GRYLLS, INC.
ARCHITECTS & ENGINEERS
DETROIT 26, MICHIGAN

EXTERIOR ELEVATIONS
& DETAILS

DRAWING APPROVED - DATE	DRAWING APPROVED - DATE	DRAWING APPROVED - DATE
[Signature] 2/22/78	[Signature] 2/22/78	[Signature] 2/22/78
[Signature] 2/22/78	[Signature] 2/22/78	[Signature] 2/22/78
[Signature] 2/22/78	[Signature] 2/22/78	[Signature] 2/22/78

PROJECT: "C" PLANT
BUILDING: ADMINISTRATION C-100
DRAWING TITLE: BI-10-A

MICROFILMED