



RESTRICTED SECURITY INFORMATION


Unclassified

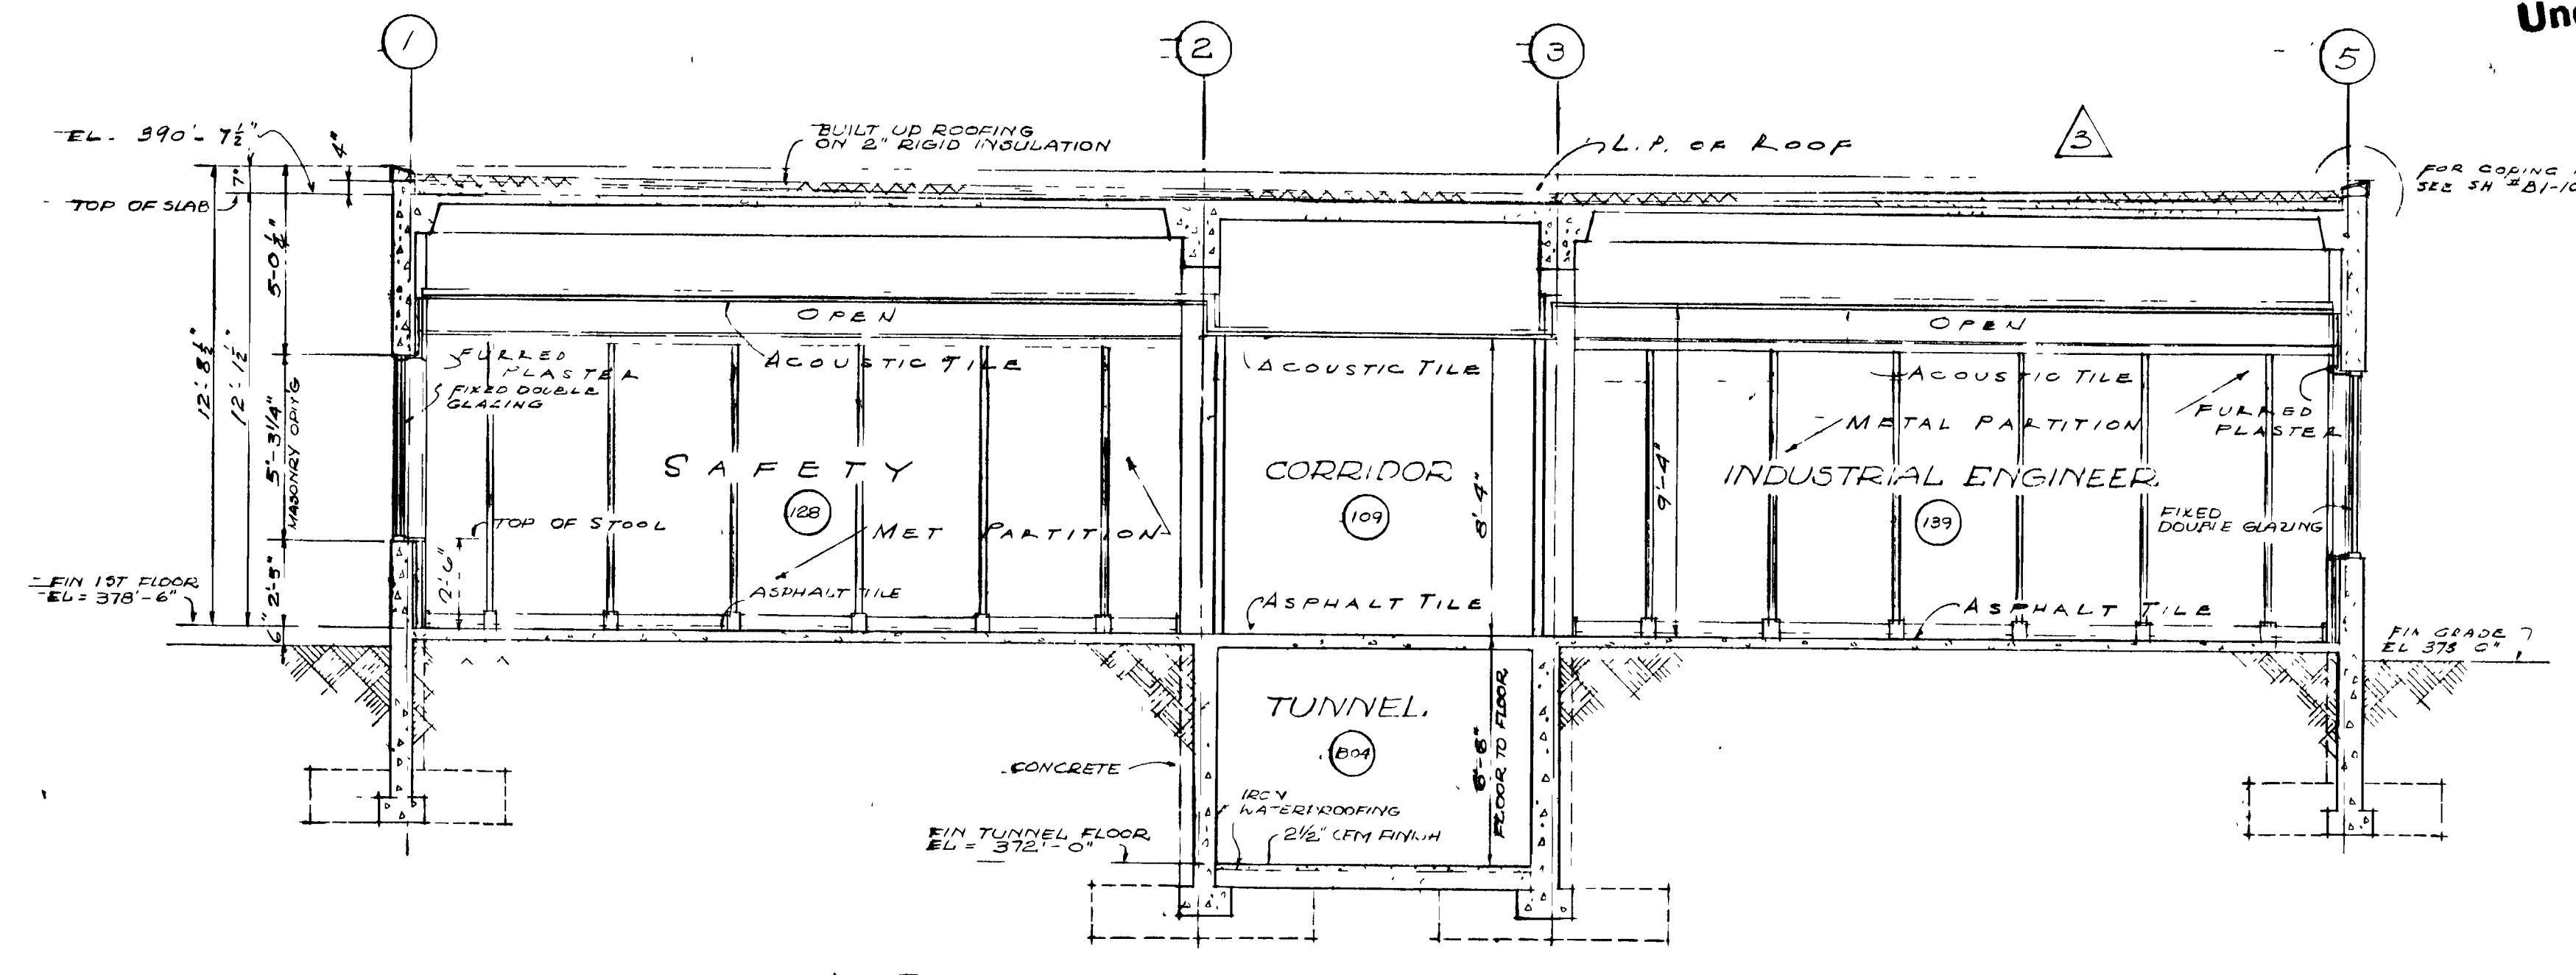


CROSS-SECTION, WEST WING SCALE 1/4" = 1'-0"

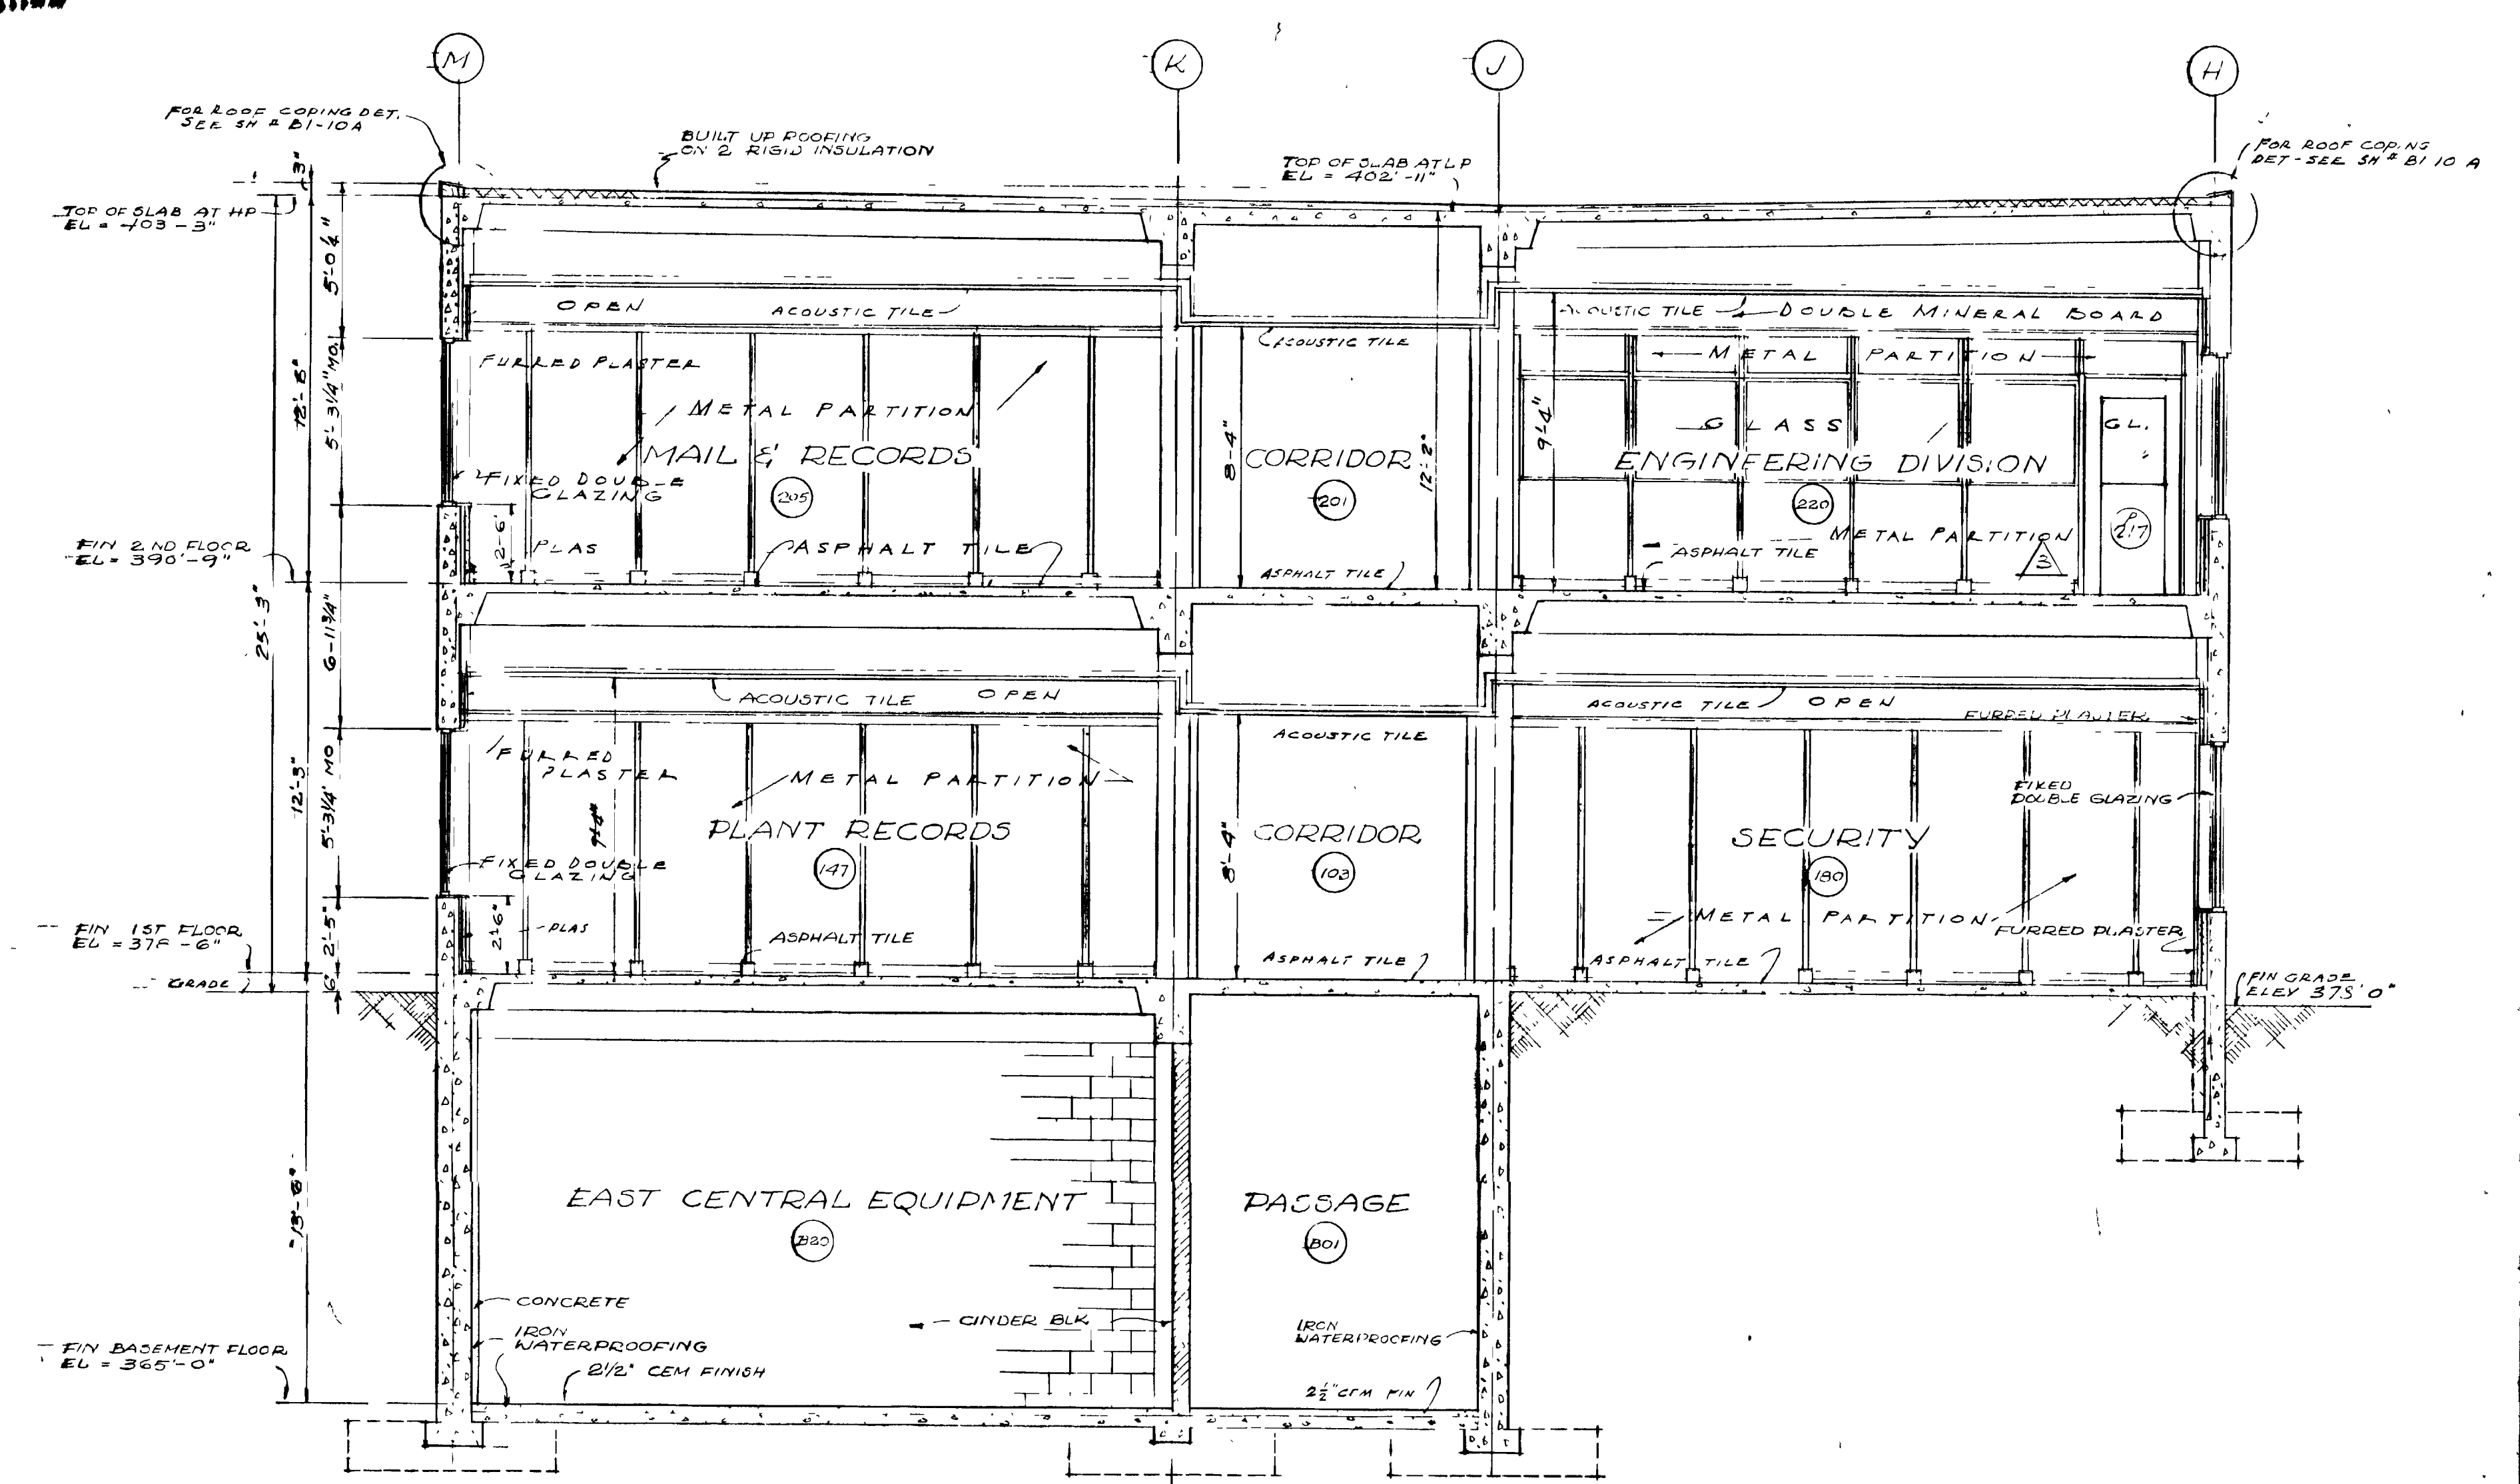


CROSS-SECTION, MAIN WING SCALE 1/4" = 1'-0"

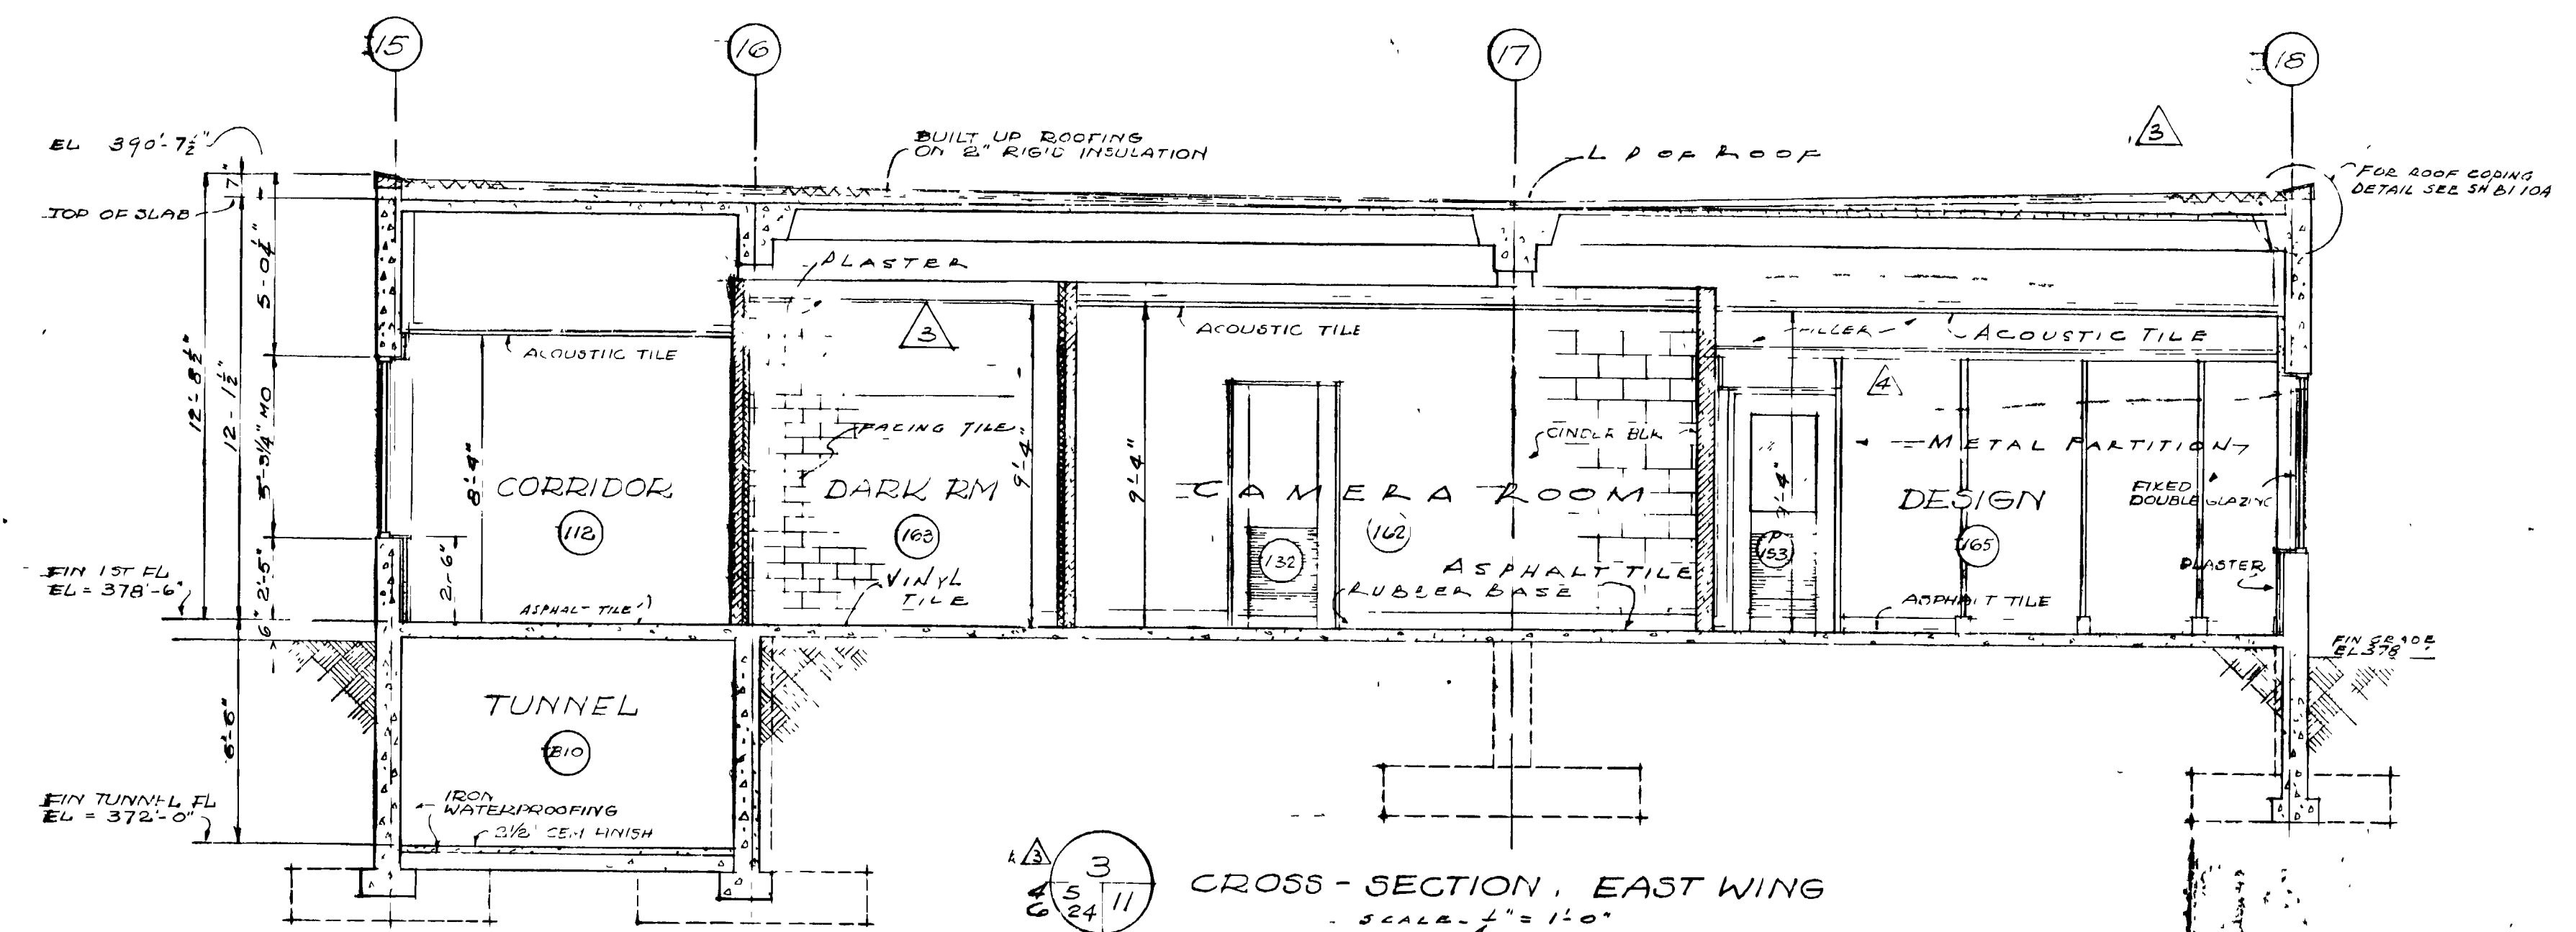


CROSS-SECTION, EAST WING SCALE 1/4" = 1'-0"

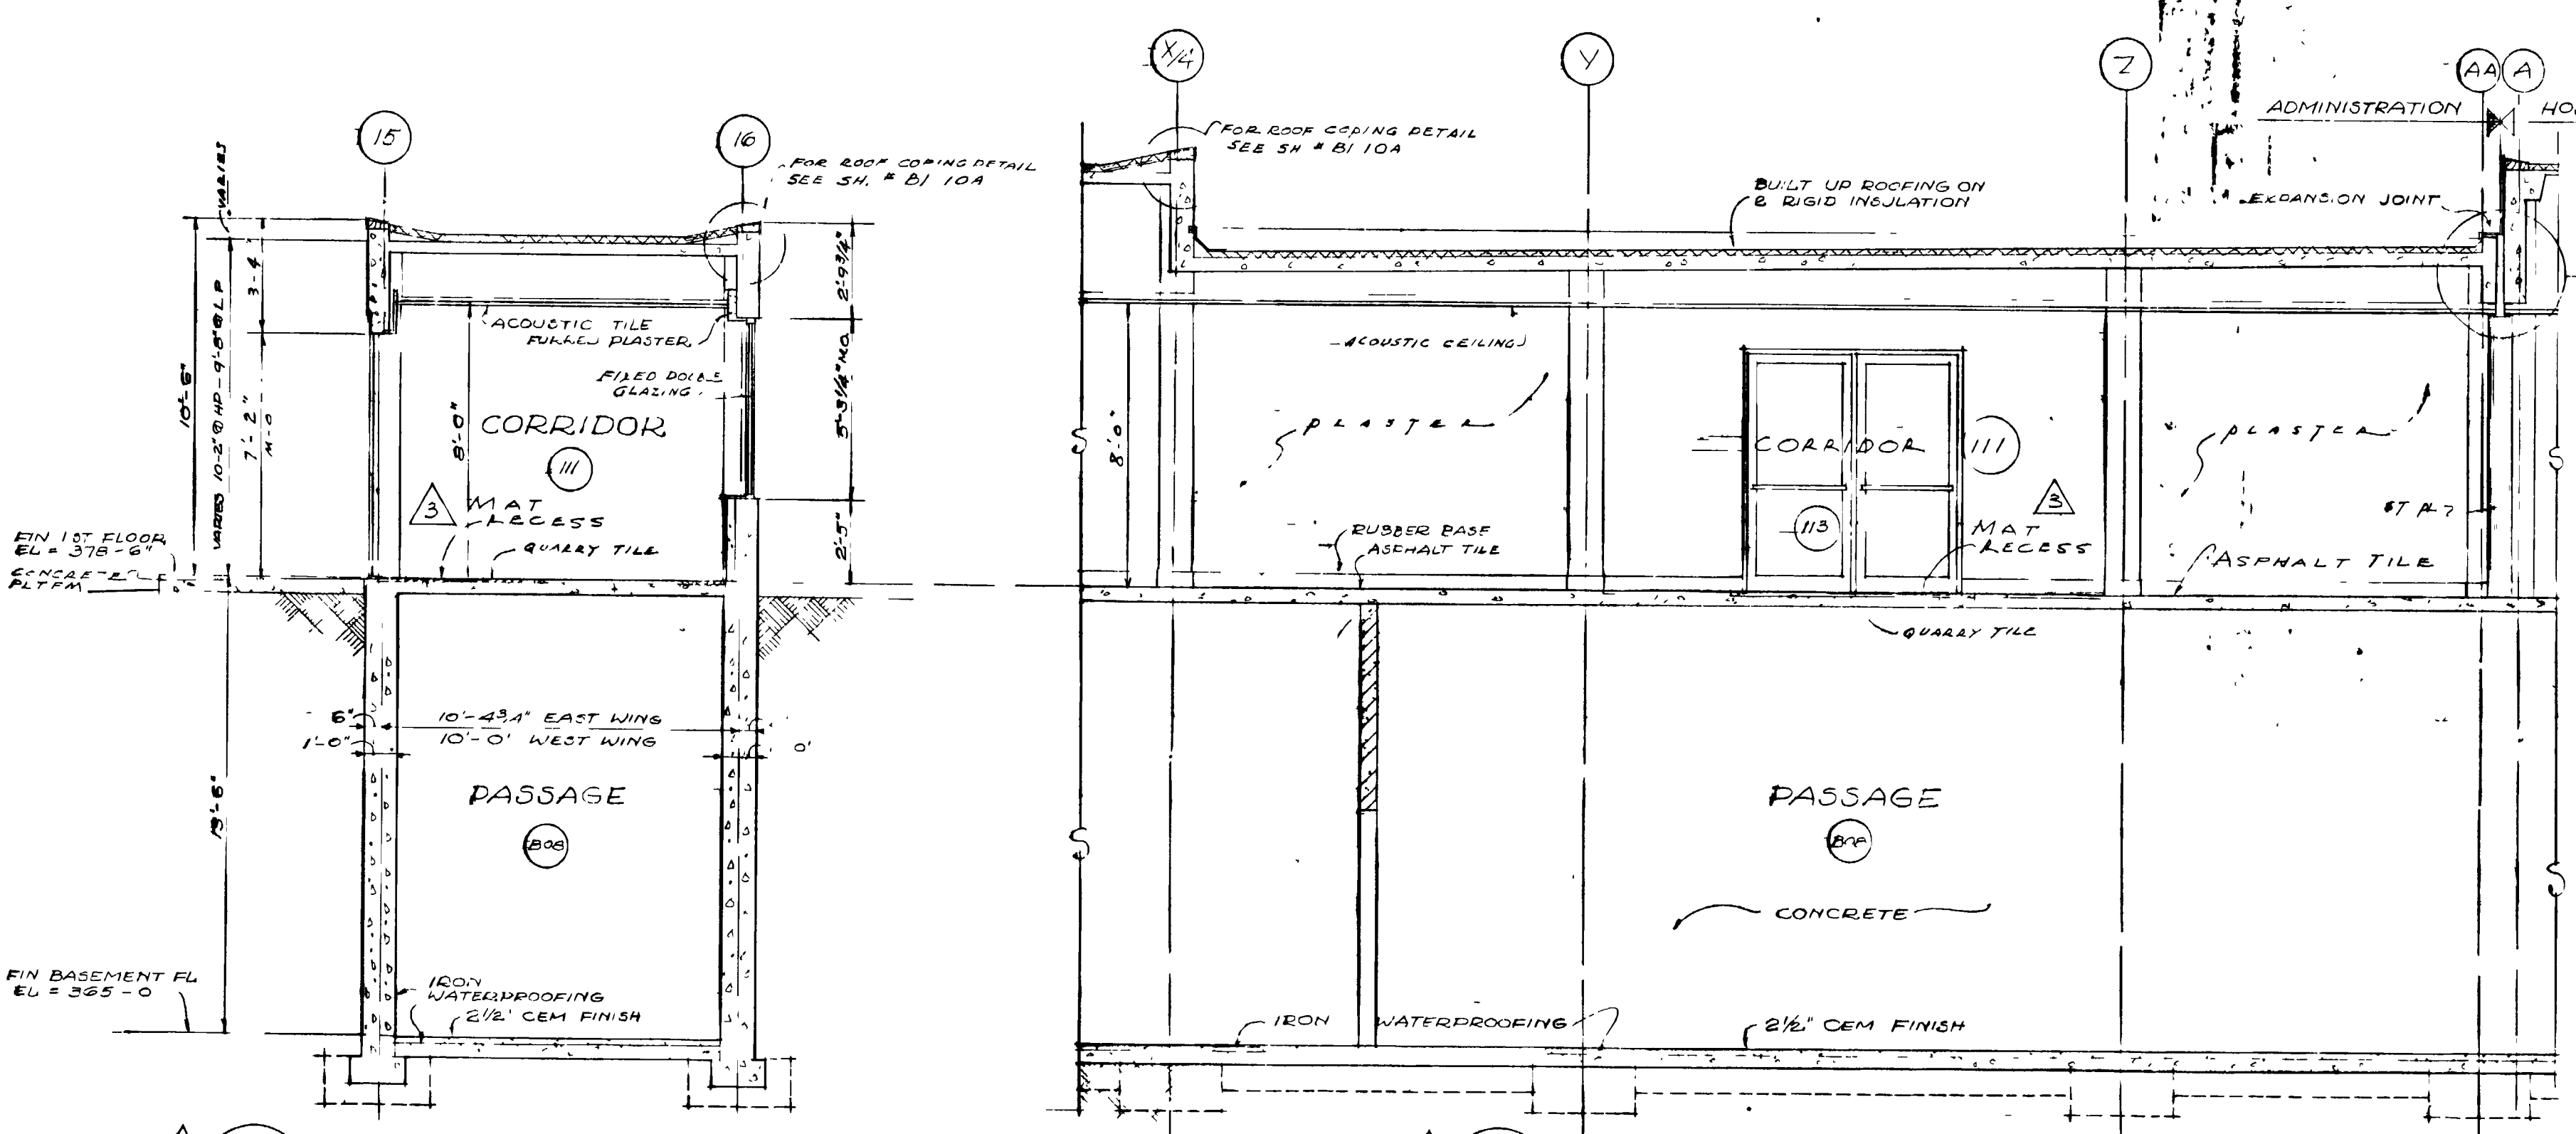

CROSS-SECTION THRU CONNECTING CORRIDORS SCALE 1/4" = 1'-0"

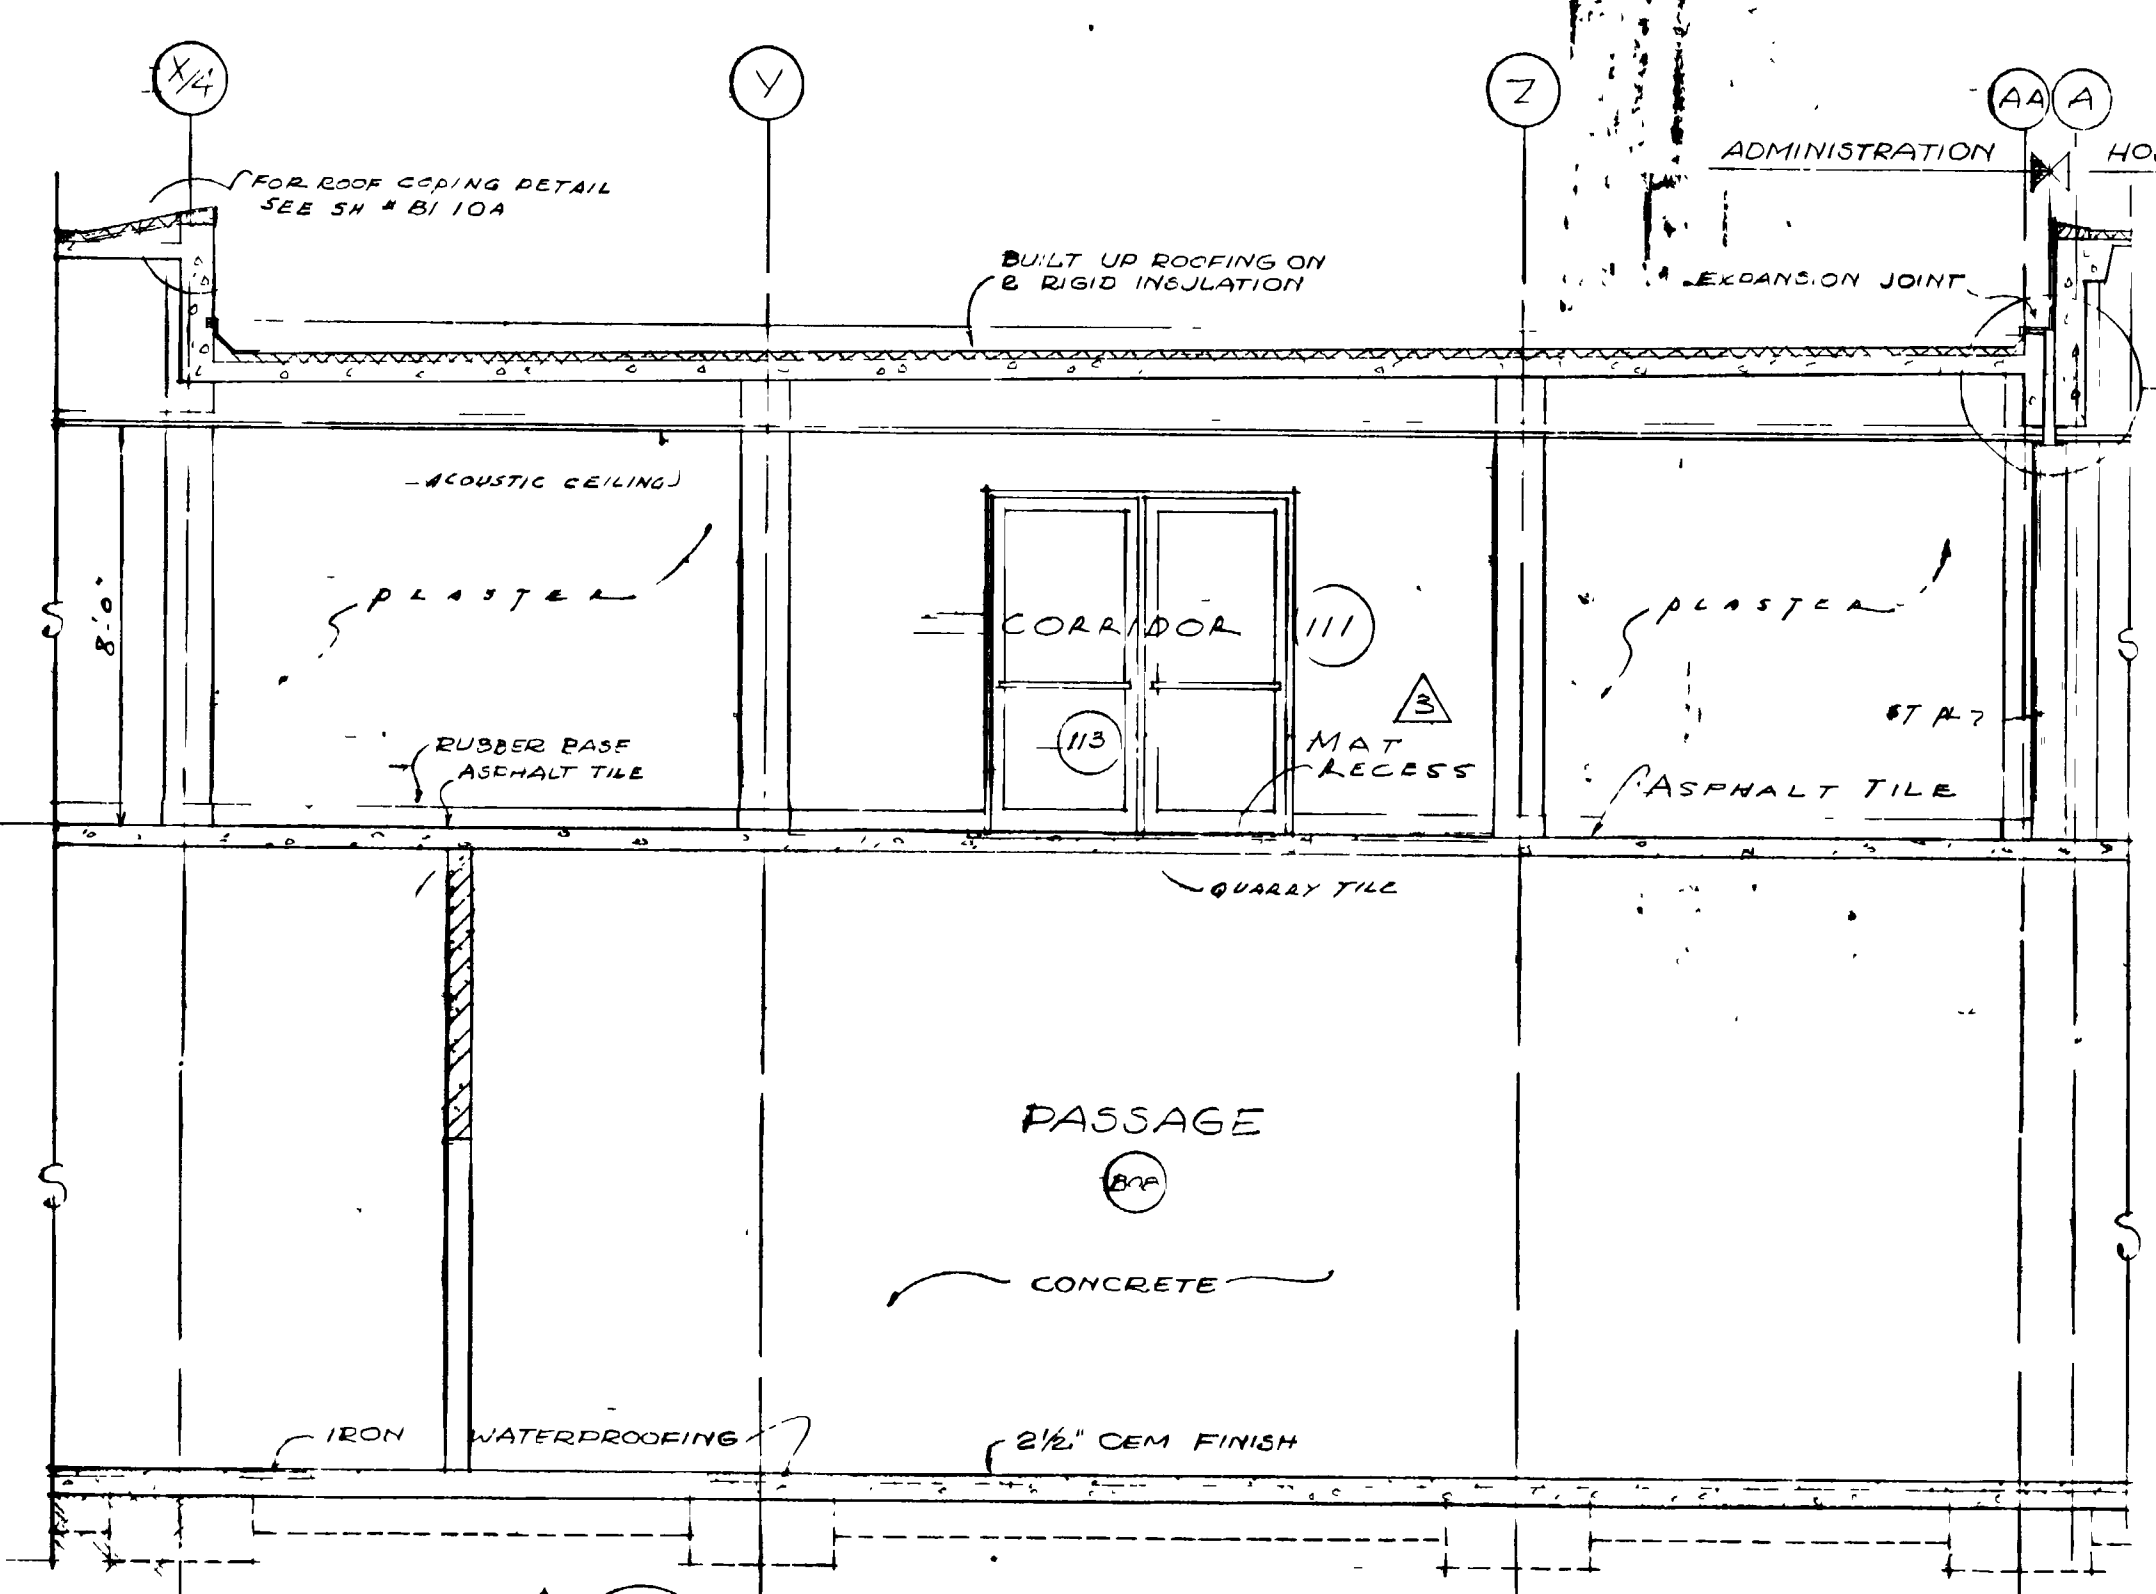

LONGITUDINAL SECTION THRU CONNECTING CORRIDOR SCALE 1/4" = 1'-0"

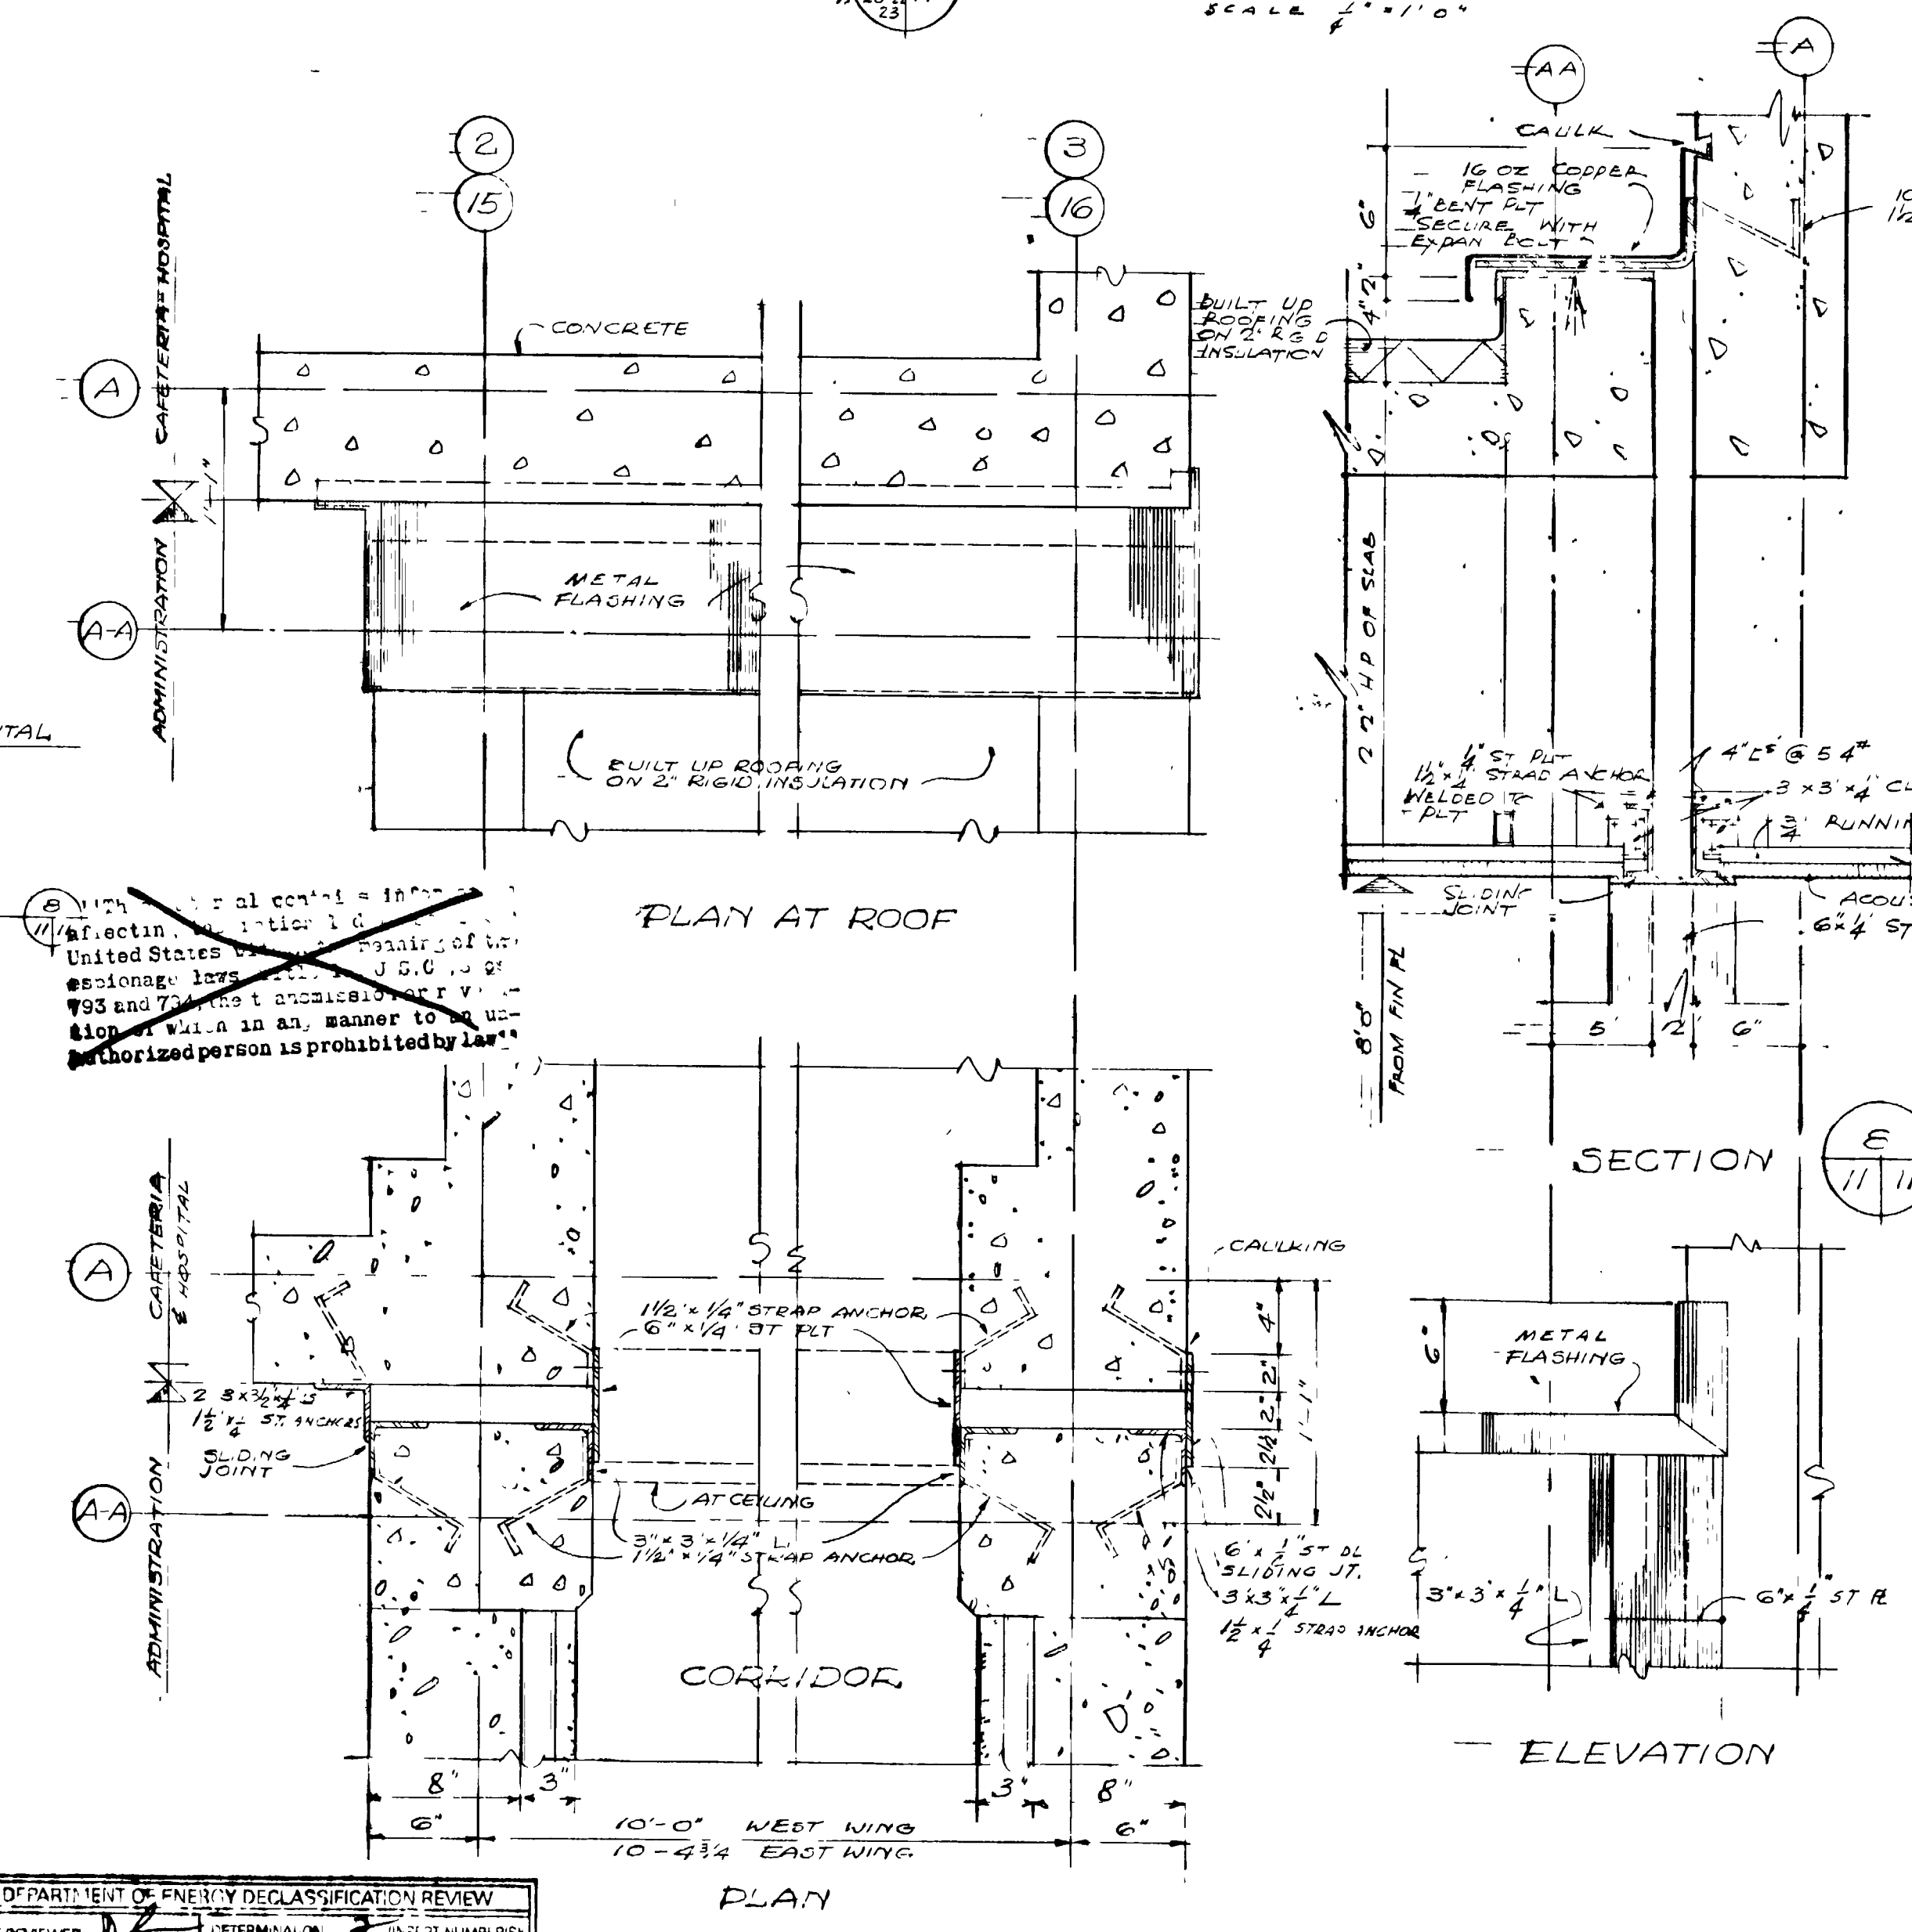

PLAN AT ROOF

SECTION

CORRIDOR

ELEVATION

EXPANSION JOINT DETAILS SCALE 1/2" = 1'-0"

REVIEWED FOR CLASSIFICATION KW 05/19/2014 Initials Date UNCLASSIFIED

BT Images, Inc. 00000536

CLASSIFICATION CHANGED TO Unclassified  
When Approved Change in Line and Column (Date)  
By Authority of DOE ITR P-7-77  
By Authority of DOE ITR P-2-2-98  
Worked by: [Signature] 1-2-58  
Marked Name, PGP

DEPARTMENT OF ENERGY DECLASSIFICATION REVIEW  
REVIEWER: [Signature]  
DATE: [Date]  
CLASSIFICATION: UNCLASSIFIED

REV NO	DATE	ISSUED FOR	BY	APP DATE
5	10/26/53	AS BUILT		6/10/26/53
4	5/2/52	REVISION REQUEST NO 359		
3	1/23/51	REVISION REQUEST NO 124		
2	1/23/51	CONSTRUCTION 26		9/1/51
1	3/16/51	ISSUED FOR "A" AND "C" APPROVAL		

UNITED STATES ATOMIC ENERGY COMMISSION	
SMITH, HINCHMAN & GRYLLS, INC. ARCHITECTS & ENGINEERS DETROIT 26, MICHIGAN	
DRAWING TITLE	
<b>SECTIONS &amp; DETAILS</b> SCALE 1/4" = 1'-0"	
DRAWING APPROVED DATE	DRAWING DESIGNED DATE
9/11/51	9/11/51
ARCHITECT ENGINEER	CHEMIST
DATE CHECKED	DATE
9/11/51	9/11/51
IN CHARGE	DATE
DATE	DATE
9/11/51	9/11/51
PROJECT	NO.
"C" PLANT	8768
ADMINISTRATION	BI-II-A
C-100	

MICROFILMED