
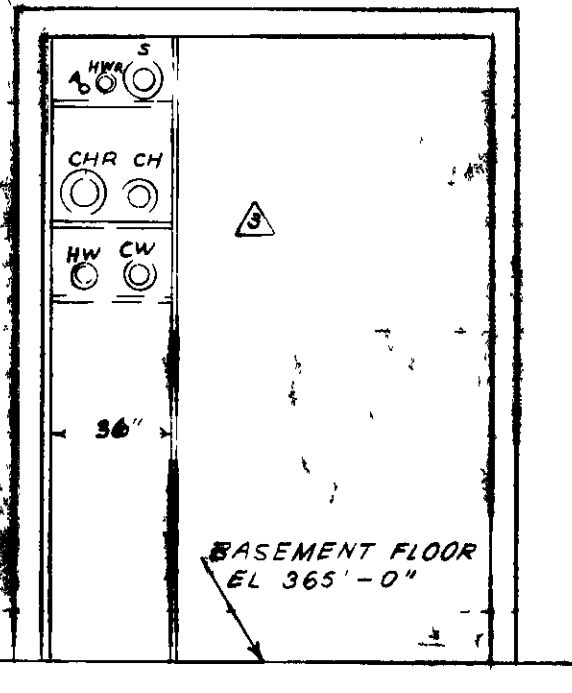
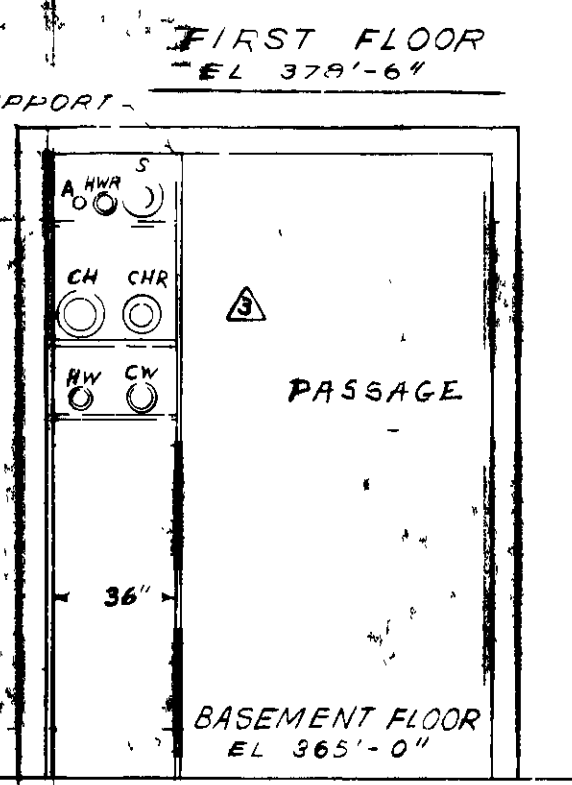
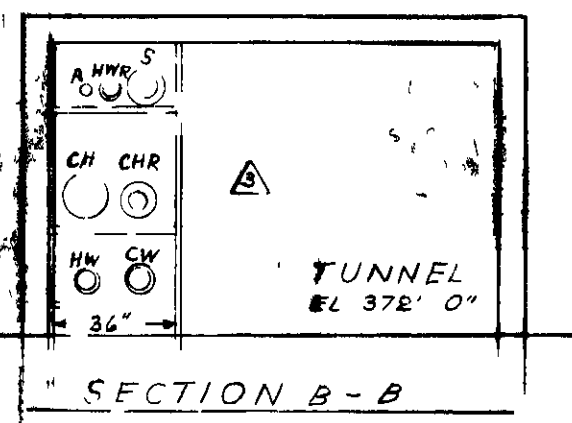


~~RESTRICTED~~
SECURITY INFORMATION

UNCLASSIFIED

Unclassified

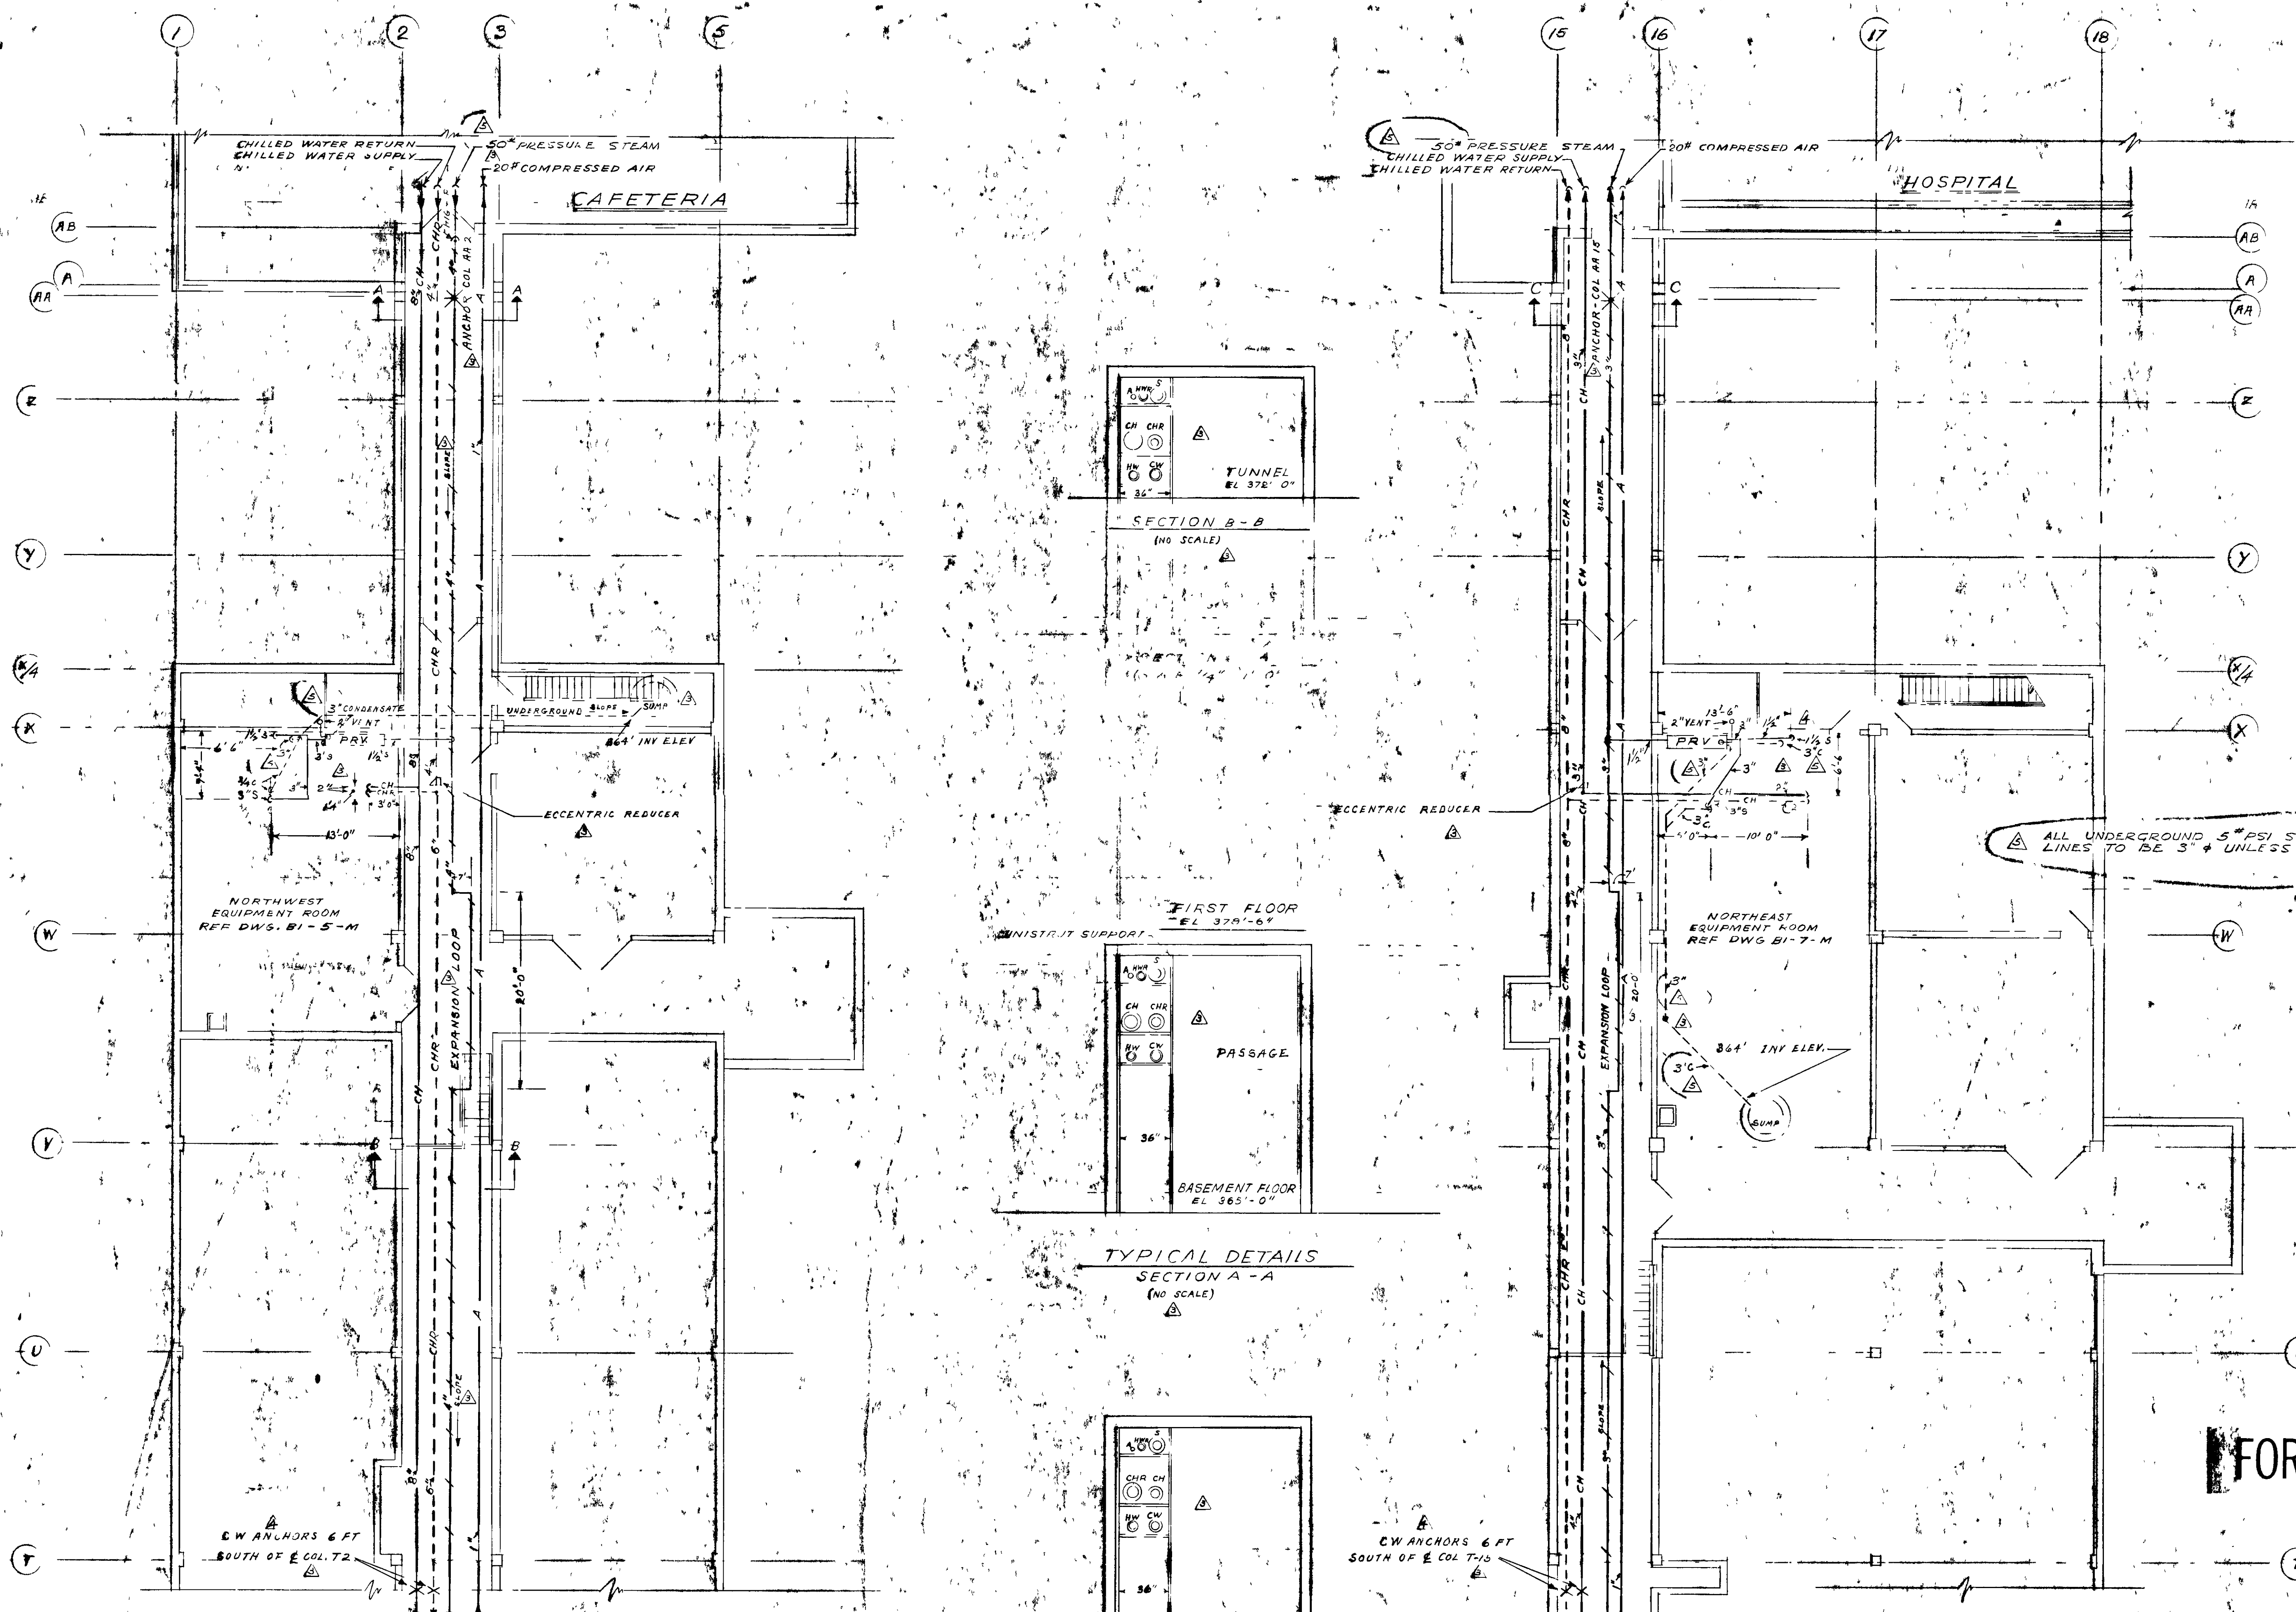

ALL UNDERGROUND 5 PSI STEAM CONDENSATE LINES TO BE 3" UNLESS NOTED

FOR INFORMATION ONLY

BF Images, Inc
00000603

WEST WING
(SCALE 1/8" = 1'-0")

EAST WING
(SCALE 1/8" = 1'-0")

REFERENCE DRAWINGS

- B1-5 NORTHWEST EQUIPMENT ROOM
- B1-7 NORTHEAST EQUIPMENT ROOM
- B1-16 CHILLED WATER PIPING ISOMETRICS
- B1-17 STEAM CONNECTIONS ISOMETRICS
- B1-23 VENTILATING SYSTEMS EAST & WEST WING
- B1-25 PIPING LAYOUT - ANCHORS & SUPPORTS
- B1-28 PRESSURE REDUCING STATIONS

REVIEWED FOR CLASSIFICATION
 RLH 05/22/2014
 Initials Date
 UNCLASSIFIED

DEPARTMENT OF ENERGY DECLASSIFICATION REVIEW

1. CLASSIFICATION RETAINED
 2. UNCLASSIFIED
 3. CONTAINS NO DOE CLASSIFIED INFORMATION
 4. CONTAINS NO NUCLEAR INFORMATION
 5. CLASSIFIED INFORMATION IS IDENTIFIED AND IS BEING REVIEWED BY THE DEPARTMENT OF ENERGY
 6. CLASSIFIED INFORMATION IS IDENTIFIED AND IS BEING REVIEWED BY THE DEPARTMENT OF ENERGY
 7. OTHER (PLEASE SPECIFY)

CLASSIFICATION CHANGED TO **Unclassified**

By: *[Signature]* Date: *2-2-20*

~~RESTRICTED~~
SECURITY INFORMATION

6	1/16/53	AS BUILT		GD/11/16/53
5	2/26/52	REVISION REQUEST NO 458	DR	
4	12/31/51	REVISION REQUEST NO 184	AW	
3	12/6/51	REVISION REQUEST NOS 101 & 102	AW	
2	11/9/51	CONSTRUCTION	AW	11-8-51
1	10/31/51	APPROVAL	H-C	11-8-51

REV NO DATE ISSUED FOR BY APP DATE

UNITED STATES
ATOMIC ENERGY COMMISSION

SMITH, HINCHMAN & GRYLLS, INC
ARCHITECTS & ENGINEERS
DETROIT 26, MICHIGAN

DRAWING TITLE
BASEMENT & TUNNELS - EAST & WEST WING

DRAWING APPROVED (DATE)	DRAWING APPROVED (DATE)	DRAWING APPROVED (DATE)
<i>[Signature]</i> 10-31-51	R A WALKER 11-8-51	R J BROWN 11-8-51
ARCHITECT EN (NAME)	CHEMIST (NAME)	ENGINEER (NAME)
M F	W S	A J
DATE CHECKED	DATE	DATE
11-9-51	11-9-51	11-9-51

IN CHARGE: *[Signature]* DATE: *[Signature]* DATE: *[Signature]* 8768

PROJECT: C-PLANT ADMINISTRATION C-100 BUILDING: BI-II-M

Unclassified

UNCLASSIFIED

~~RESTRICTED~~
SECURITY INFORMATION