
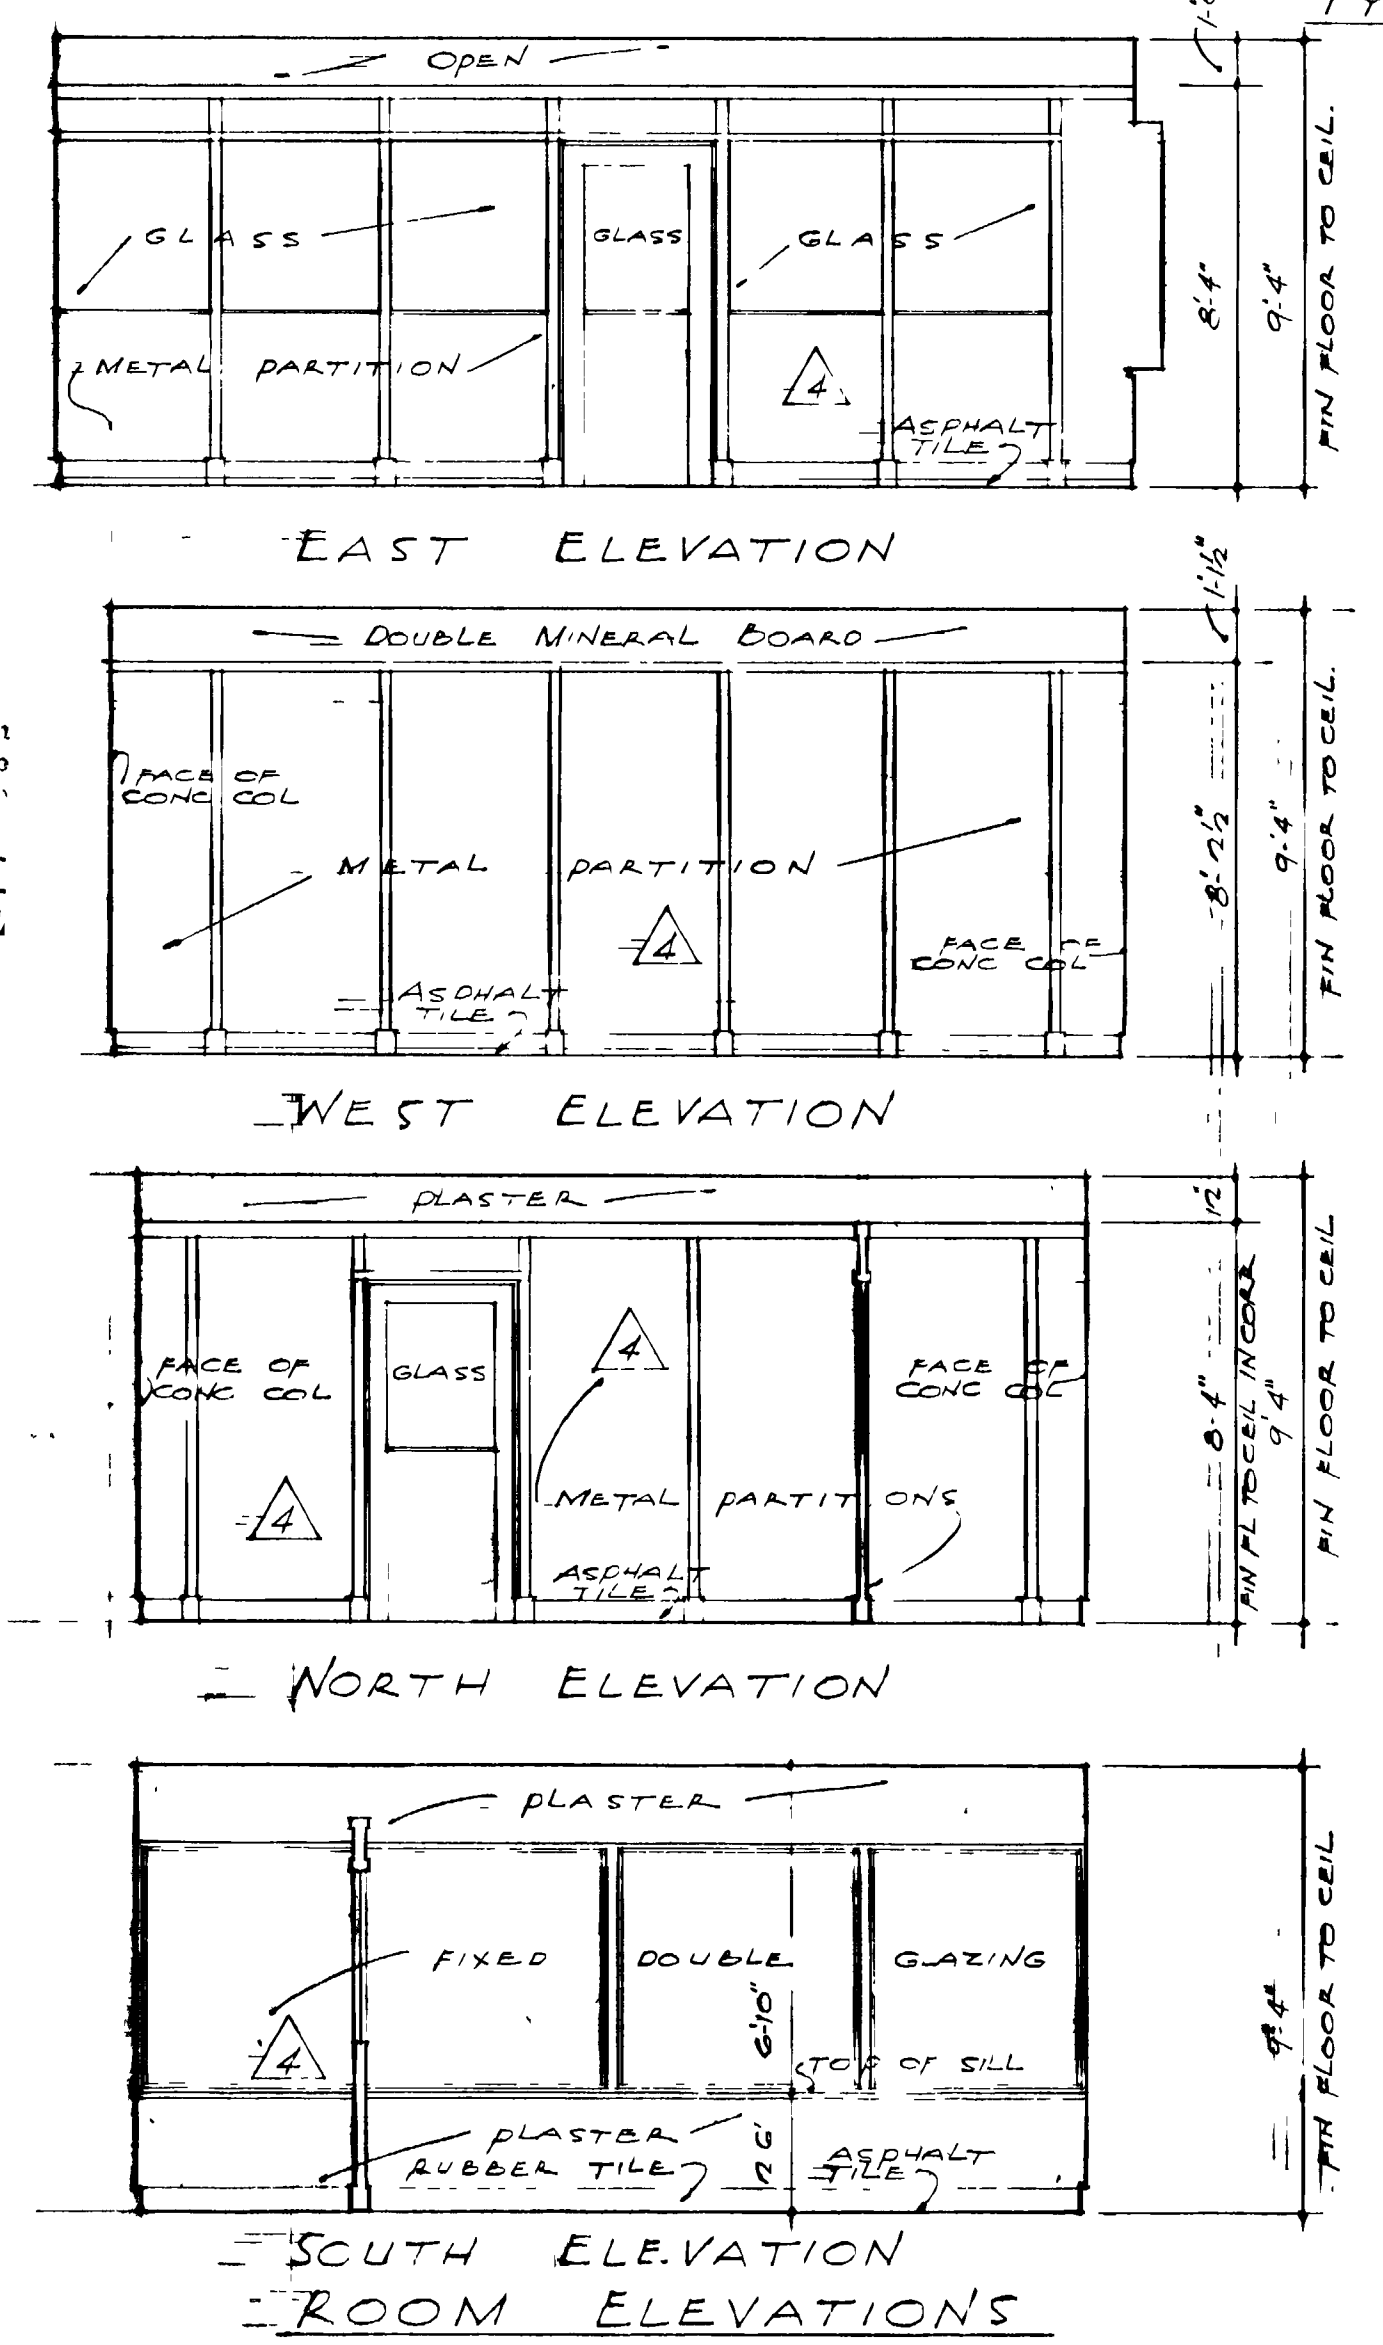
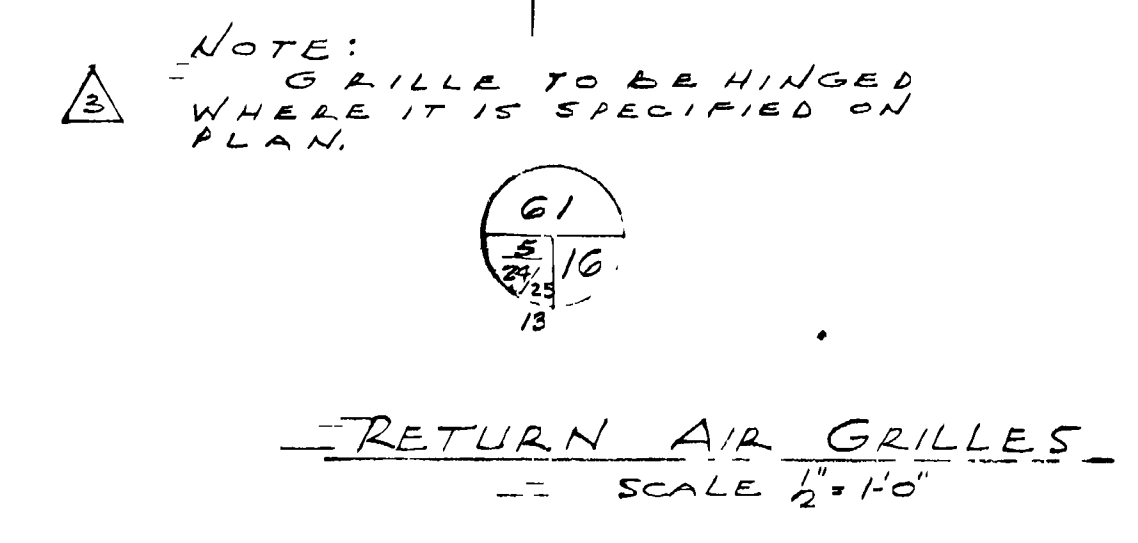
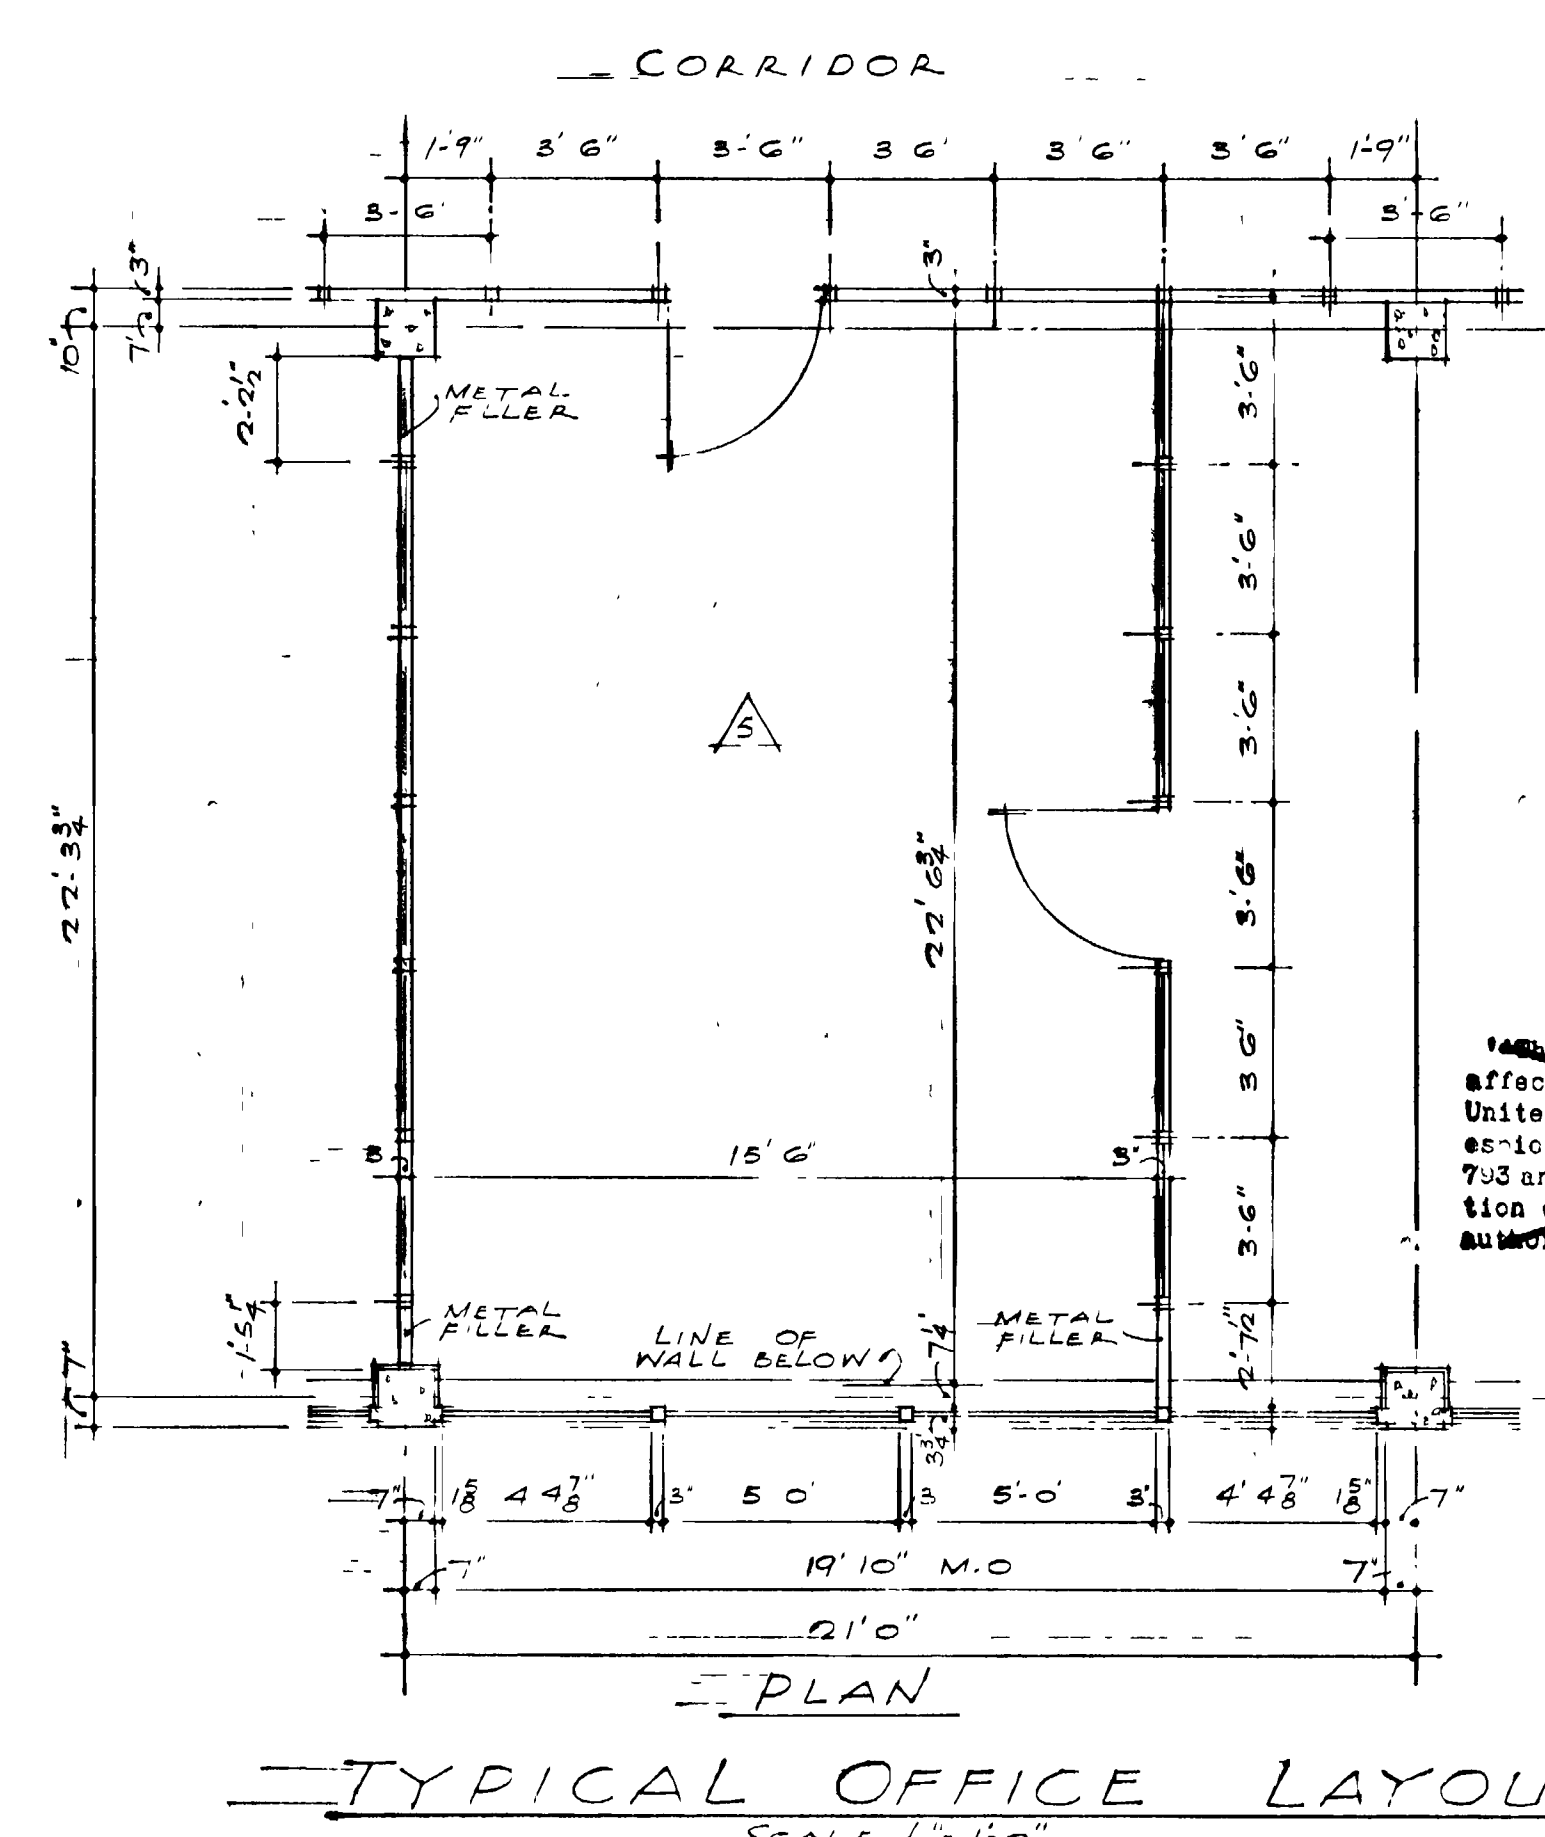
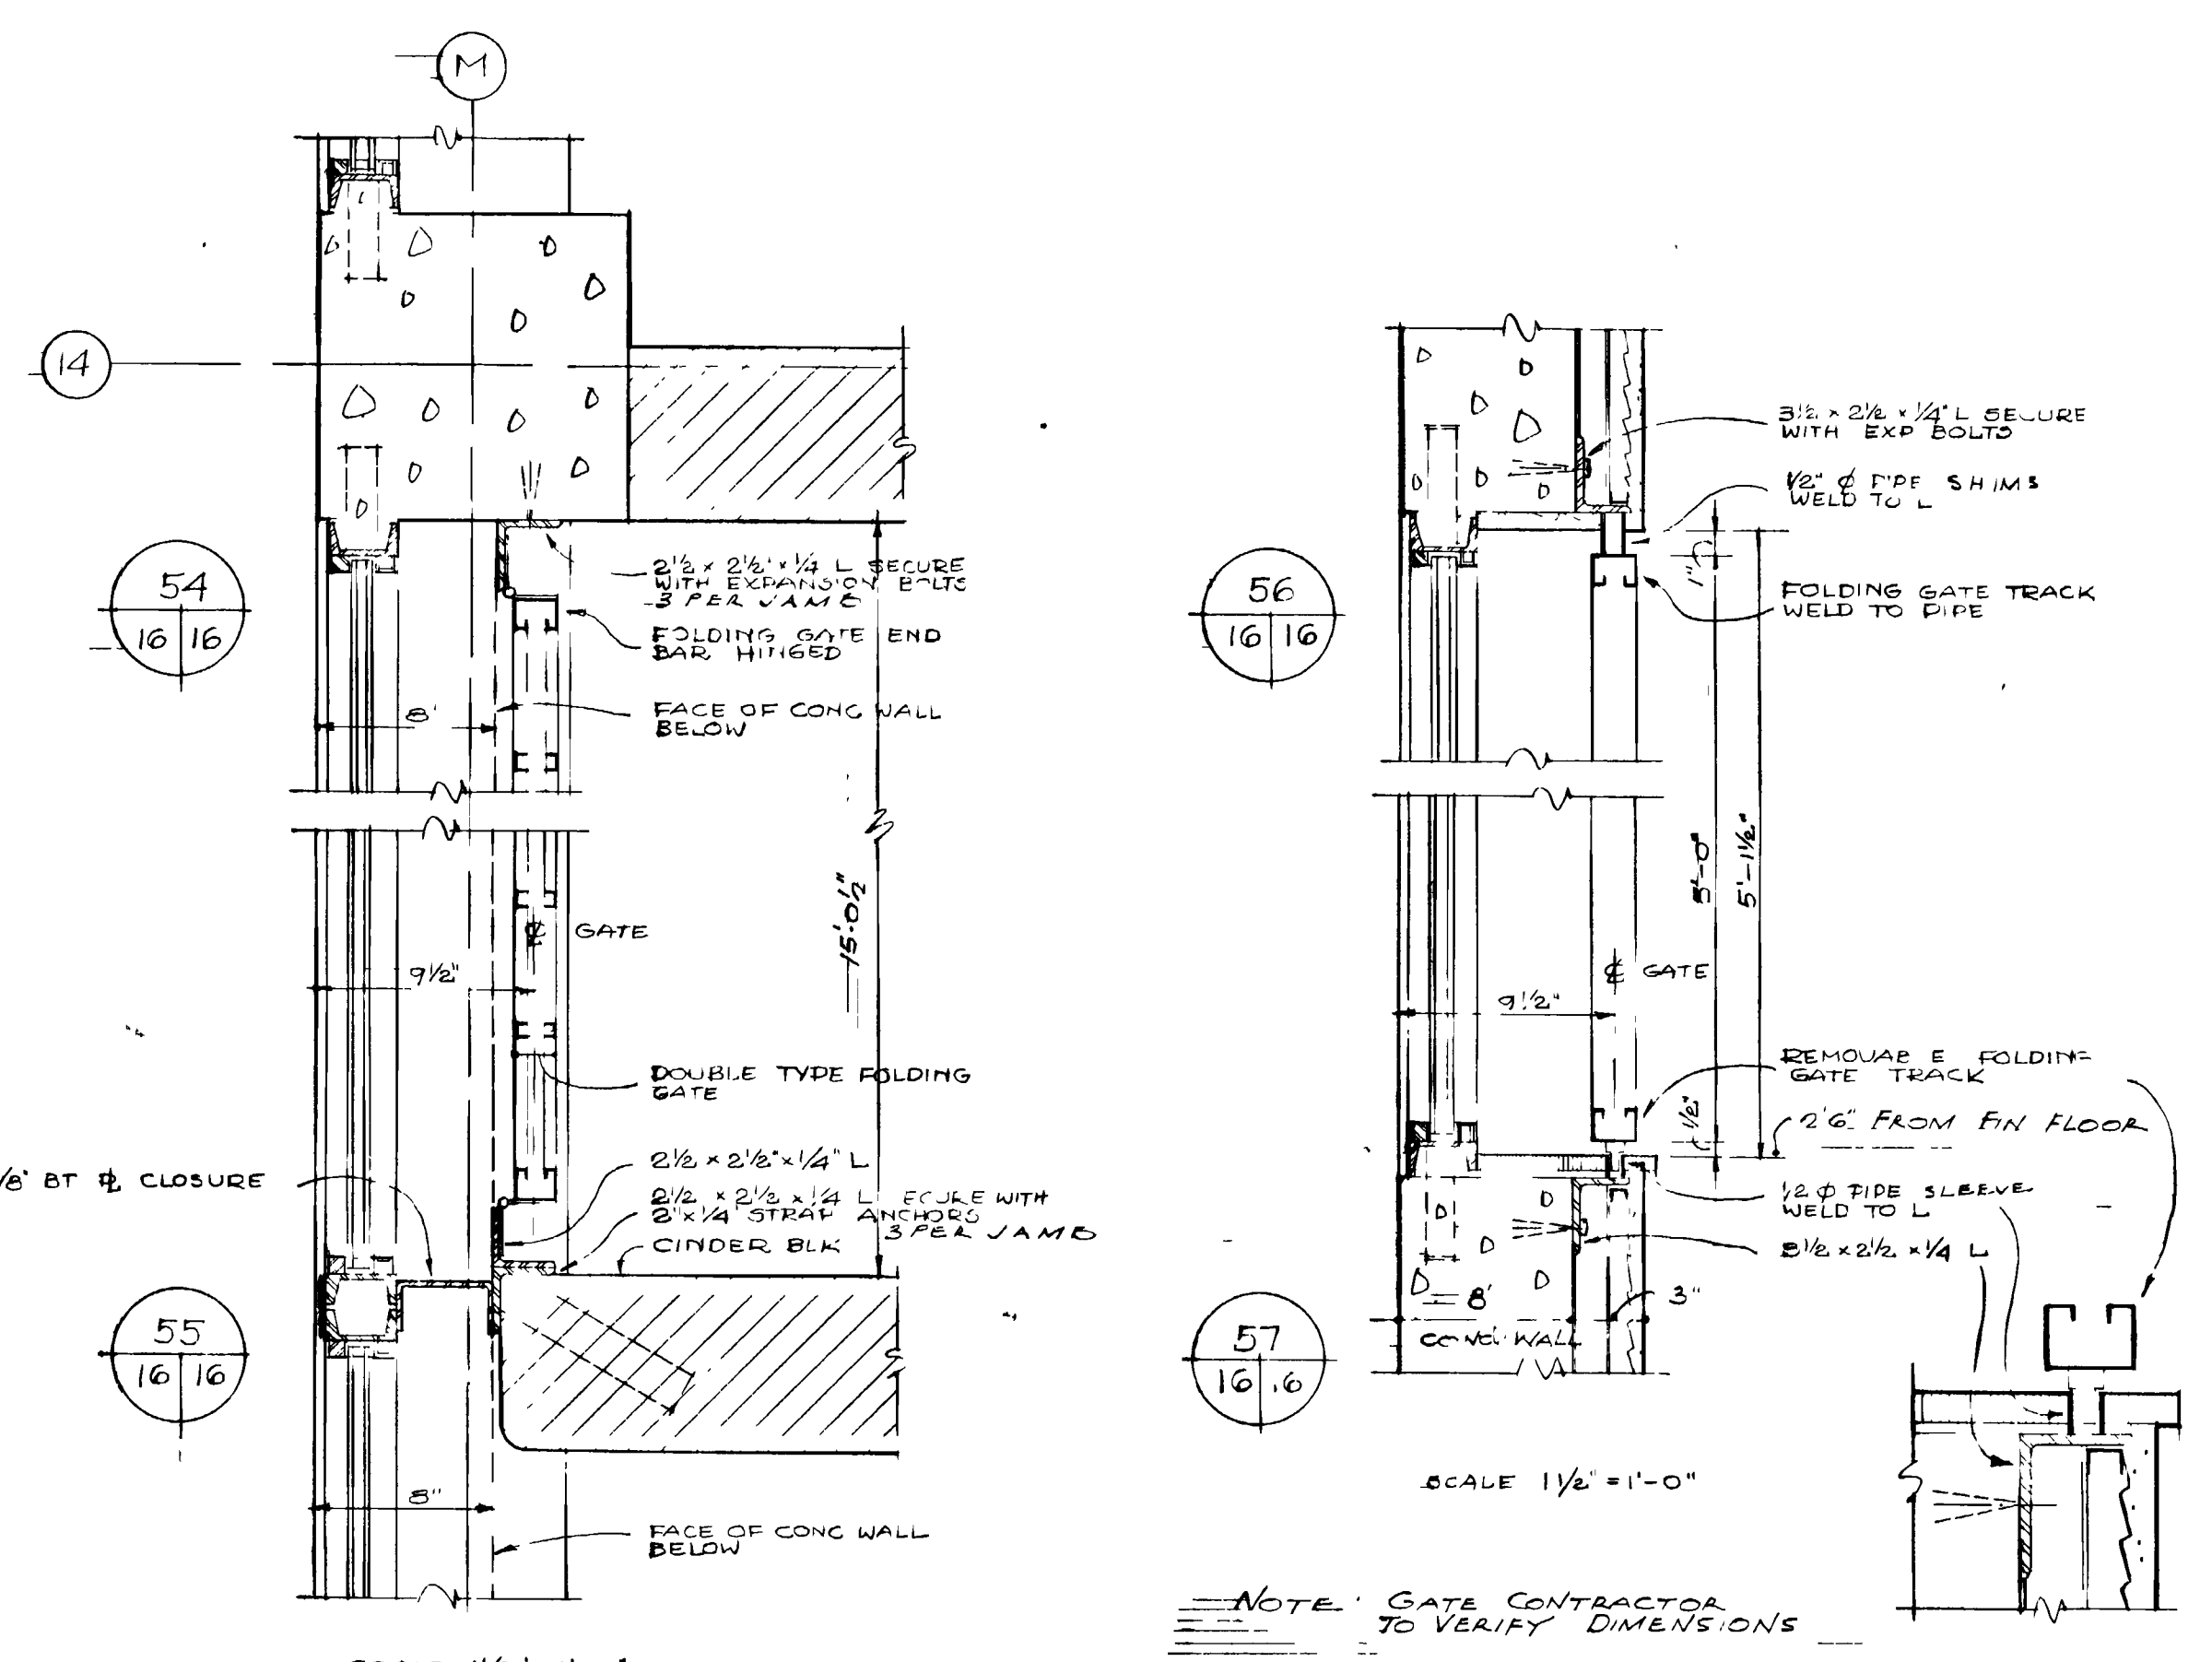
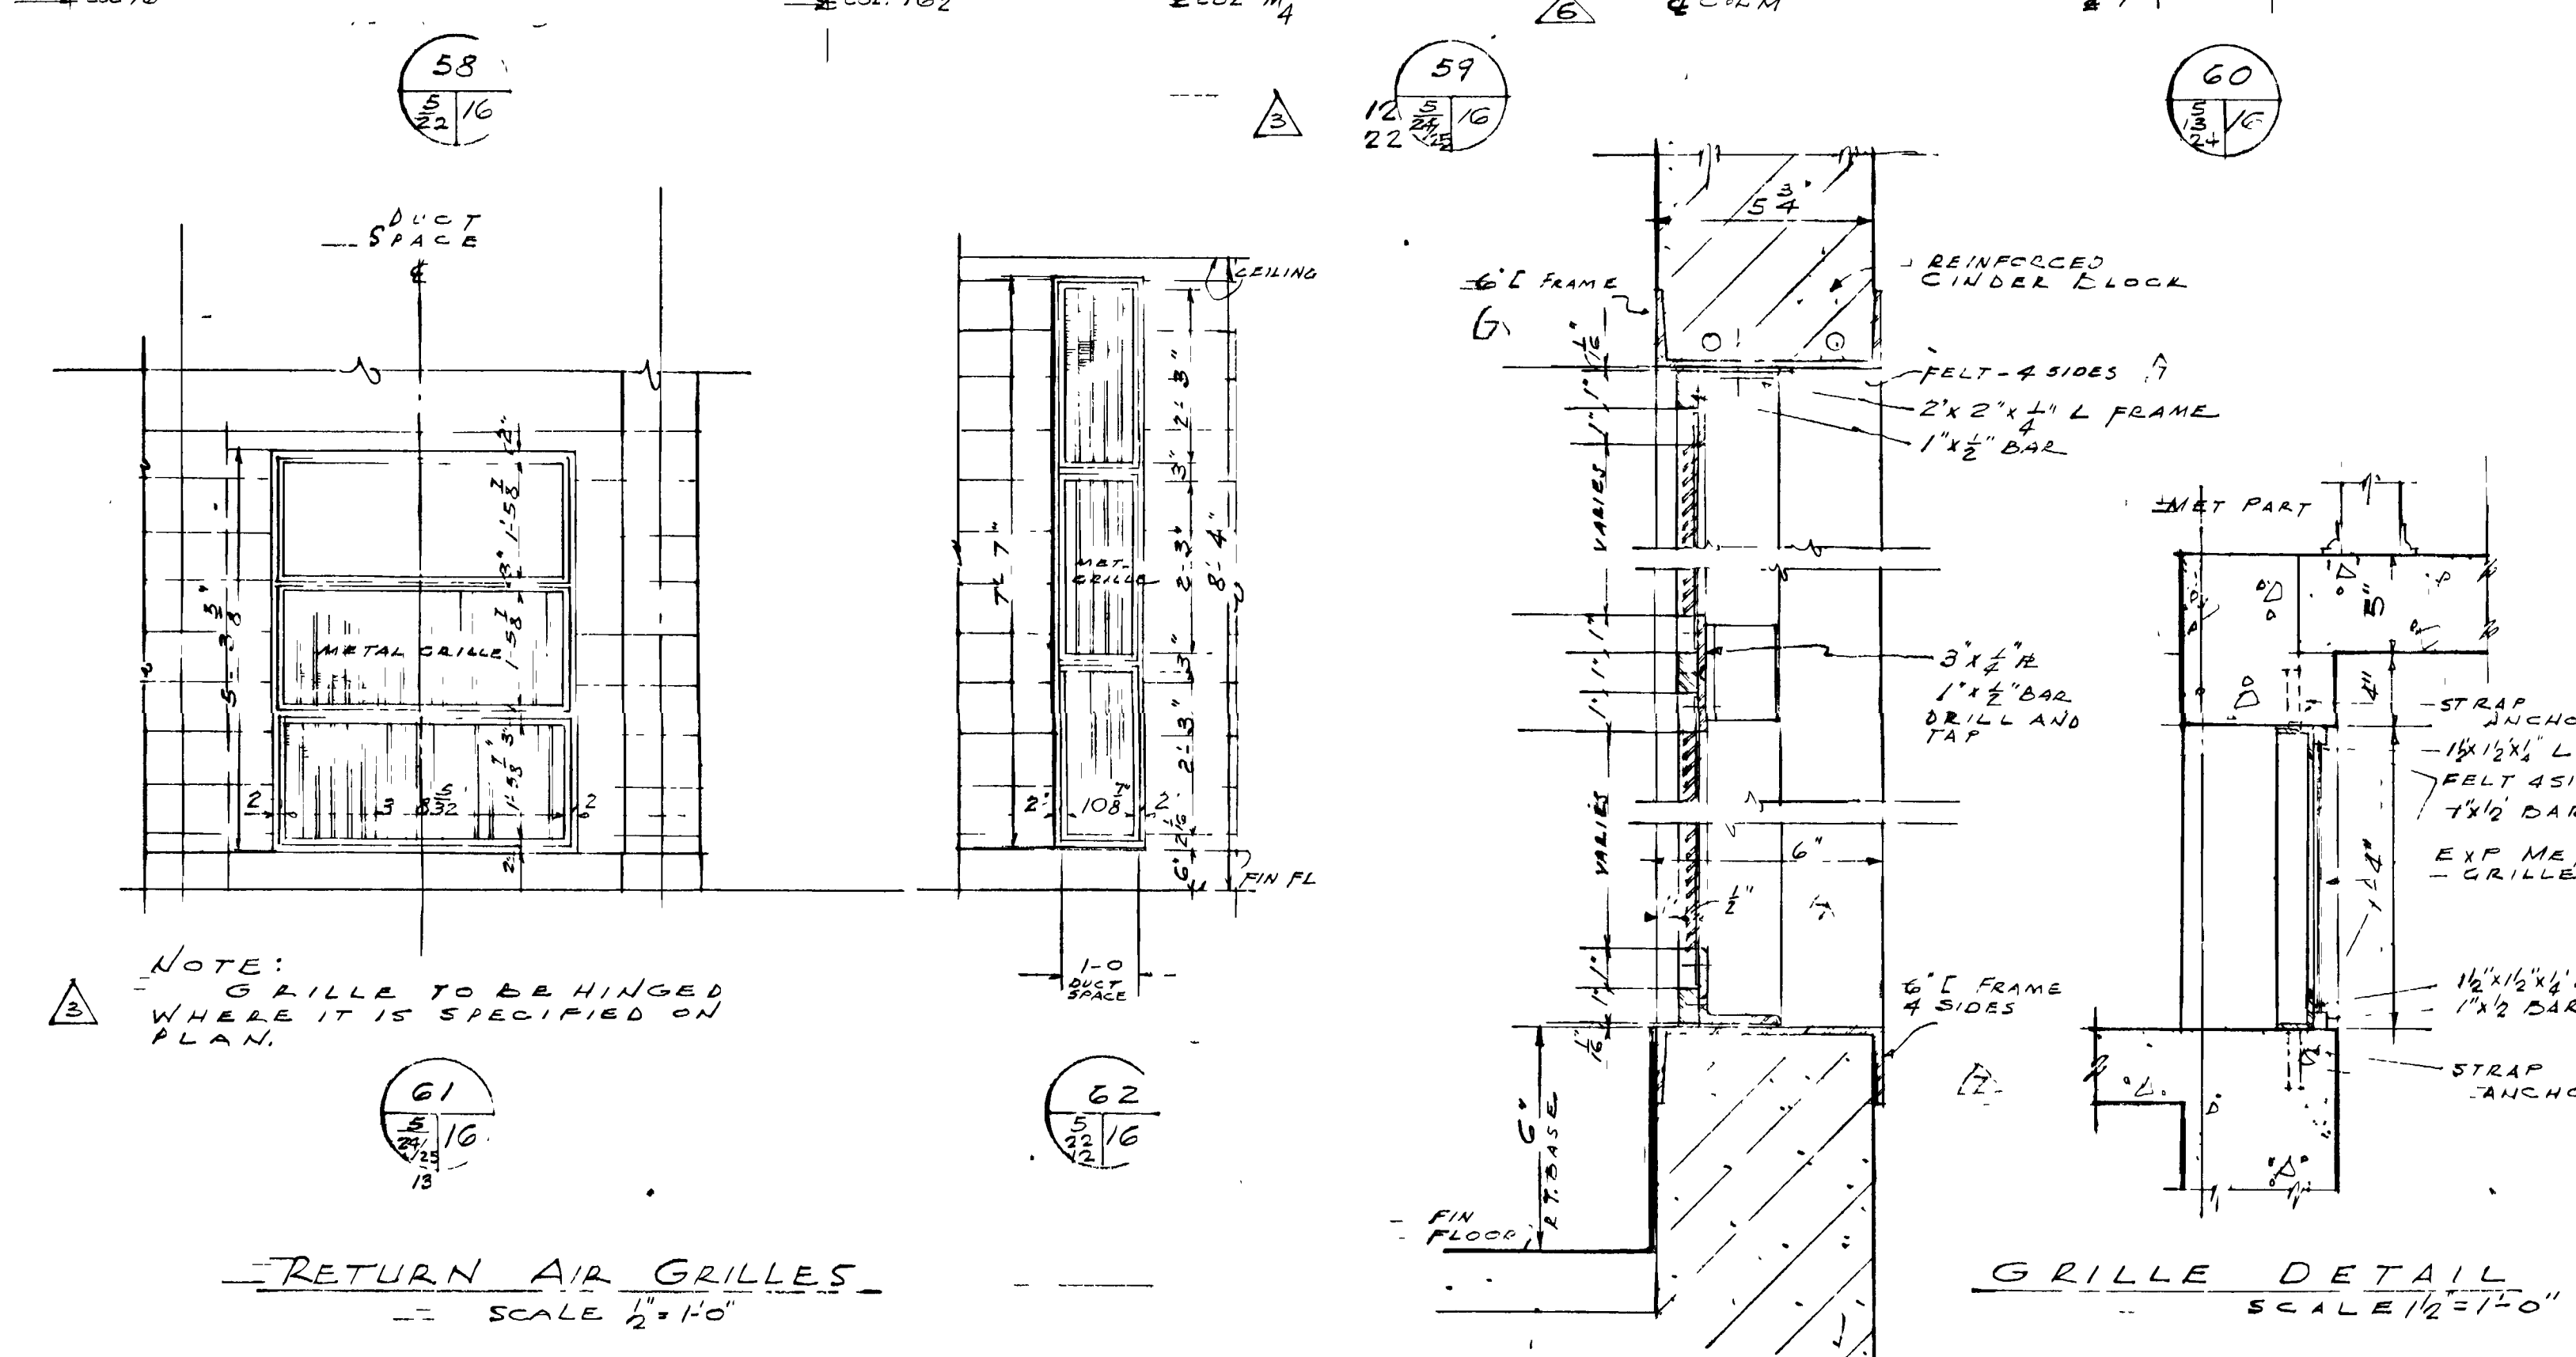
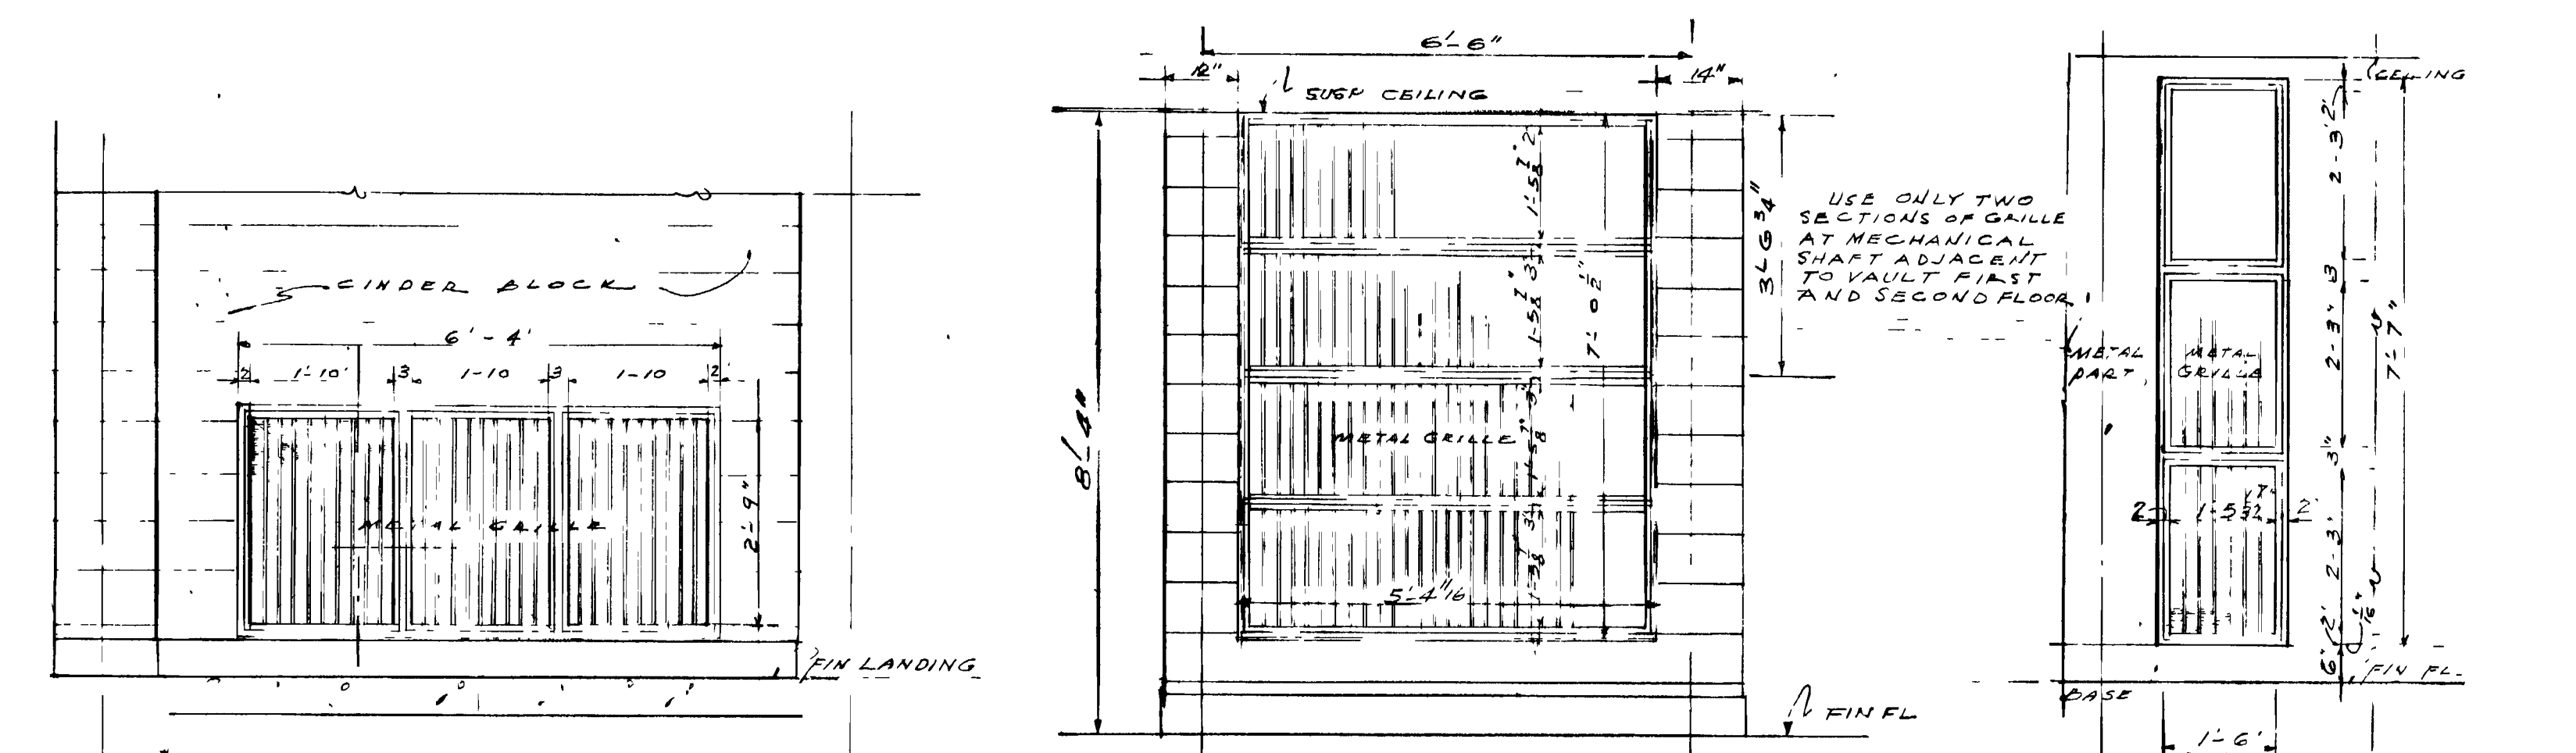
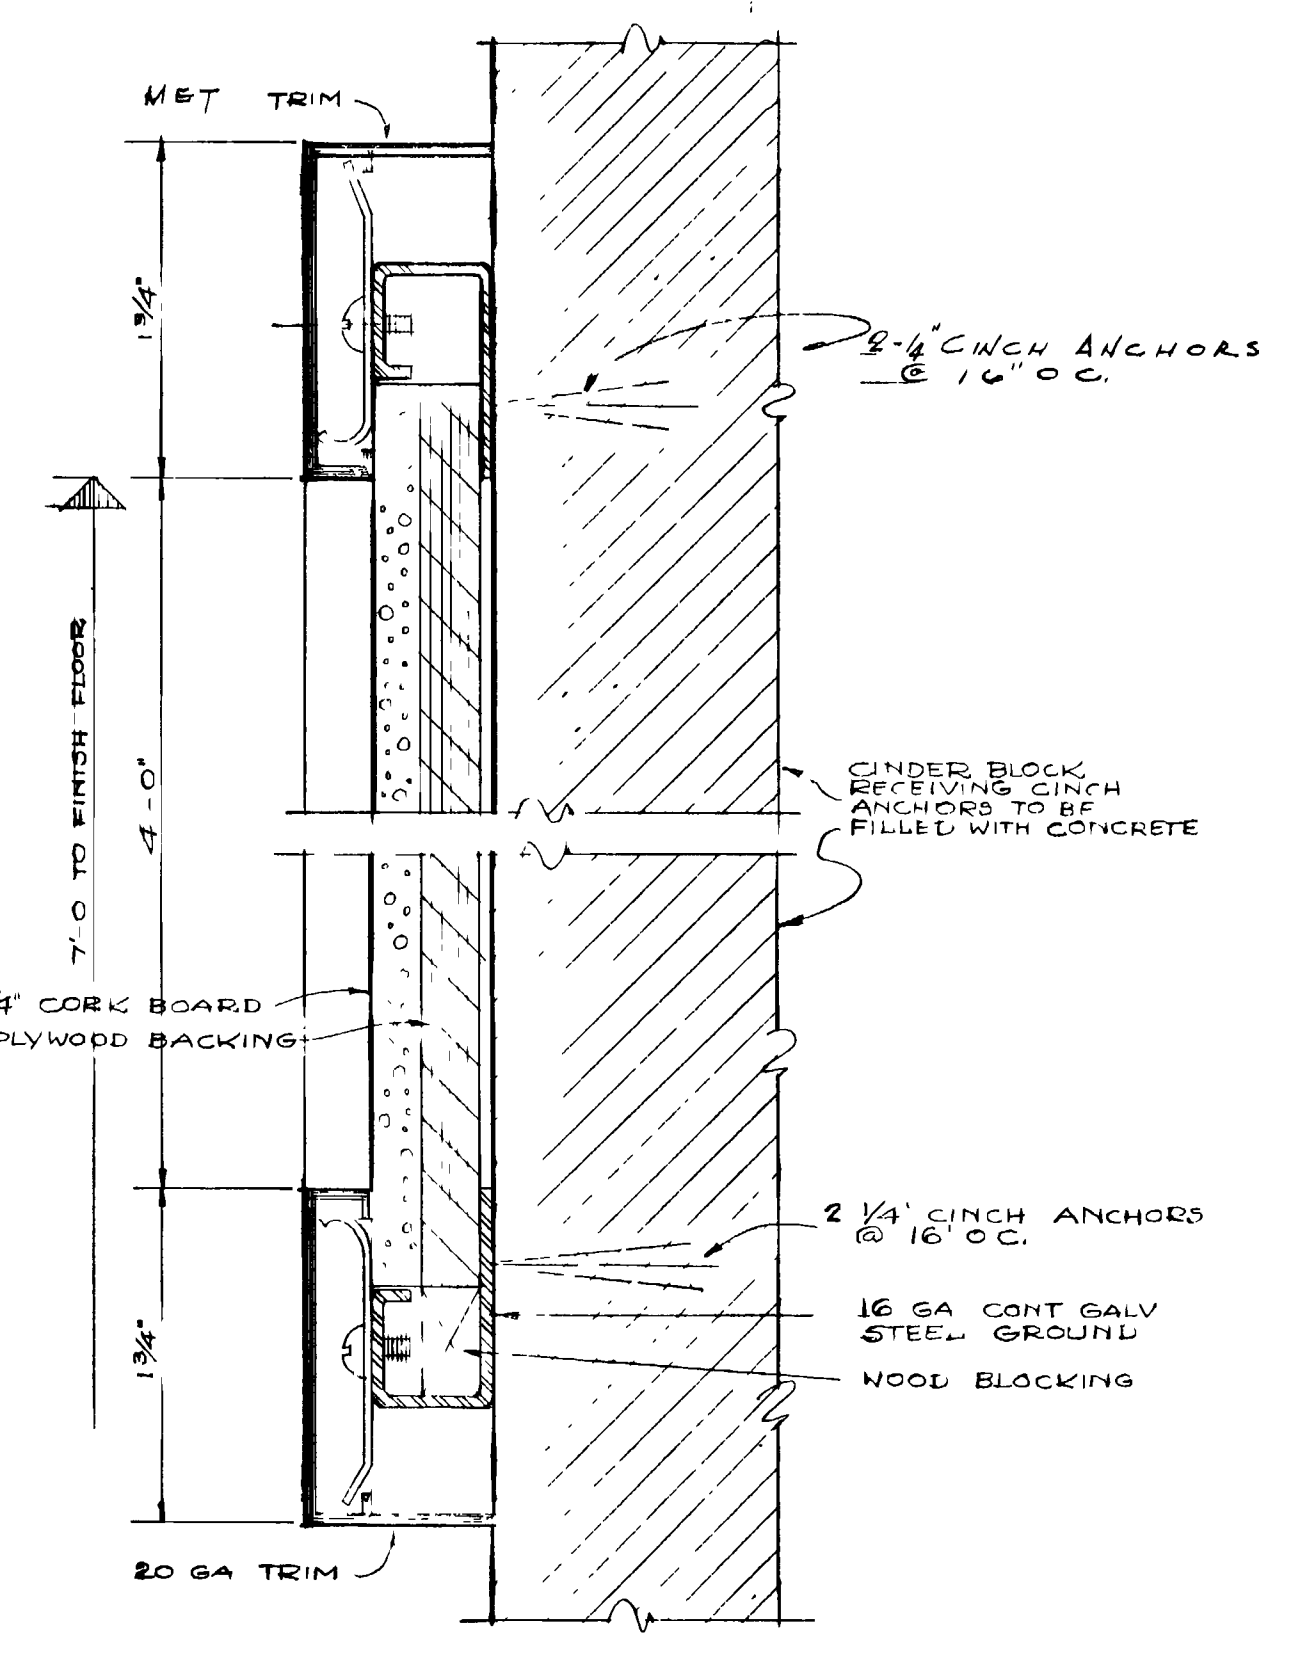
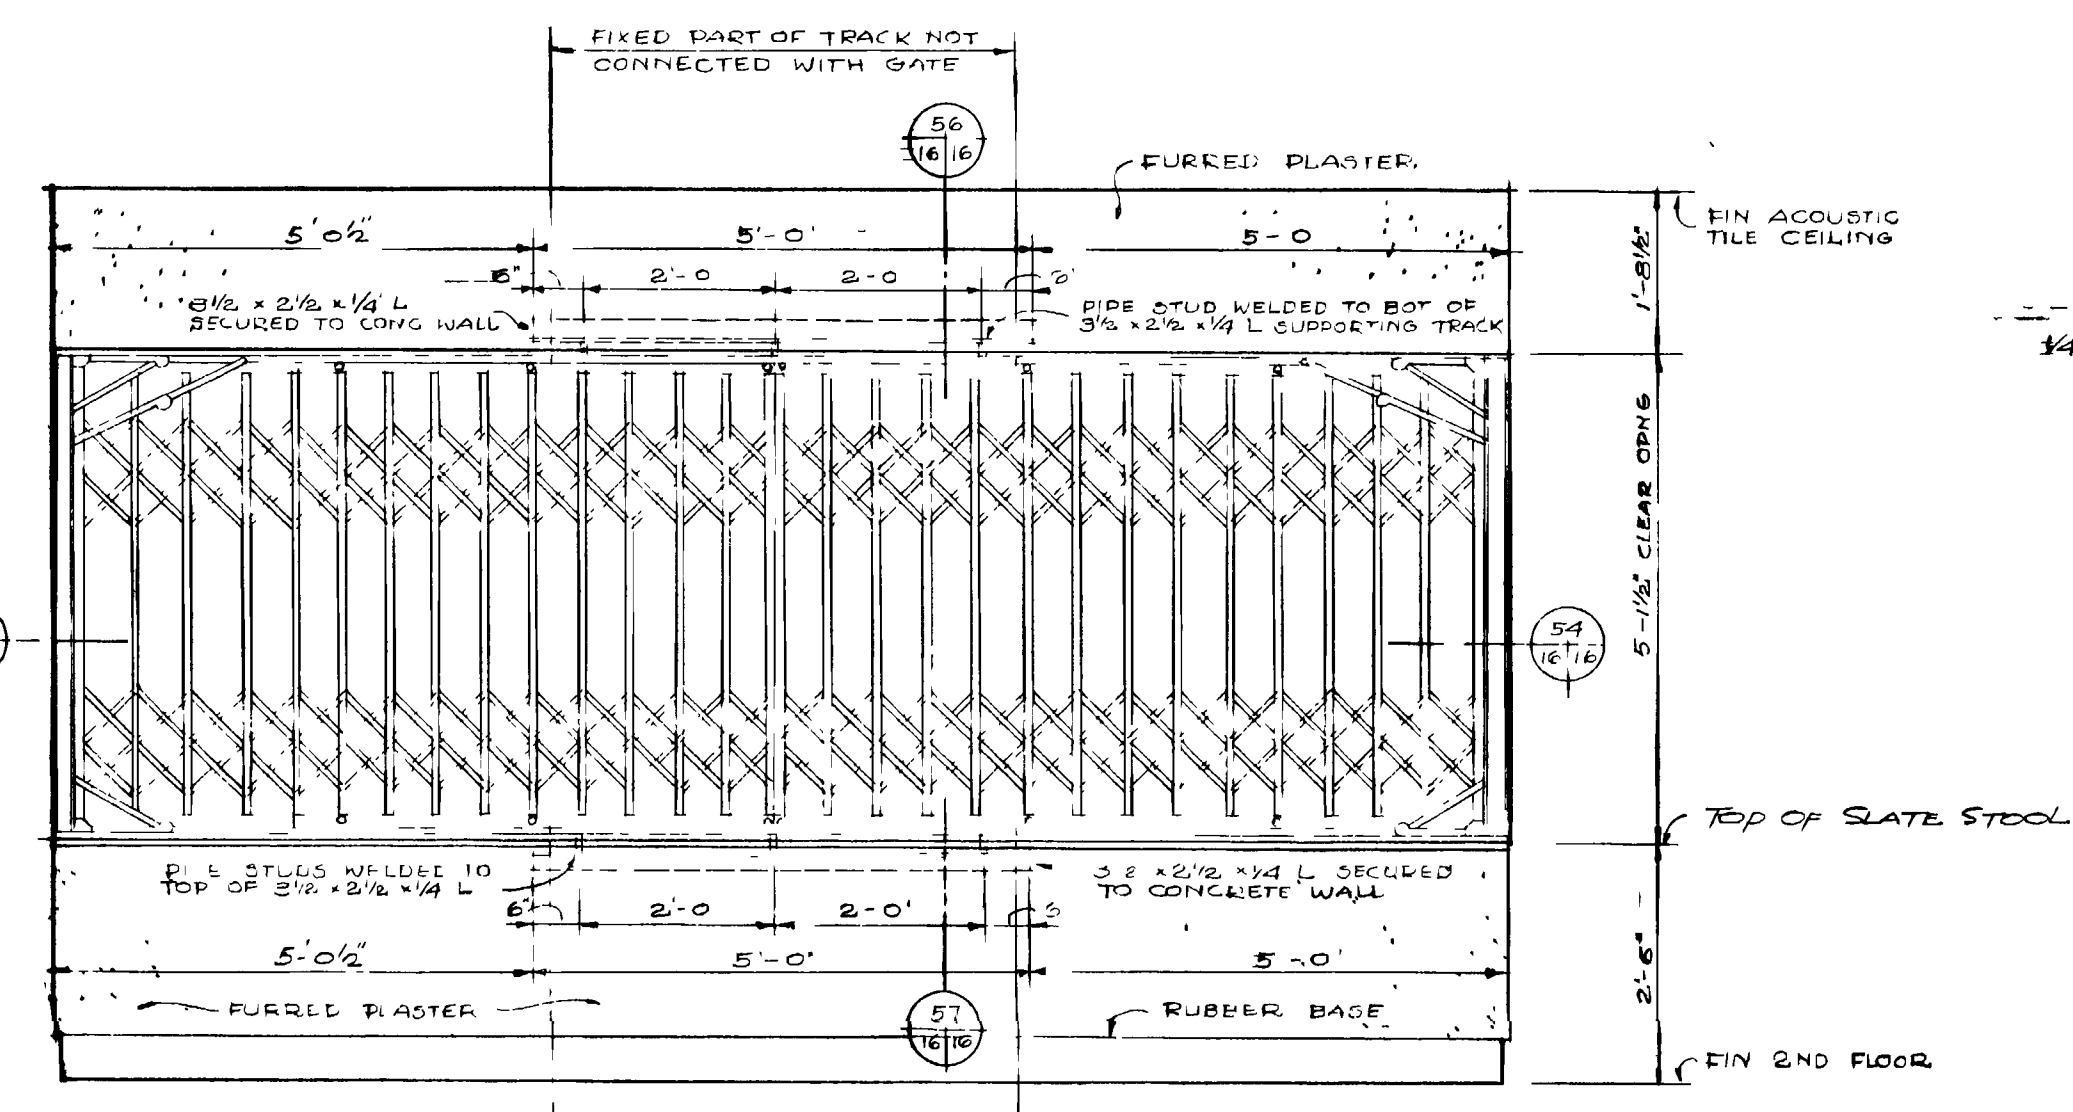


SECURITY INFORMATION

Unclassified

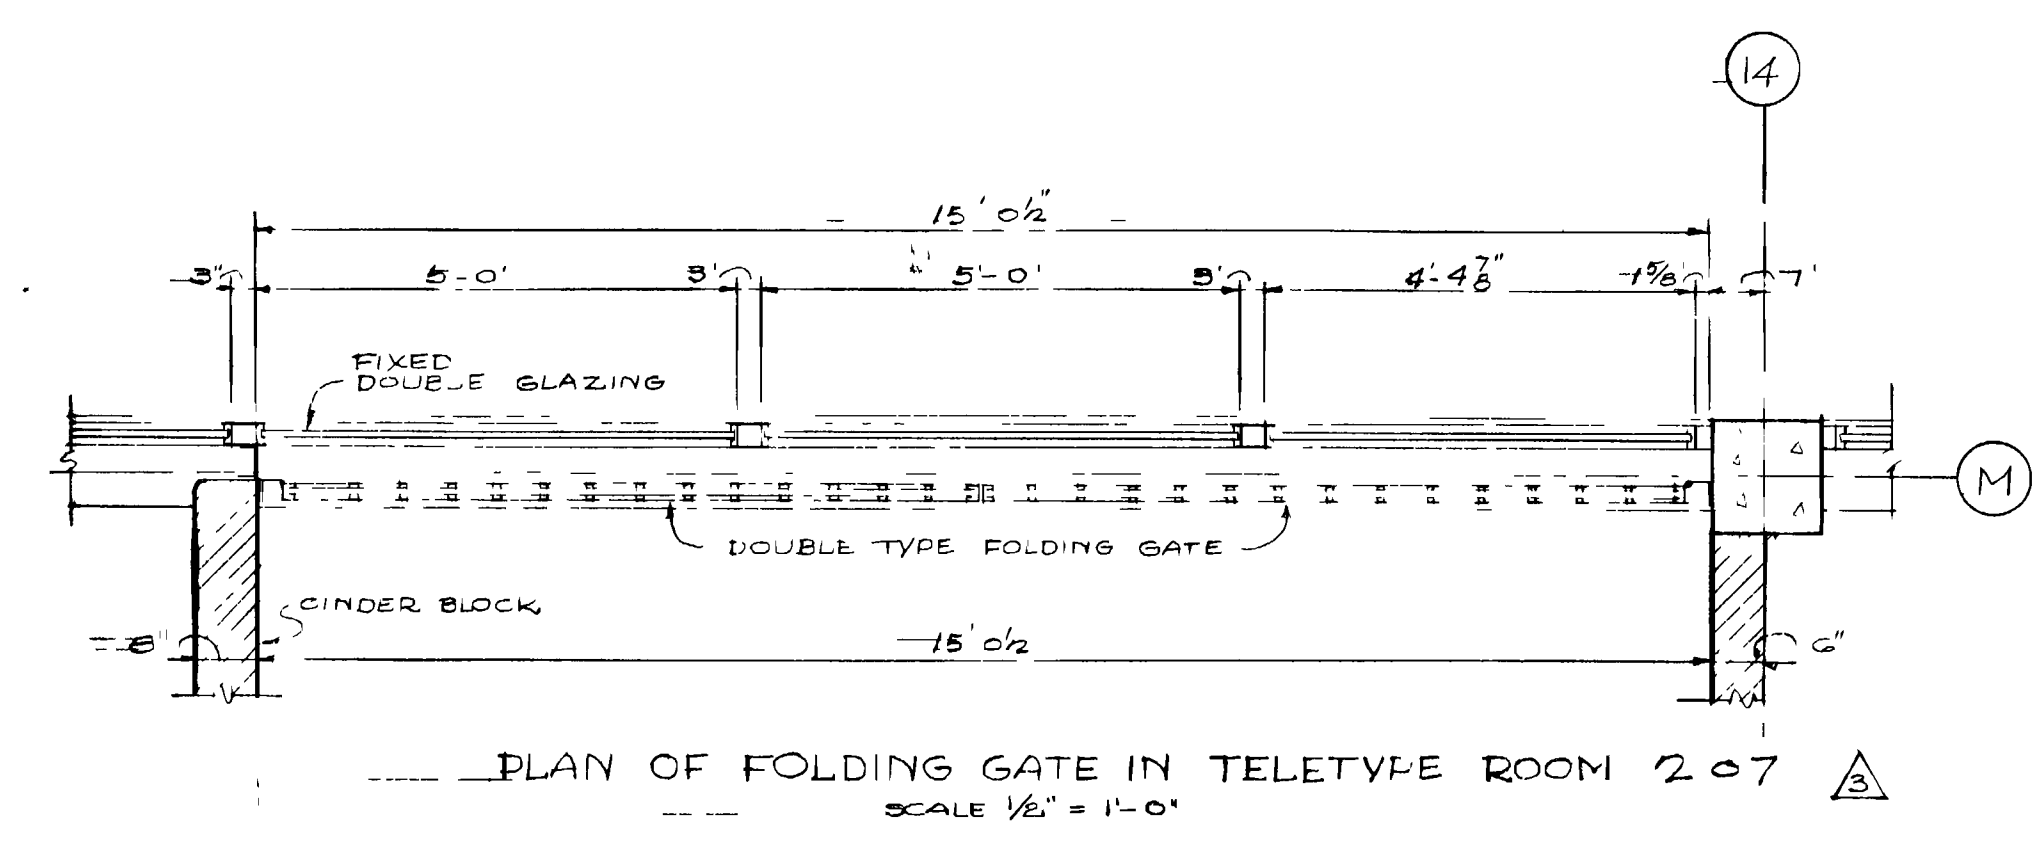

CLASSIFICATION REVIEW
BY: [Signature]
DATE: 11/15/52

CLASSIFICATION CHANGED TO
Unclassified
BY: [Signature]
DATE: 2-2-98

CLASSIFICATION CHANGED TO
UNCLASSIFIED
BY: [Signature]
DATE: 11/15/52

REVIEWED FOR CLASSIFICATION
TWP 05/20/2014
Initials Date
UNCLASSIFIED

| NO | DATE | DESCRIPTION | BY | DATE |
|----|----------|--|----|------------|
| 10 | 10/25/53 | AS BUILT | | |
| 9 | 3/19/53 | DEVIATION REQUEST NO. 778 APPROVED ISSUE | | 9/10/26/53 |
| 8 | 2/6/52 | DEVIATION REQUEST NO. 778-A | | |
| 7 | 11/15/52 | DEVIATION REQUEST NO. 619-A | | |
| 6 | 6/30/52 | DEVIATION REQUEST NO. 503-A | | |
| 5 | 5/15/52 | REVISION REQUEST NO. 557 | | |
| 4 | 4/15/52 | REVISION REQUEST NO. 508 | | |
| 3 | 10/15/51 | REVISION REQUEST NO. 1014 | | 9/27/51 |
| 2 | 1/21/51 | CONSTRUCTION 2 | | |
| 1 | 9/1/51 | FOR 'A' AND 'C' APPROVAL | | |

UNITED STATES
ATOMIC ENERGY COMMISSION
SMITH, HINCHMAN & GRYLLE, INC.
ARCHITECTS & ENGINEERS
DETROIT 26, MICHIGAN
DRAWING TITLE
ROOM DETAILS
SCALE AS SHOWN

| | |
|-------------------------|-------------------------|
| DRAWN BY: A. WALKER | CHECKED BY: R. J. BROWN |
| DATE: 9/17/51 | DATE: 9/27/51 |
| IN CHARGE: L. V. DANTAS | DATE: 9/27/51 |

PROJECT: PLANT ADMINISTRATION C-100
SHEET: BI-16-A

Unclassified