


~~SECRET~~

Unclassified

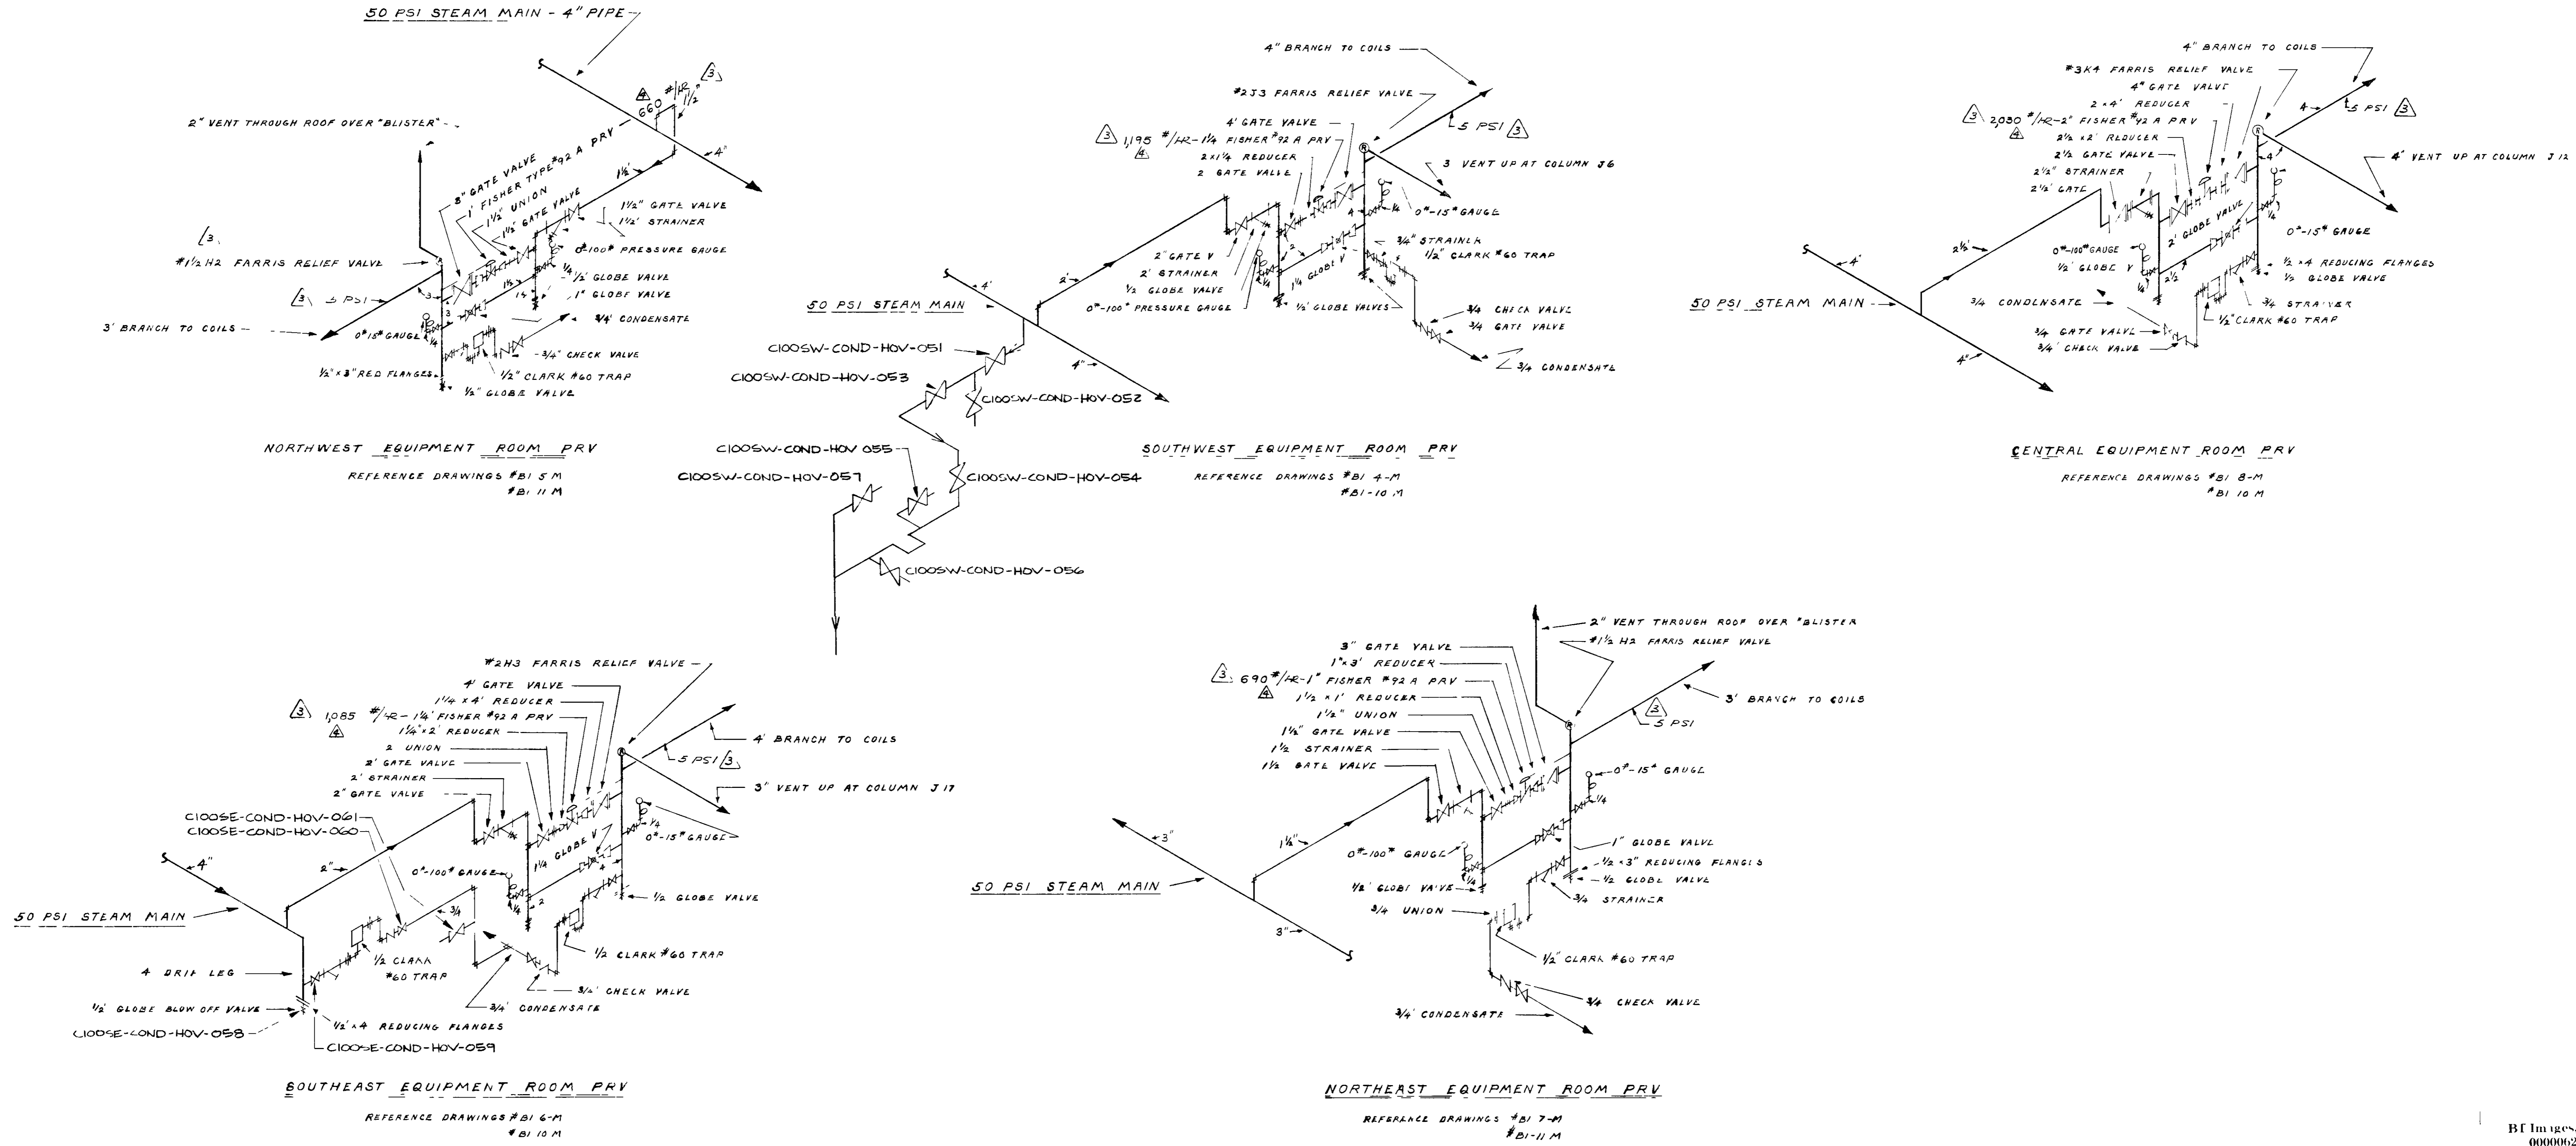

BI Images, Inc
00000621

~~SECRET~~

REVIEWED FOR
CLASSIFICATION
RLH 05/23/2014
Initials Date
UNCLASSIFIED

CLASSIFICATION CHANGED TO **Unclassified**

By Authority of **RLH 8-7-97**
Miller **2-2-98**
2-2-98

OF STATEMENT OF THE REVIEW OF CLASSIFICATION REVIEW	
1. REVIEWER	DATE
2. REVIEWER	DATE
3. REVIEWER	DATE
4. REVIEWER	DATE
5. REVIEWER	DATE
6. REVIEWER	DATE
7. REVIEWER	DATE
8. REVIEWER	DATE
9. REVIEWER	DATE
10. REVIEWER	DATE

Unclassified

REV	DATE	BY	REASON	APPROVED
6	05/23/2014	RLH	REVIEWED FOR CLASSIFICATION	
5	11/16/53	AS	BUILT	
4	4-29-52		REVISION REQUEST NO 542	
3	9-20-52		REVISION REQUEST NO 458	
2	12/1/51		CONSTRUCTION	
1	12/1/51		APPROVAL	

REV	DATE	BY	REASON	APPROVED
6	11/16/53	AS	BUILT	
5	4-29-52		REVISION REQUEST NO 542	
4	9-20-52		REVISION REQUEST NO 458	
3	12/1/51		CONSTRUCTION	
2	12/1/51		APPROVAL	

UNITED STATES ATOMIC ENERGY COMMISSION		
SMITH, HINCHMAN & GRYLLS, INC ARCHITECTS & ENGINEERS DETROIT 26, MICHIGAN		
DRAWING TITLE		
STEAM PRESSURE REDUCING STATIONS		
DRAWING APPROVED DATE	DRAWING APPROVED DATE	DRAWING APPROVED DATE
12-6-51	12-15-51	12-15-51
ARCHITECT ENGINEER	CHEMICAL ENGINEER	A. E. ENGINEER
DATE	DATE	DATE
12/1/51	12/1/51	12/1/51
PROJECT	BUILDING	ROOM
"C" PLANT	ADMINISTRATION	BI-29-M
	C-100	

UNCLASSIFIED

~~SECRET~~