



RESTRICTED
OFFICIAL USE ONLY


Unclassified

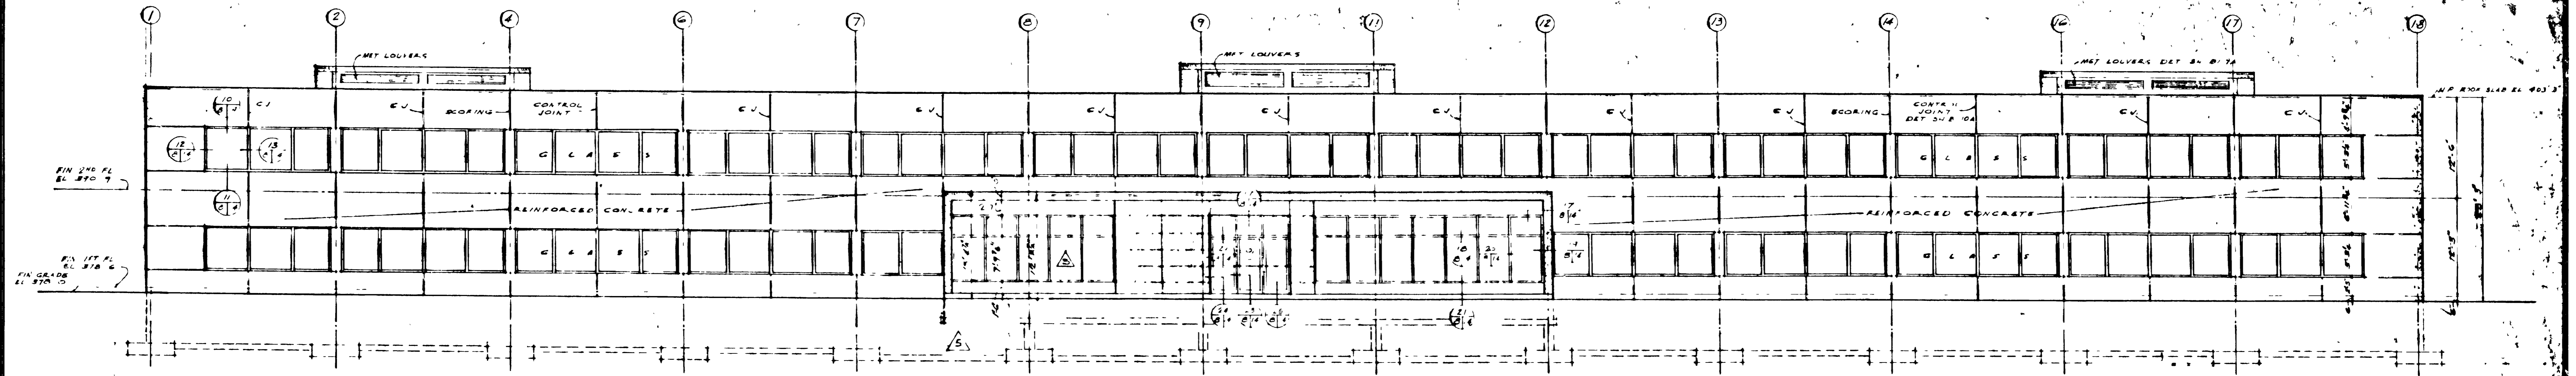

SOUTH ELEVATION - MAIN WING

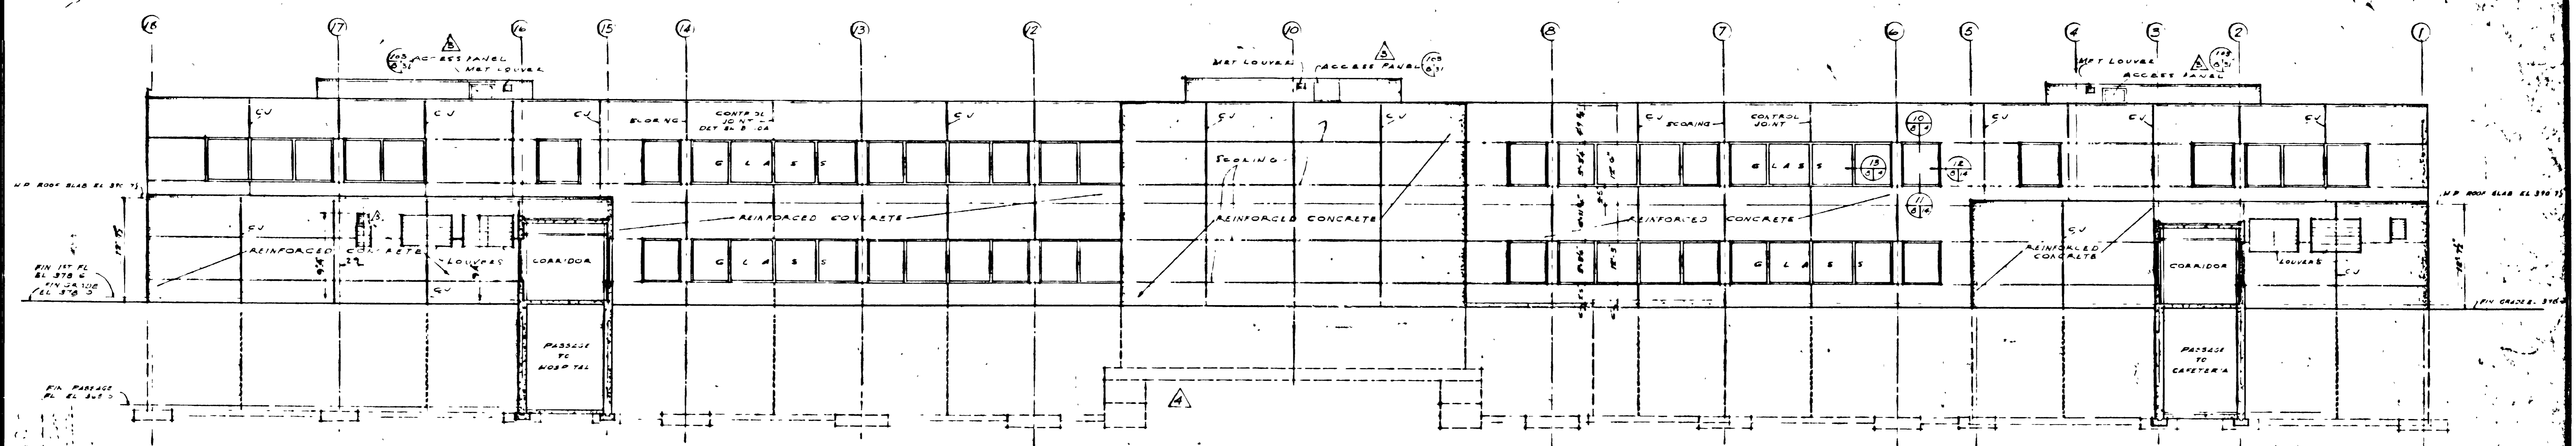

NORTH ELEVATION - MAIN BLDG

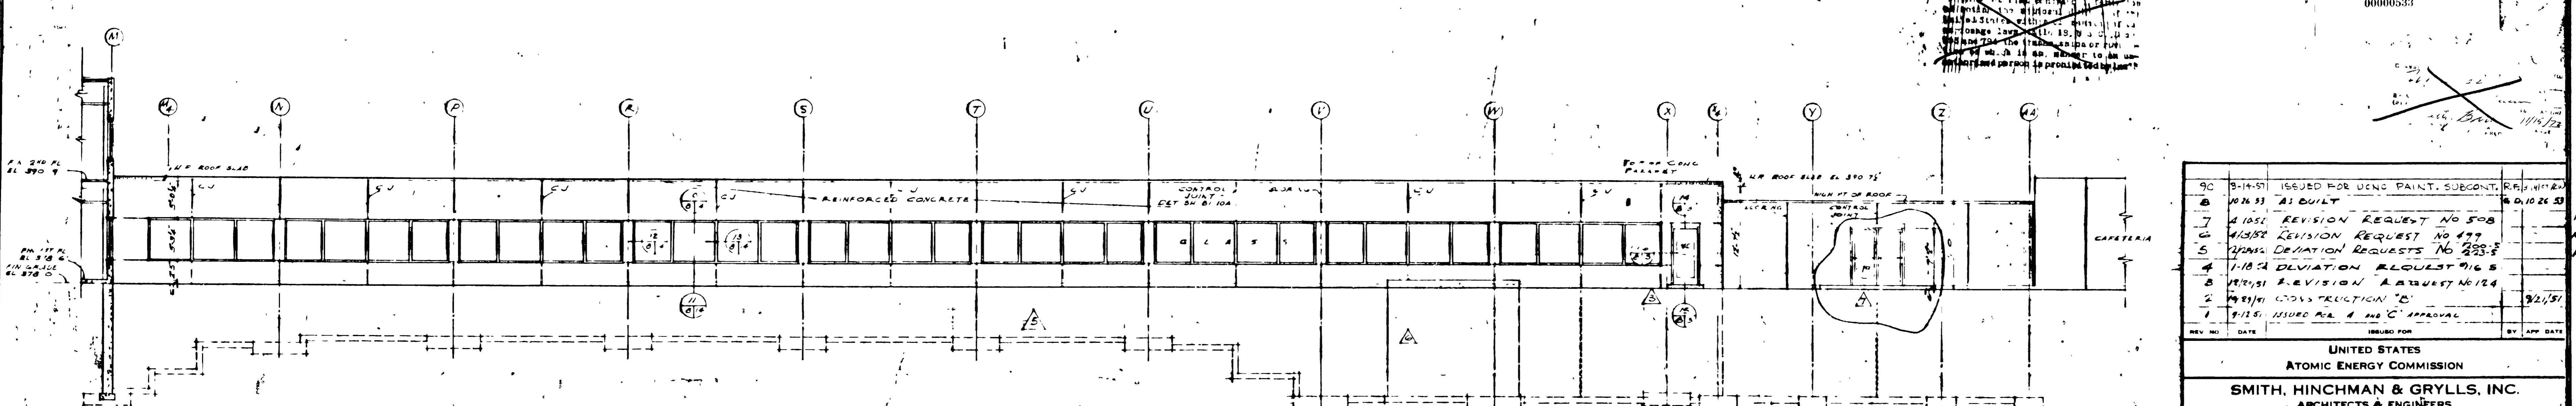

EAST ELEVATION - WEST WING

REVIEWED FOR CLASSIFICATION
DE 05/19/2014
Initials Date
UNCLASSIFIED

CLASSIFICATION CHANGED TO
Unclassified
DATE 8-27-14
BY [Signature]
REASON: AEC 2018
2-2-14

Unclassified

BT Images, Inc
00000533

90	8-14-57	ISSUED FOR CONC. PAINT, SUBCONT.	REVISION
8	10-14-57	AS BUILT	REVISION
7	4-10-58	REVISION REQUEST NO 508	REVISION
6	4-10-58	REVISION REQUEST NO 477	REVISION
5	4-10-58	REVISION REQUEST NO 283-E	REVISION
4	1-10-58	REVISION REQUEST NO 165	REVISION
3	10-15-57	REVISION REQUEST NO 124	REVISION
2	10-15-57	CONSTRUCTION 'C'	REVISION
1	8-15-57	ISSUED AS A 'C' APPROVAL	REVISION

UNITED STATES
ATOMIC ENERGY COMMISSION

SMITH, HINCHMAN & GRYLLS, INC.
ARCHITECTS & ENGINEERS
DETROIT 26, MICHIGAN

DRAWING TITLE
EXTERIOR ELEVATIONS
SCALE 1/8" = 1'-0"

DRAWING APPROVED DATE	DRAWING APPROVED DATE	DRAWING APPROVED DATE
9-20-57	9-20-57	9-20-57
ARCHITECT ENGINEER	ARCHITECT ENGINEER	ARCHITECT ENGINEER
Z.V. DANTAS	[Signature]	R.J. BROWN
DATE 9/17/57	DATE 9/17/57	DATE 9/17/57
PROJECT	PROJECT	PROJECT
ADMINISTRATION	ADMINISTRATION	ADMINISTRATION
C-100	C-100	C-100
SHEET	SHEET	SHEET
8768	8768	8768
PROJECT	PROJECT	PROJECT
ADMINISTRATION	ADMINISTRATION	ADMINISTRATION
C-100	C-100	C-100
SHEET	SHEET	SHEET
BI-8-A	BI-8-A	BI-8-A

MICROFILMED