
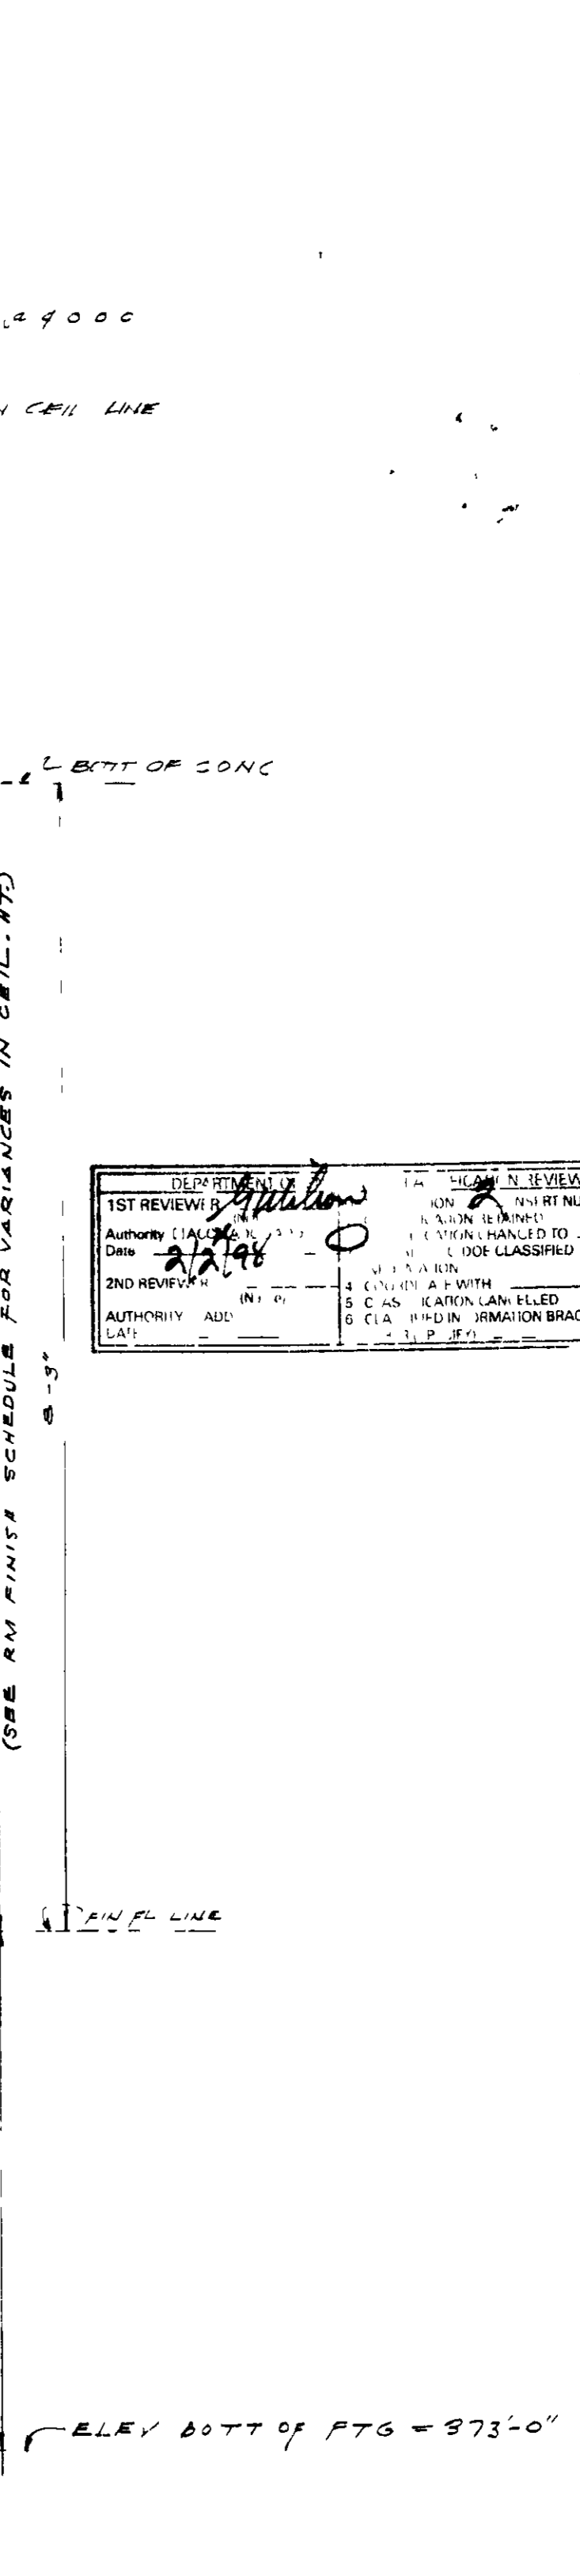
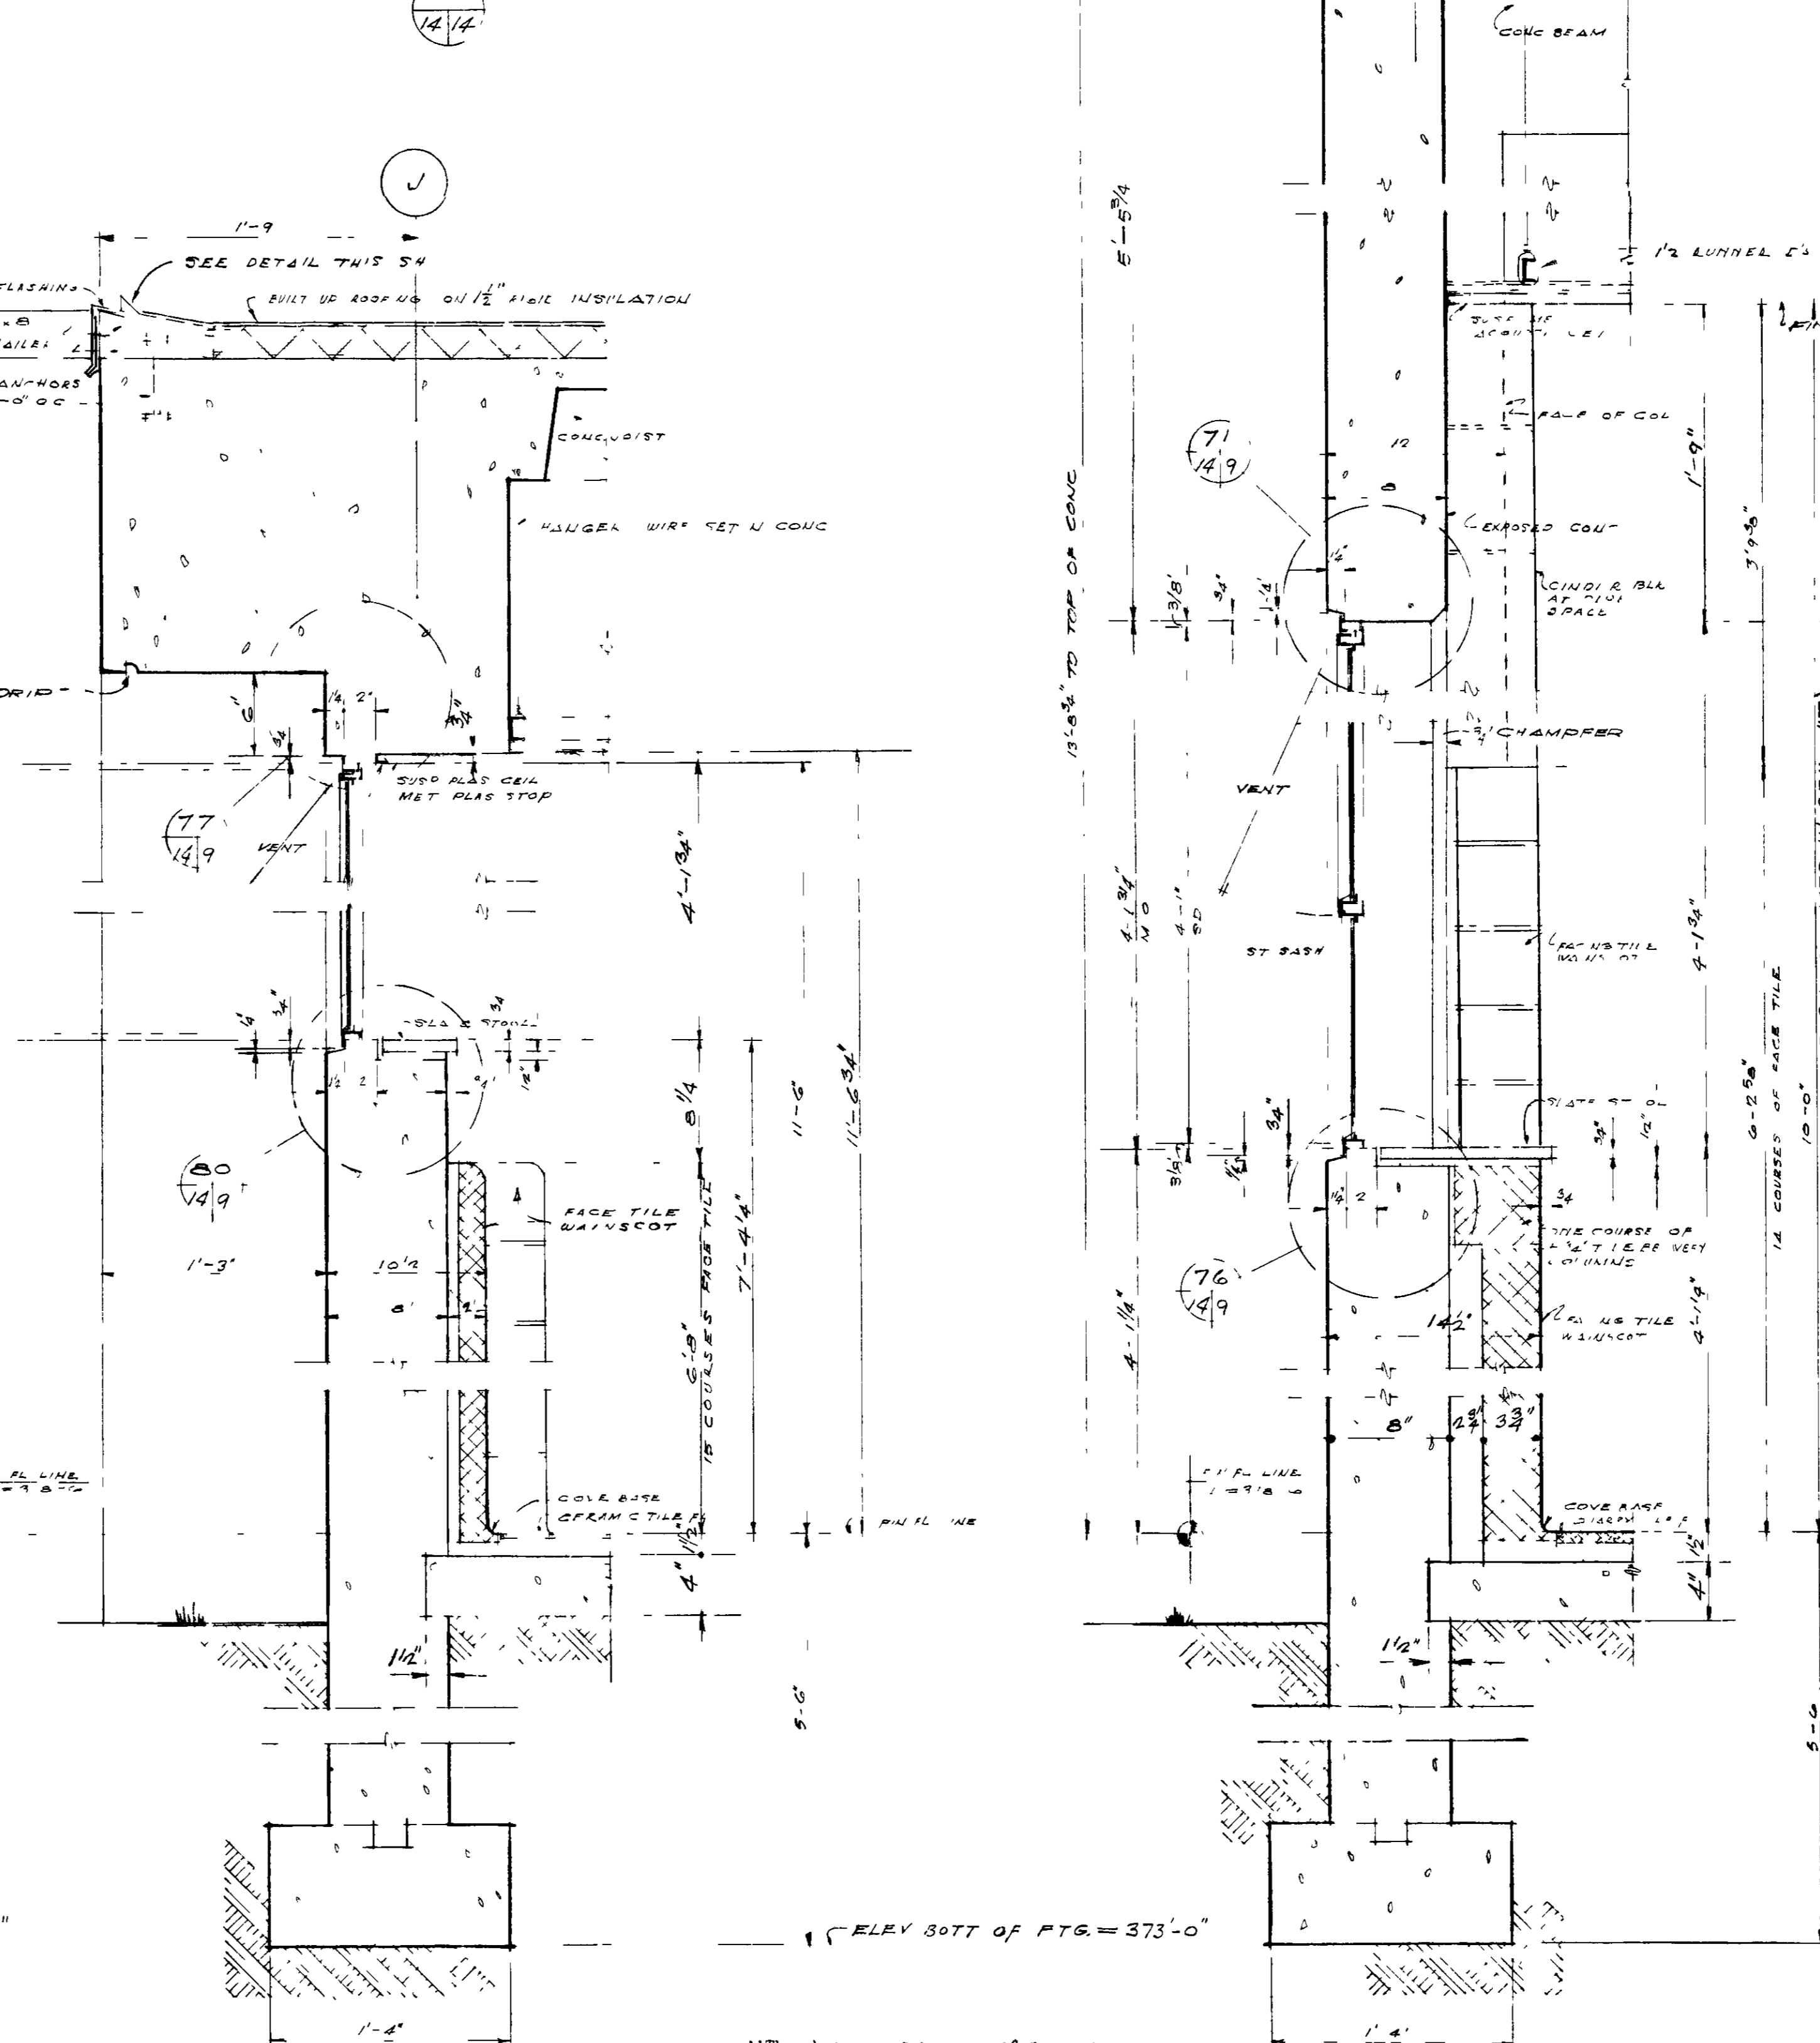
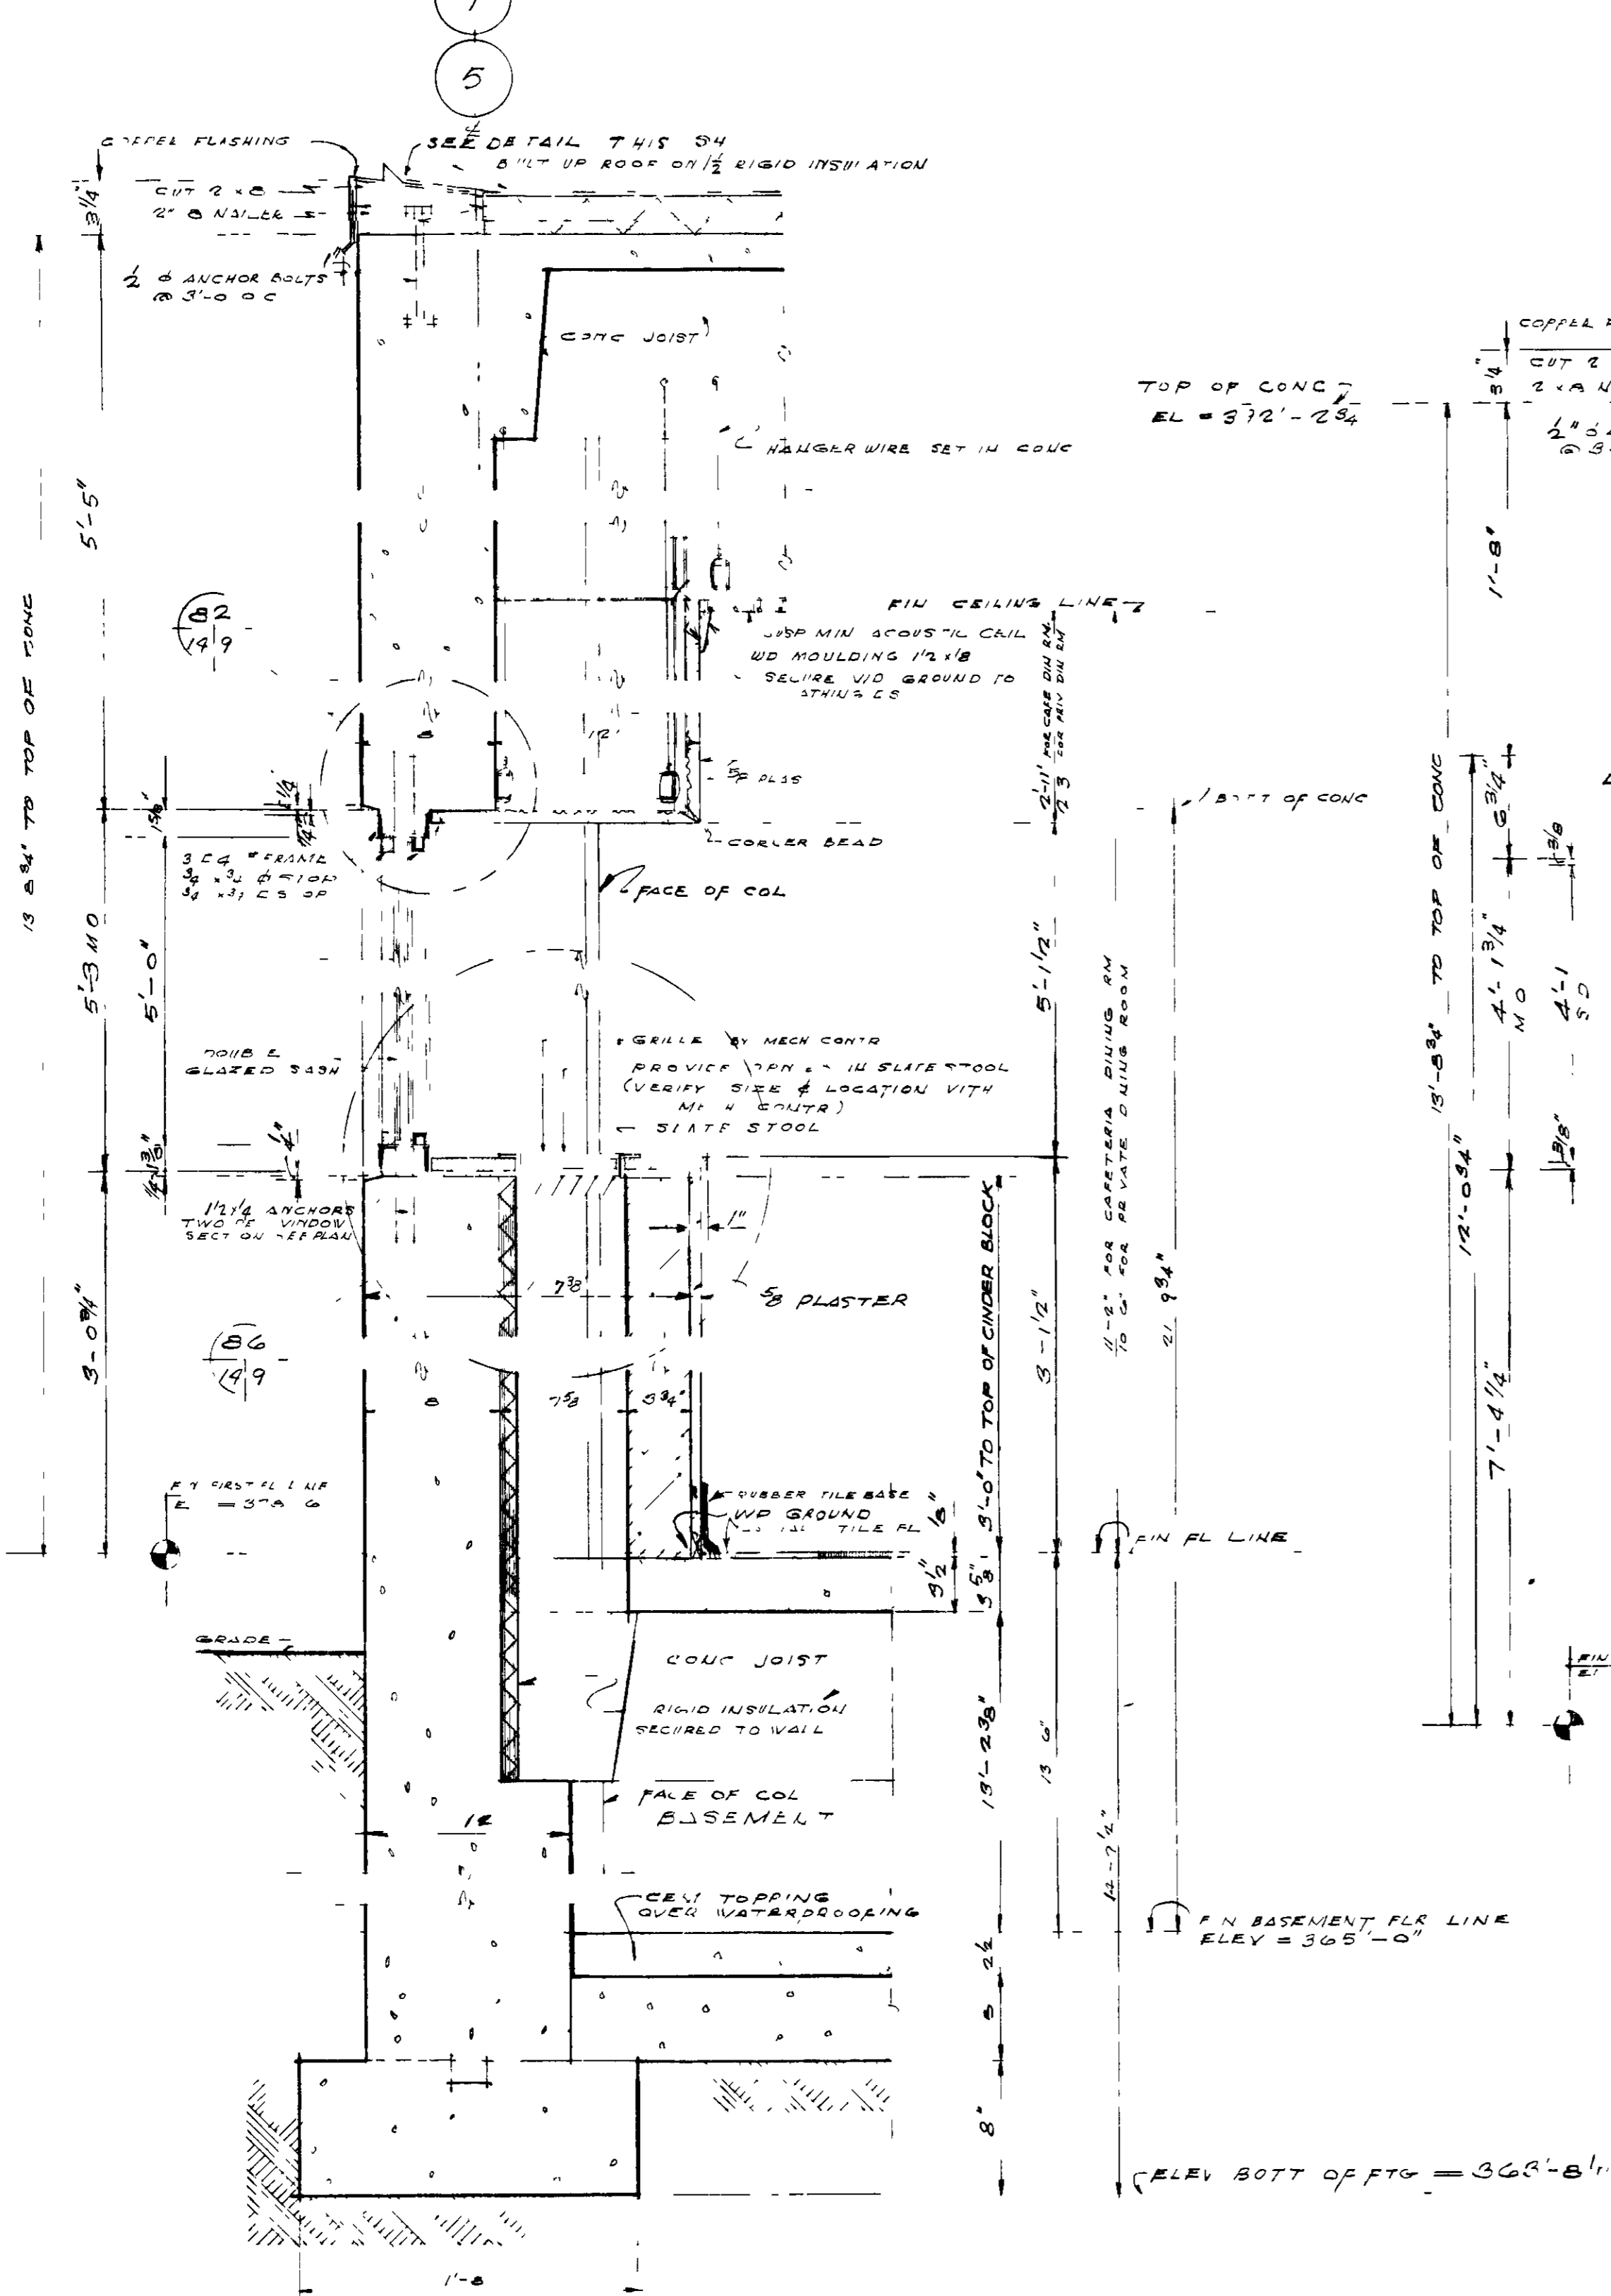 

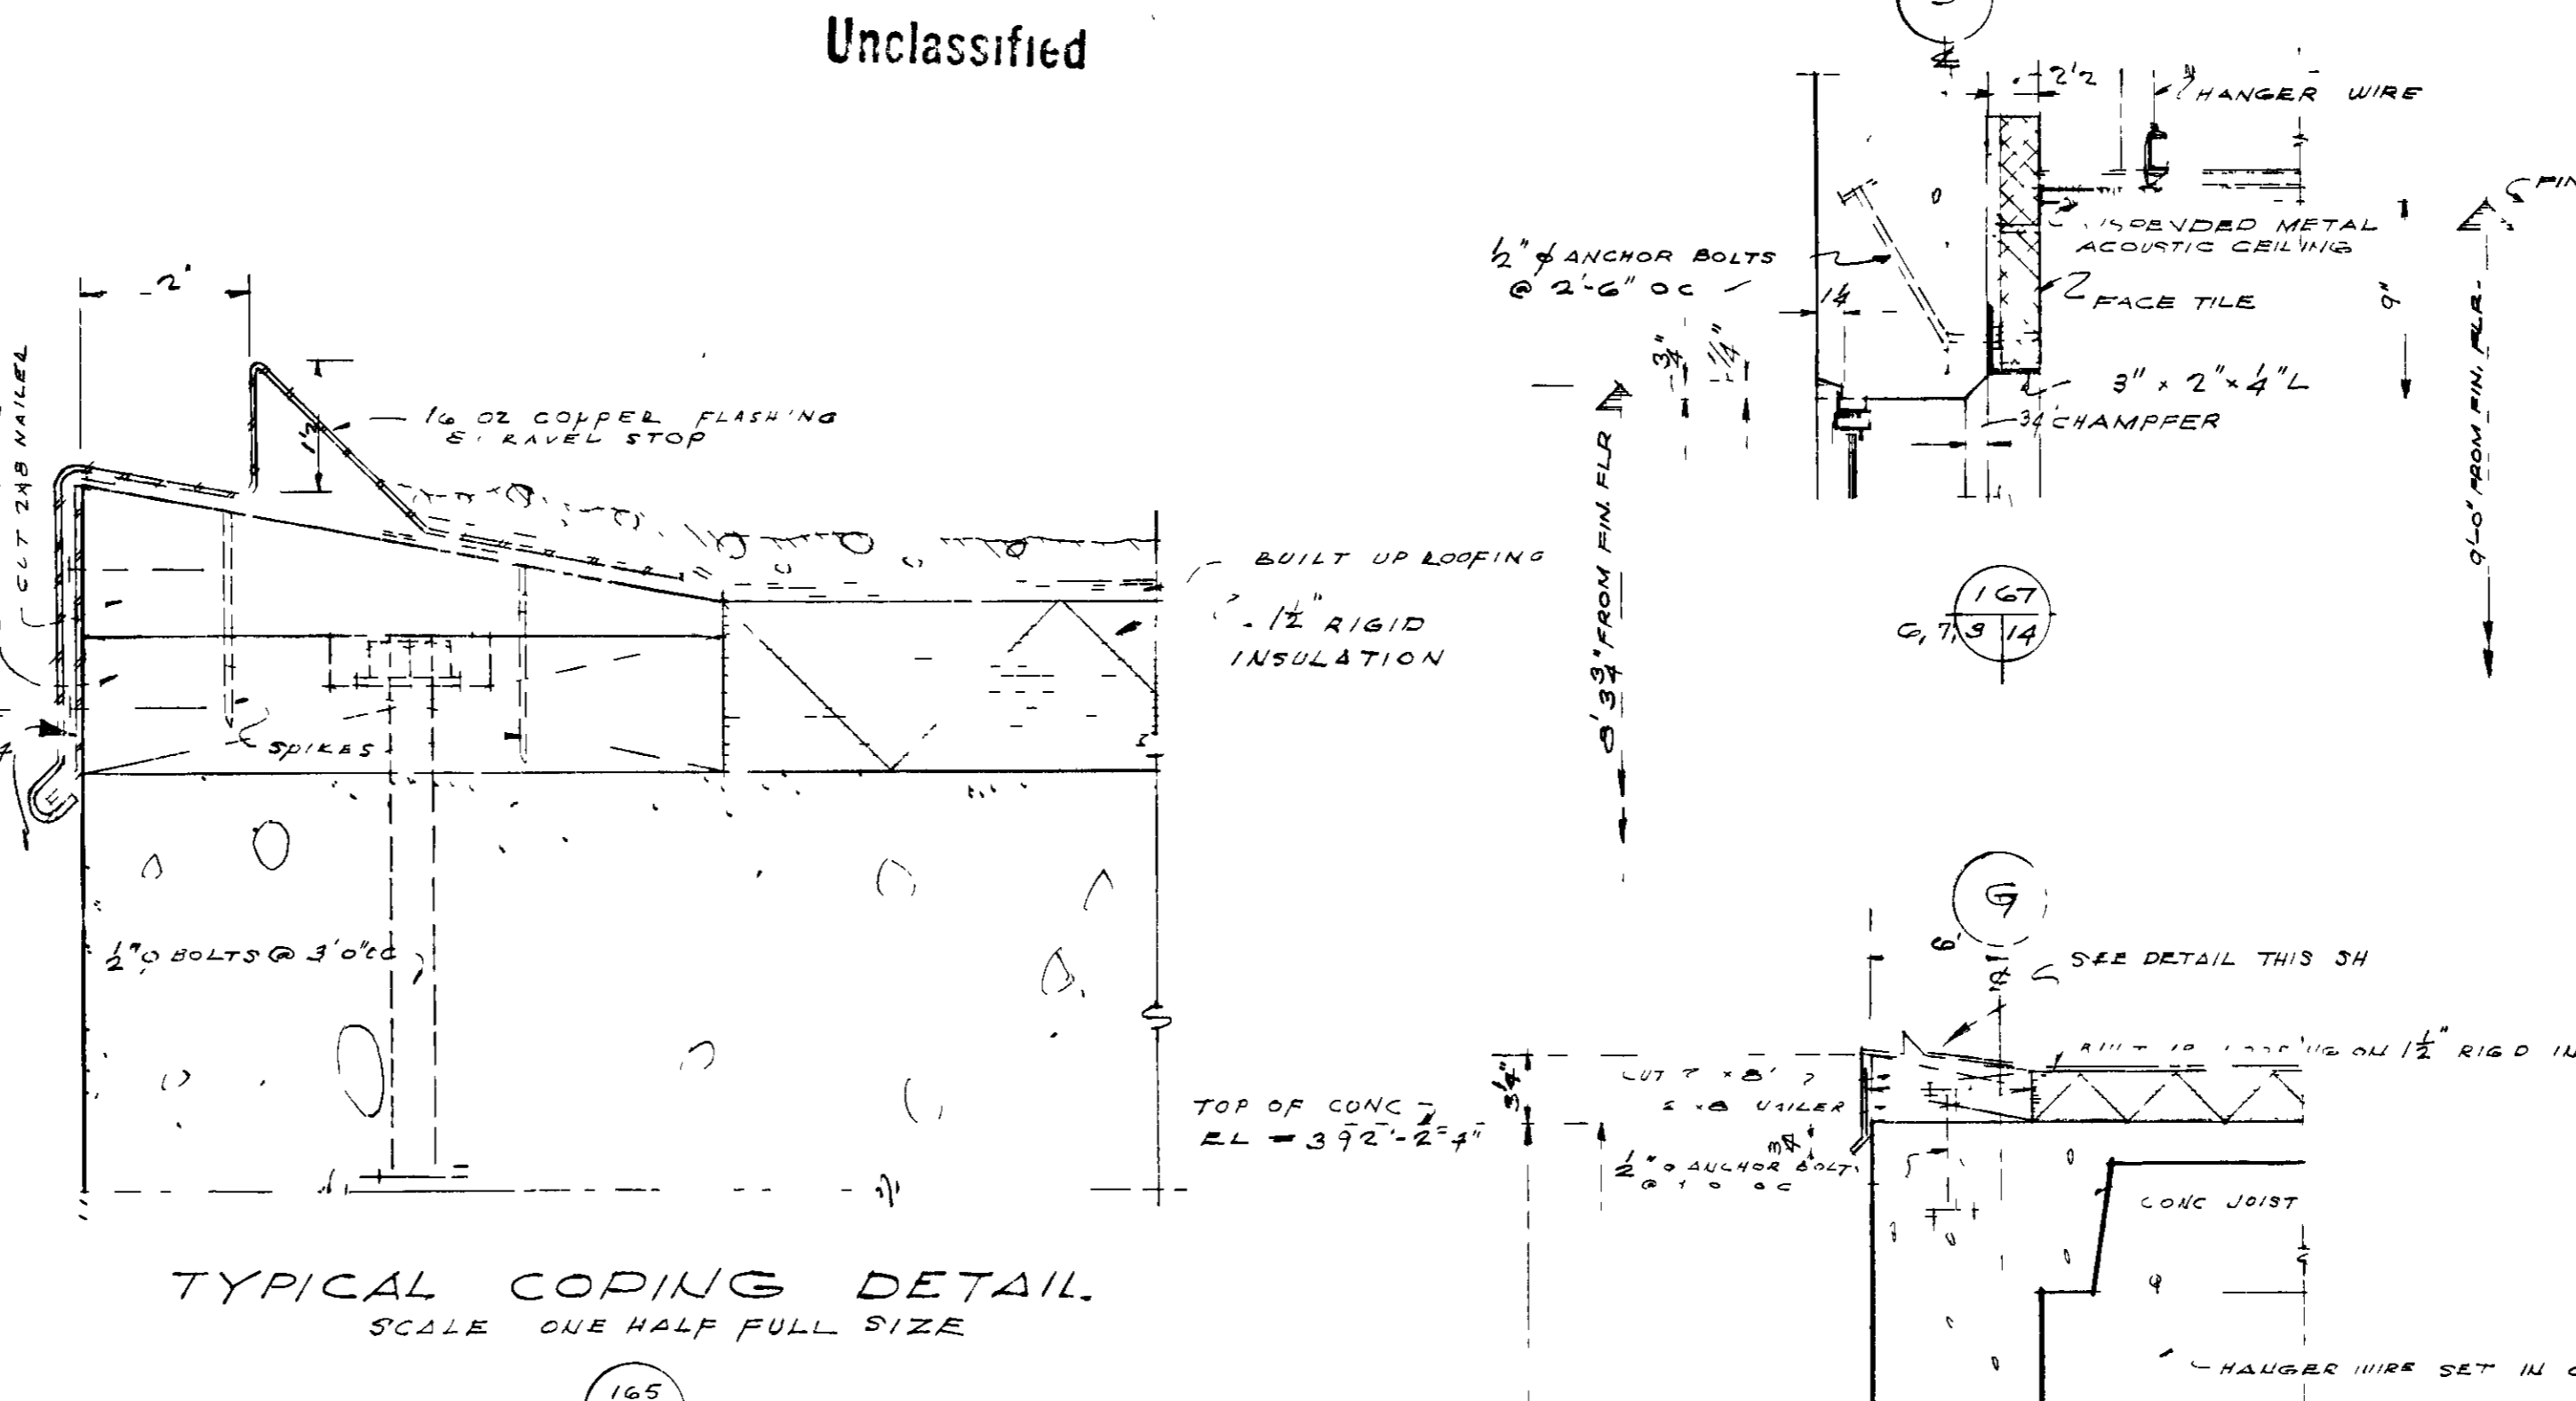


Unclassified

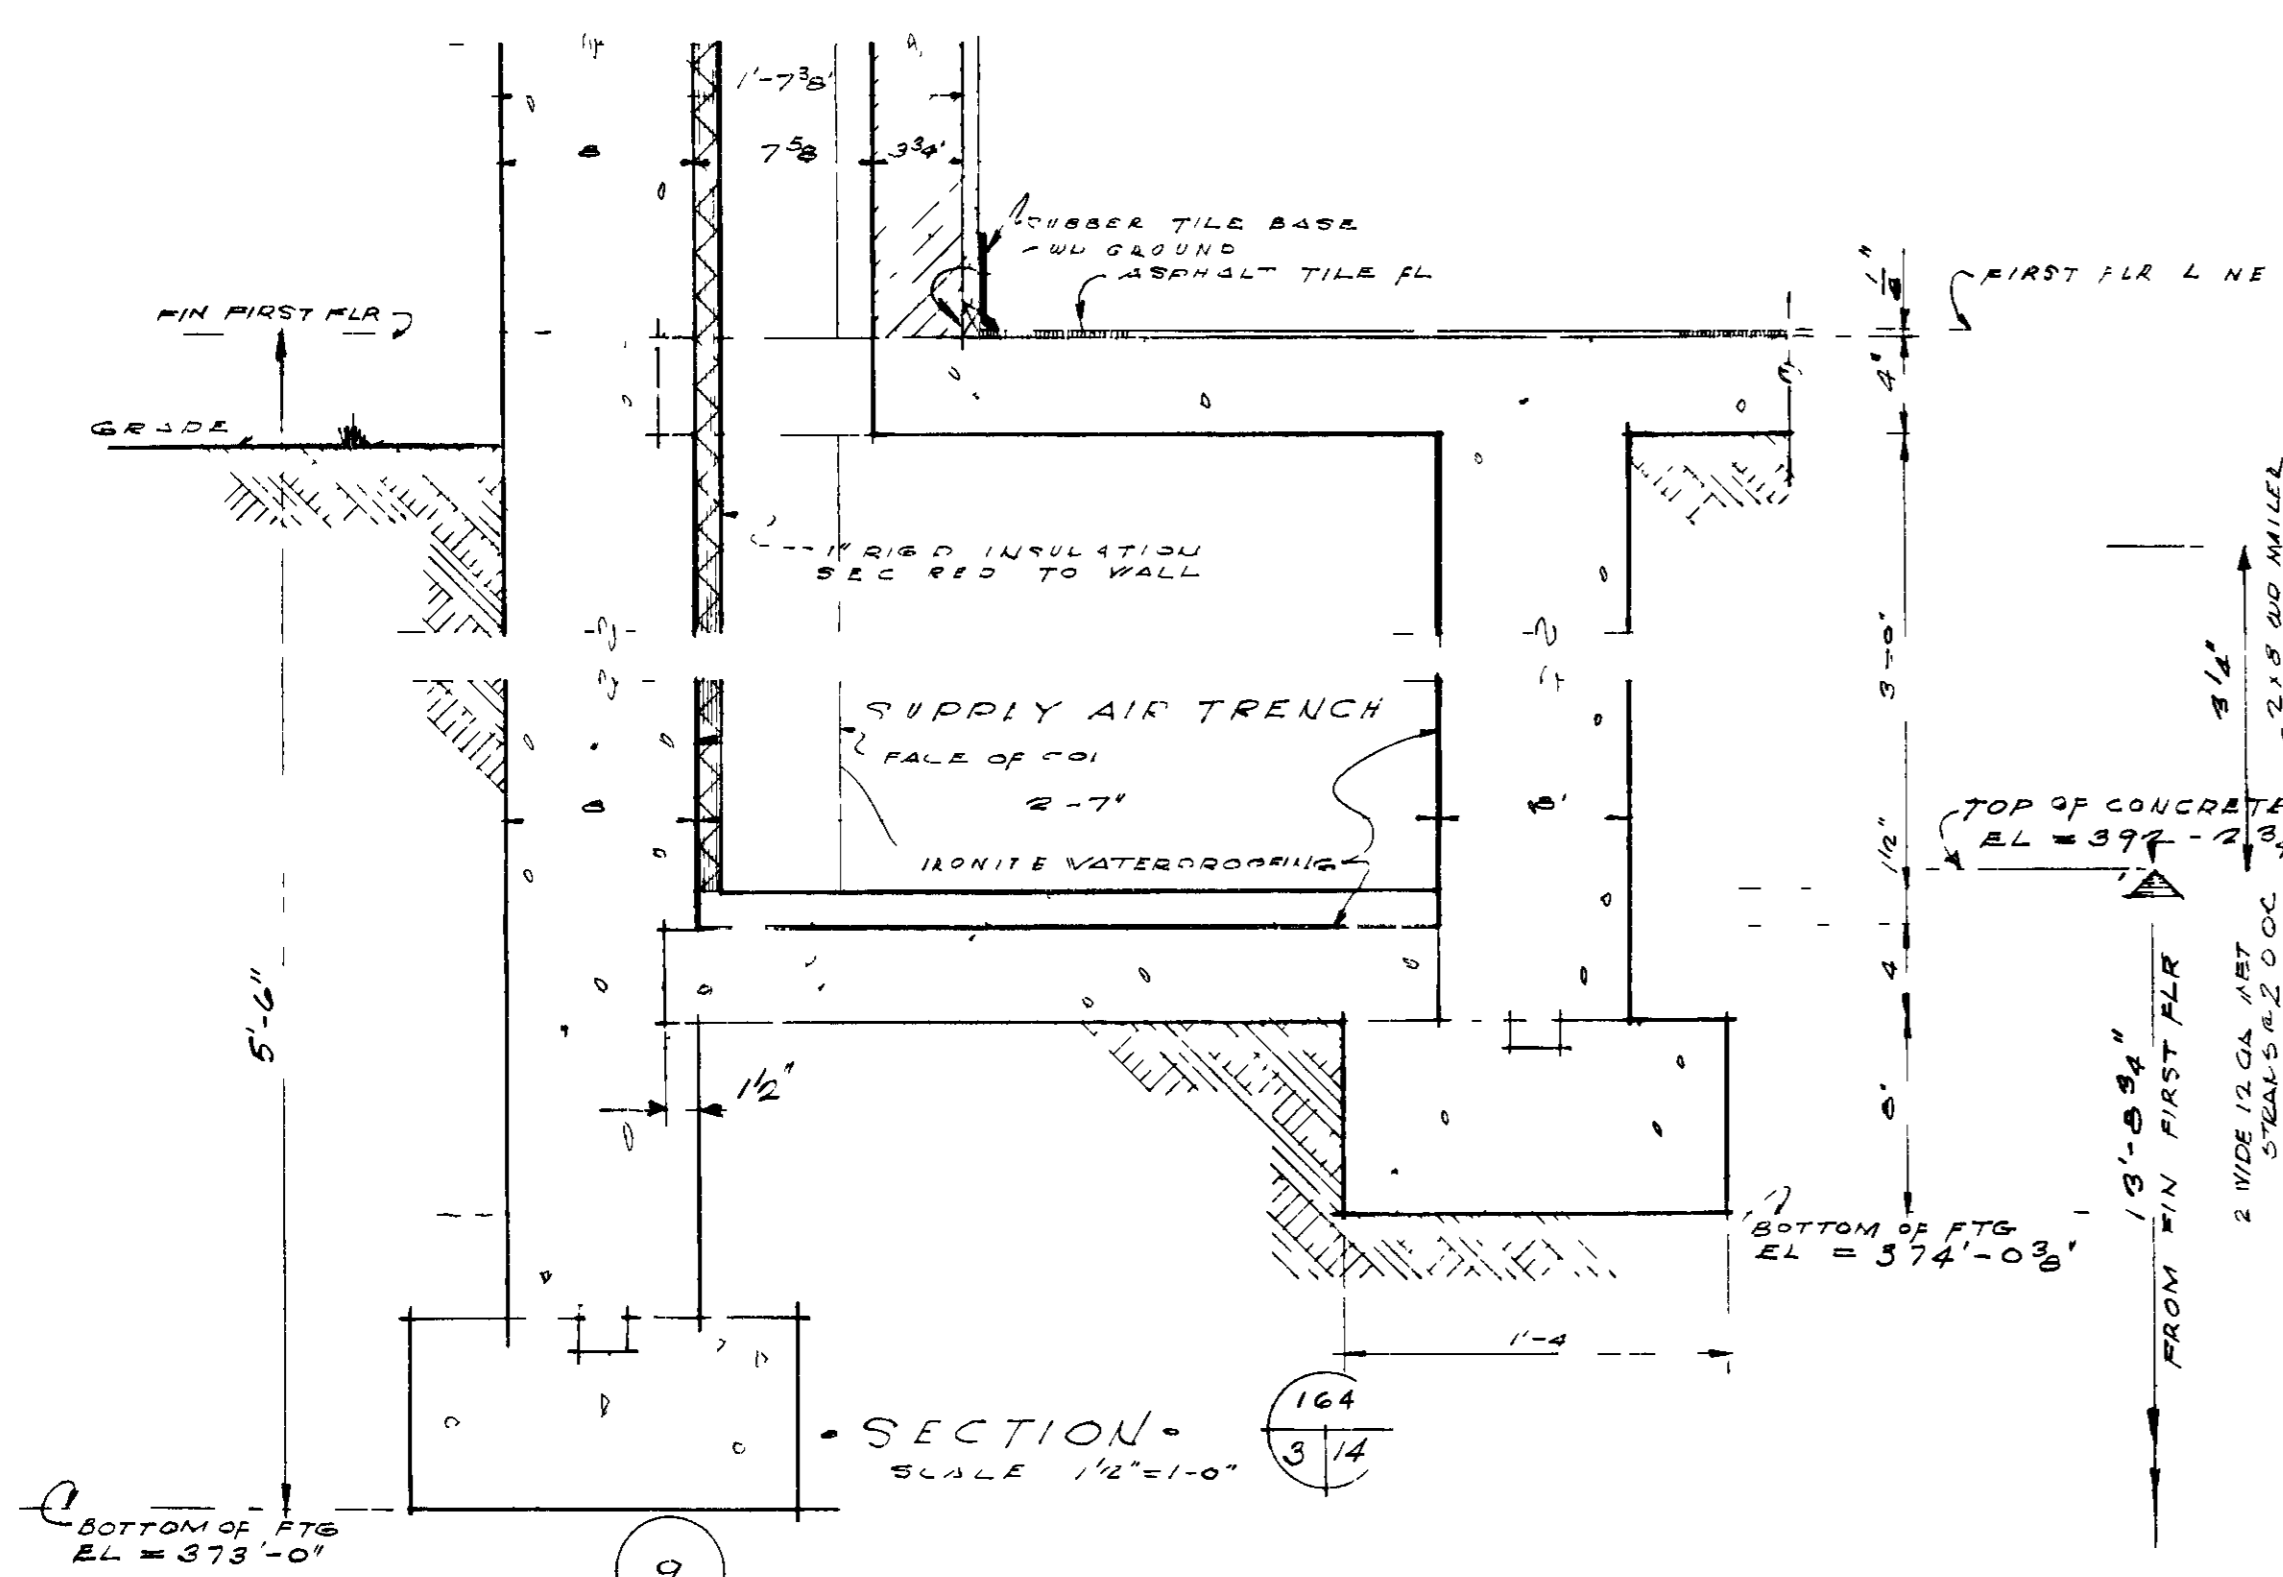

1ST REVIEW	DATE	BY	REVISION	DATE	BY
2ND REVIEW	DATE	BY	REVISION	DATE	BY
3RD REVIEW	DATE	BY	REVISION	DATE	BY

CLASSIFICATION CHANGED TO **Unclassified** REVIEWED FOR CLASSIFICATION
 AUTHORITY: **Unclassified** DATE: **06/05/2014**
 BY: **Unclassified** INITIALS: **Unclassified** DATE: **Unclassified**
 Verified: **Unclassified** DATE: **Unclassified**
 Martin Matusz PGP

BT Images Inc
00000867

REV NO.	DATE	DESCRIPTION	ISSUED FOR	BY	APP. DATE
5	11/6/59	AS BUILT			9/20/11
4	3/1/59	DEVIATION REQUEST NO 1000 A			9/20/59
3	12/12/51	REVISION REQUEST NO 1000			9/20/59
2	10/27/51	CONSTRUCTION '51			9/20/59
1	9/12/51	A & C APPROVAL			

UNITED STATES ATOMIC ENERGY COMMISSION		
SMITH, HINCHMAN & GRYLLS, INC ARCHITECTS & ENGINEERS DETROIT 26 MICHIGAN		
DRAWING TITLE WALL SECTIONS		
DRAWING APPROVED DATE	DRAWING APPROVED DATA	DRAWING APPROVED BY
DATE	CHECKED	DATE
IN CHARGE	DATE	DATE
PROJECT	BUILDING	SHEET
"C" PLANT	CAFETERIA C-101	B2-14-A

MICROFILMED