
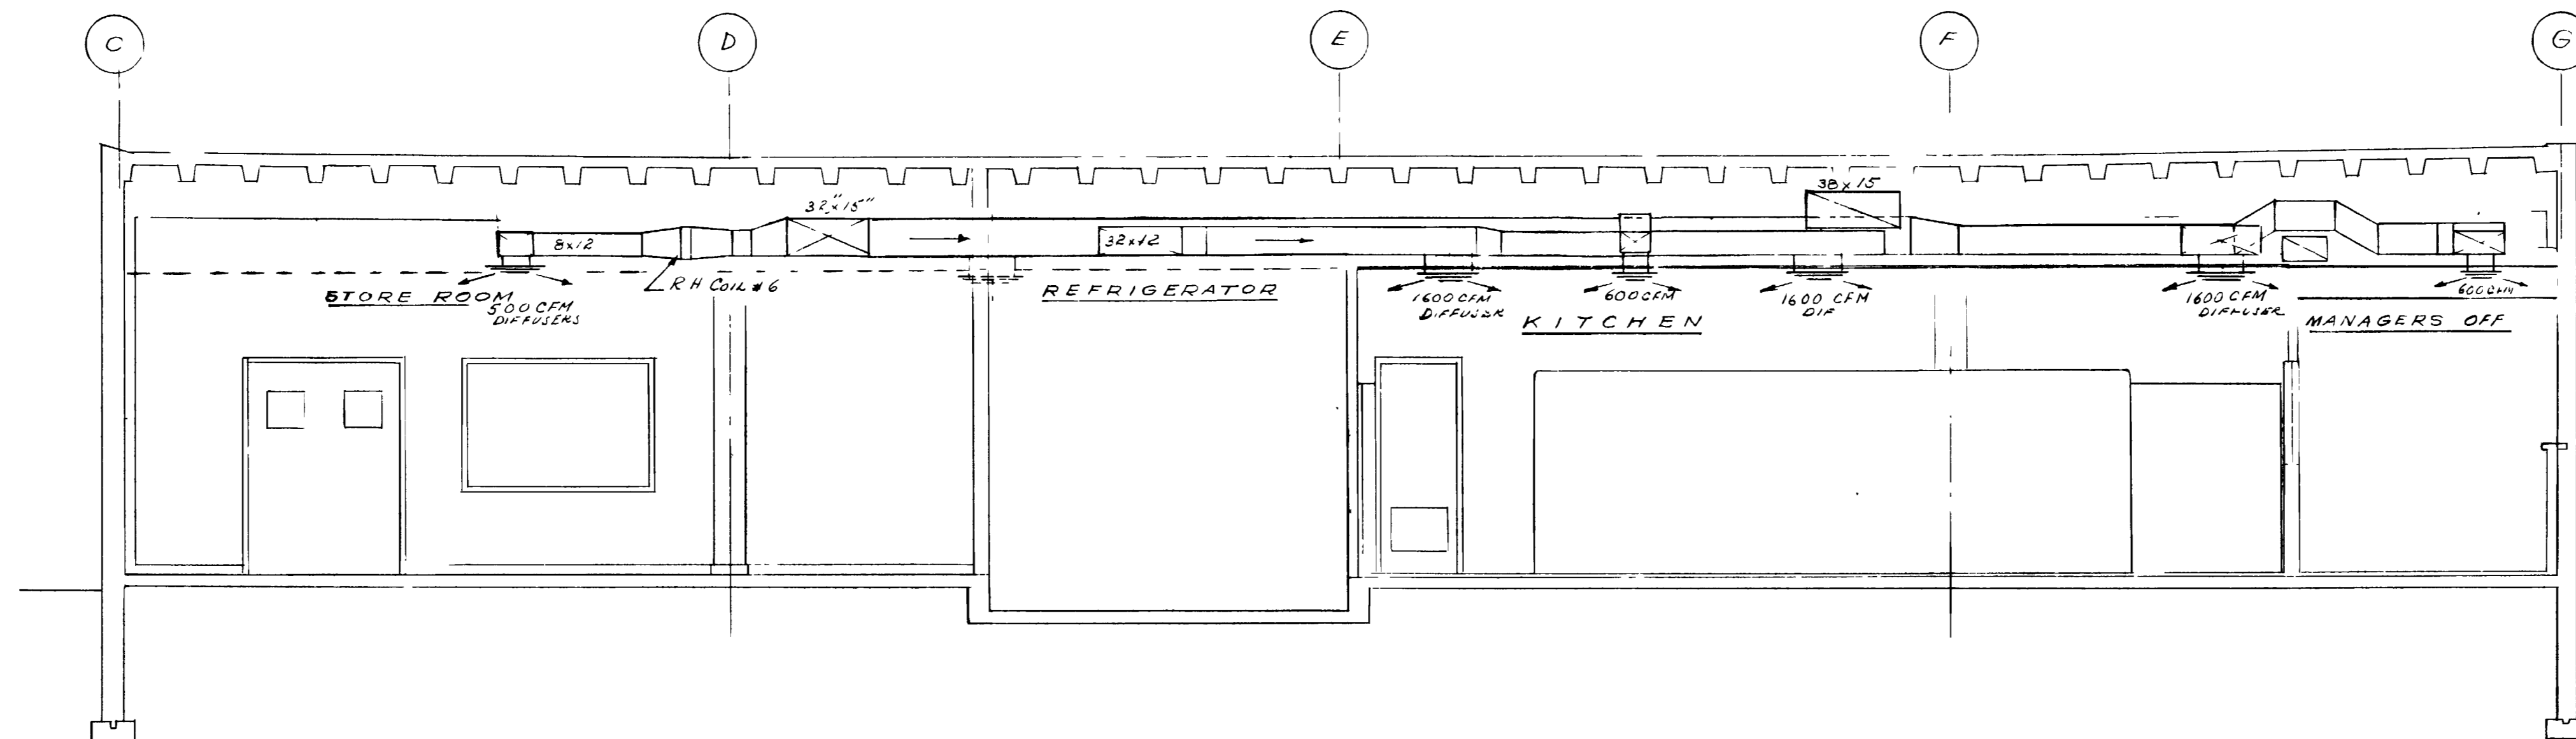


Unclassified

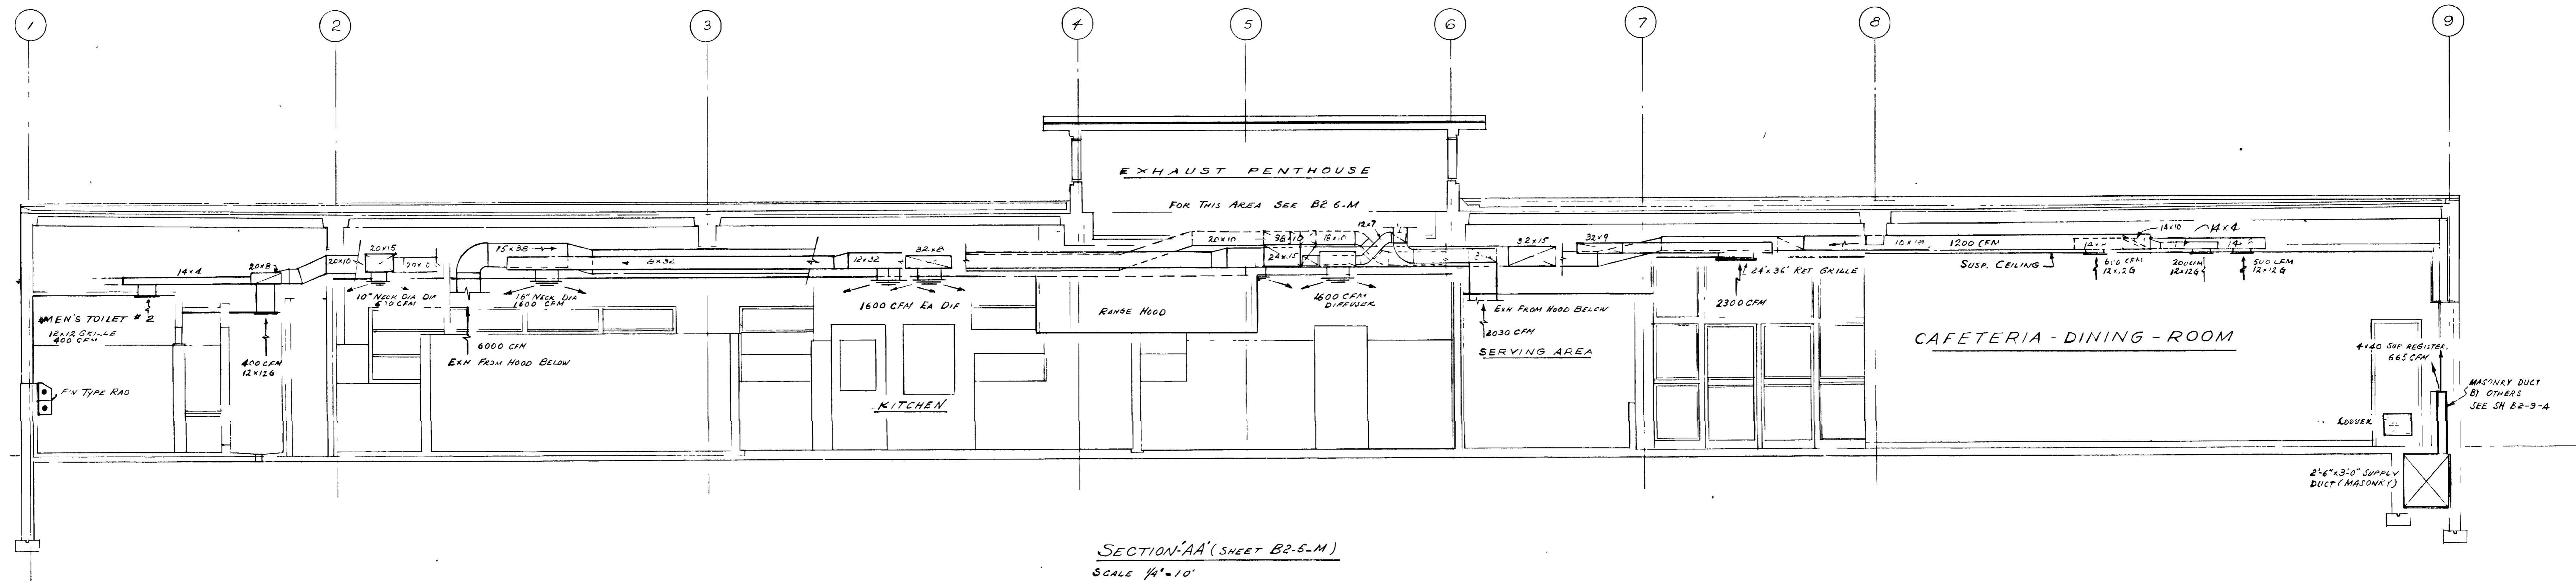

Unclassified

CLASSIFICATION CHANGED
 Sheet Appropriate Classification Level and Category: (Type)
 By Authority of: DDP-12 2/1997
 Date: 2/1998
 Authority: ABC 2/1998
 Verified by: John Wilson 2/2/98
 Signature of Person Making Change: [Signature]
 Name: John Wilson
 Title: Senior Mechanical P.E.

BT Images, Inc
00000891

1ST REVIEWER	DATE	INITIALS	DATE
2ND REVIEWER	DATE	INITIALS	DATE
AUTHORITY	DATE	INITIALS	DATE

REVIEWED FOR CLASSIFICATION
 LL 08/04/2014
 UNCLASSIFIED

REV. NO.	DATE	ISSUED FOR	BY	APP. DATE
3	11/16/53	AS BUILT		11/16/53
2	11-1-51	CONSTRUCTION "B"		11-14-51
1	10-3-50	APPROVAL "A"		

UNITED STATES
 ATOMIC ENERGY COMMISSION
 SMITH, HINCHMAN & GRYLLS, INC.
 ARCHITECTS & ENGINEERS
 DETROIT 26, MICHIGAN
 DRAWING TITLE

AIR CONDITIONING - SECTIONS

DRAWING APPROVED-DATE	DRAWING APPROVED-DATE	DRAWING APPROVED-DATE
11-1-51	11-13-51	11-14-51
ARCHITECT ENGINEER	CHEMICAL ENGINEER	M.E.C. ENGINEER
DATE	CHECKED	DATE
11-1-51	11-13-51	11-14-51
DATE	CHECKED	DATE
11-1-51	11-13-51	11-14-51
PROJECT	BUILDING	SHEET
"C" PLANT	CAFETERIA C-101	B2-8-M

8768

Unclassified

UNCLASSIFIED

MICROFILMED