

SMITH HINCHMAN & GRYLLS INC

Unclassified


SCHEDULE OF INTERIOR FINISHES

DOOR SCHEDULE

DOOR TYPES

Table with columns: ROOM NO, ROOM NAME, FLOORS MATERIAL, BASE MATERIAL, WALL & PARTITIONS MATERIAL FINISH, CEILING MATERIAL FINISH, HT, REMARKS. Lists 172 rooms including basement, corridors, toilets, examination rooms, etc.

Table with columns: DOOR NO, LOCATION, DOOR OPENING, THICKNESS, TYPE, MATERIAL, THRESHOLD, FRAME, DET SH NO, REMARKS. Lists 180 doors with specifications like 5'0" x 7'0", H MET, CHANN, etc.

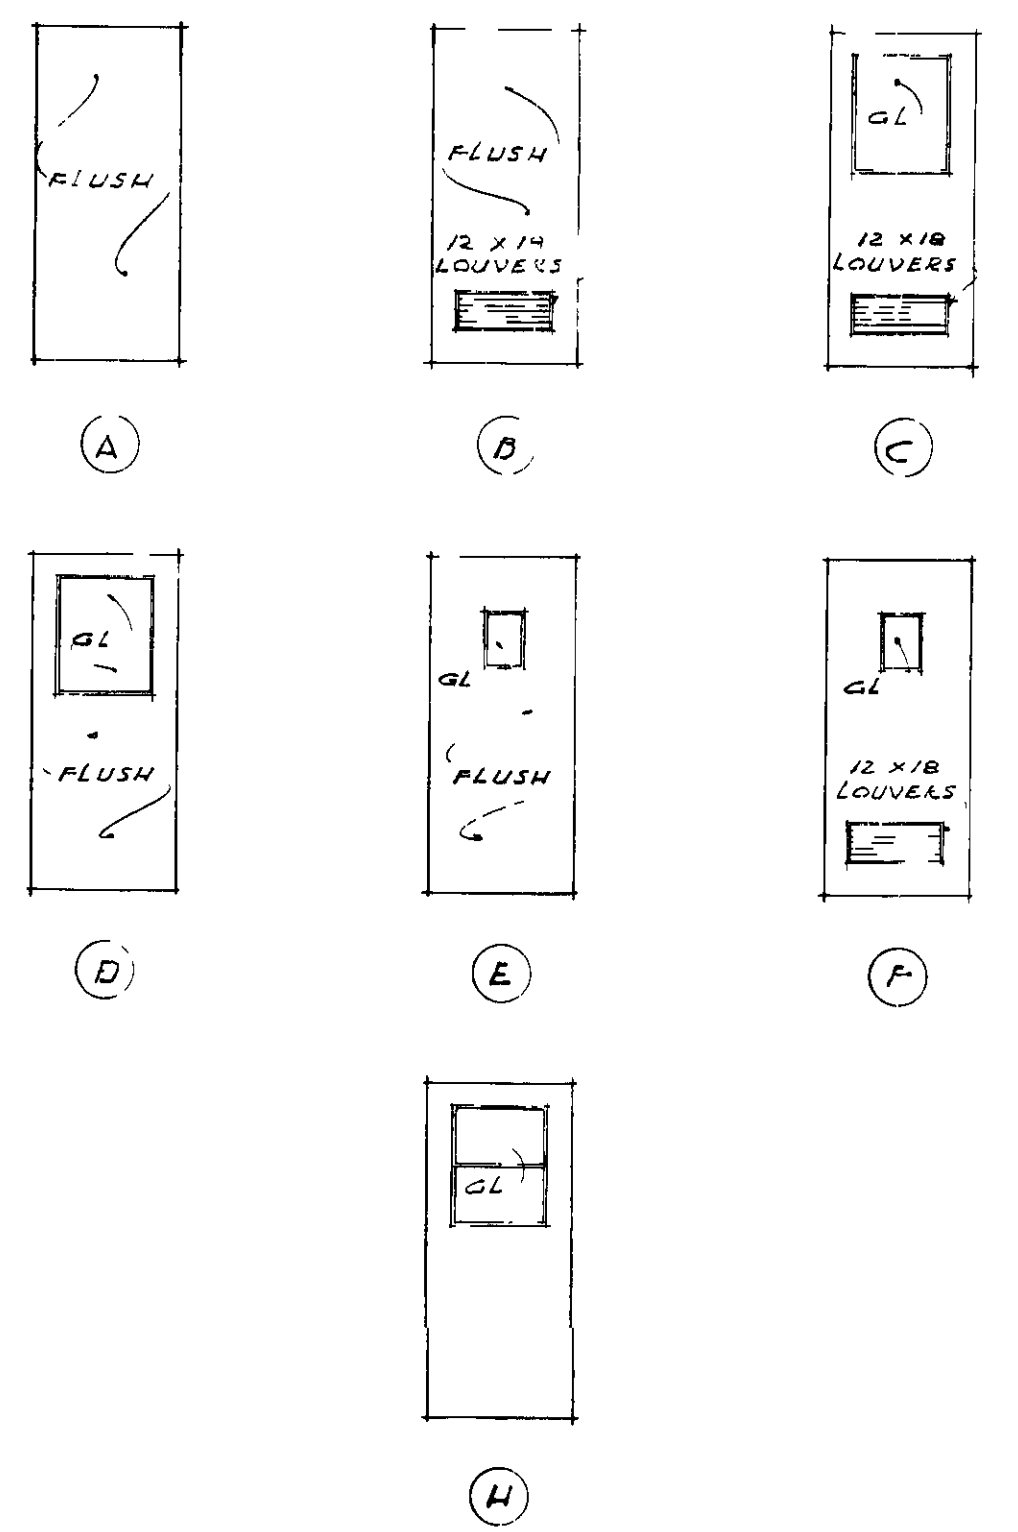

Small rectangular stamp with text: 'REVISIONS', 'DATE', 'BY', 'AUTHORITY'. Includes handwritten entries.

CLASSIFICATION CHANGED TO Unclassified

By Authority of: [Signature] Date: 8/2/97. Includes project name 'Dispensary' and revision details.

BT Images, Inc 0000001

REVIEWED FOR CLASSIFICATION RLH 06/05/2014 UNCLASSIFIED

Table with columns: REV NO, DATE, DESCRIPTION, ISSUED FOR. Lists revisions from 1 to 12, including dates and descriptions like 'AS BUILT' and 'REVISION REQUEST NO 1006 A'.

Form with fields: UNITED STATES ATOMIC ENERGY COMMISSION, SMITH, HINCHMAN & GRYLLS, INC ARCHITECTS & ENGINEERS, DRAWING TITLE: SCHEDULES, DRAWING NO: 8768, PROJECT: 10" PLANT, BUILDING: DISPENSARY C-102, SHEET: B3-2-A.

MICROFILMED