


NOTE: SUPPLY AND RETURN PIPE LINES SHALL BE INSTALLED AT SAME ELEVATIONS, EXCEPT AS NOTED IN DETAILS.

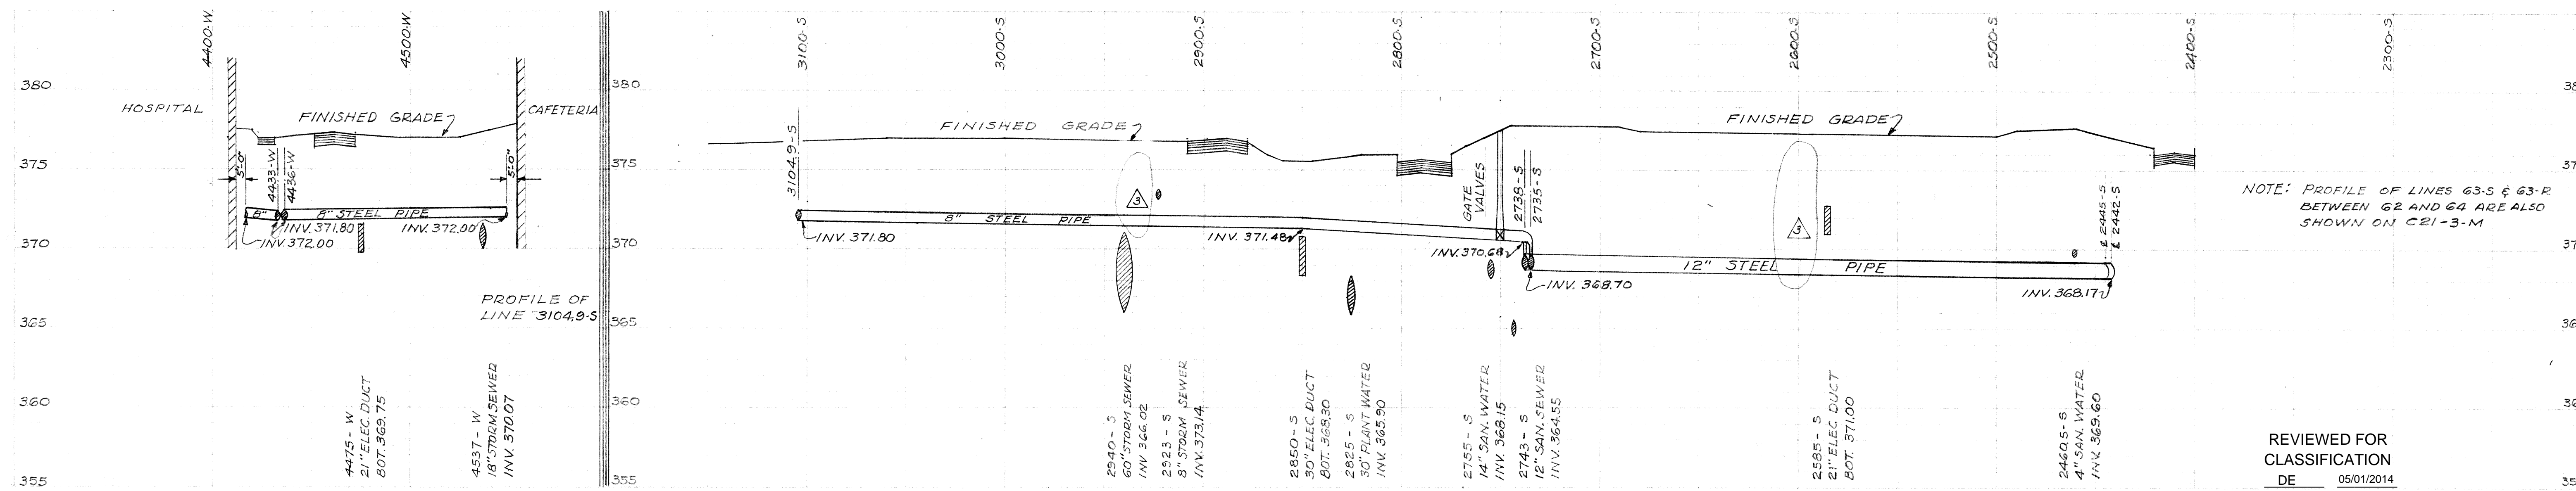

NOTE: PROFILE OF LINES 63-S & 63-R BETWEEN 62 AND 64 ARE ALSO SHOWN ON C21-3-M

REVIEWED FOR CLASSIFICATION  
 DE 05/01/2014  
 Initials Date  
 UNCLASSIFIED

Unclassified  
 CLASSIFICATION CHANGED TO UNCLASSIFIED  
 AUTHORITY: 10 CFR 101.116  
 DATE: 05-01-2014  
 BY: [Signature]  
 FOR: [Signature]

1ST REVIEWER	DATE	2ND REVIEWER	DATE
[Signature]	05/01/2014	[Signature]	05/01/2014

BT Images, Inc.  
00001584

REV. NO.	DATE	ISSUED FOR	BY	APP. DATE
4	8-18-53	AS BUILT		8-18-53
3	8-7-52	DEVIATION REQUEST #430-M		
2	10-16-51	CONSTRUCTION	"B"	10-5-51
1	5-21-51	APPROVAL	"A"	

UNITED STATES  
 ATOMIC ENERGY COMMISSION  
 SMITH, HINCHMAN & GRYLLES, INC.  
 ARCHITECTS & ENGINEERS  
 DETROIT 26, MICHIGAN

PLAN & PROFILE  
 LINES 63 & 65

SCALES	DRAWING APPROVED-DATE	DRAWING APPROVED-DATE	DRAWING APPROVED-DATE
PLAN 1"=40'	9-22-51	10-5-51	10-5-51
PROFILE HOR 1"=40'			
VER 1"=5'			
IN CHARGE	DATE	CHECKED	DATE
AGM	9/22/51	R.S.Y.	10/5/51
PROJECT	"C" PLANT		
	CHILLED WATER		C21-4-M