
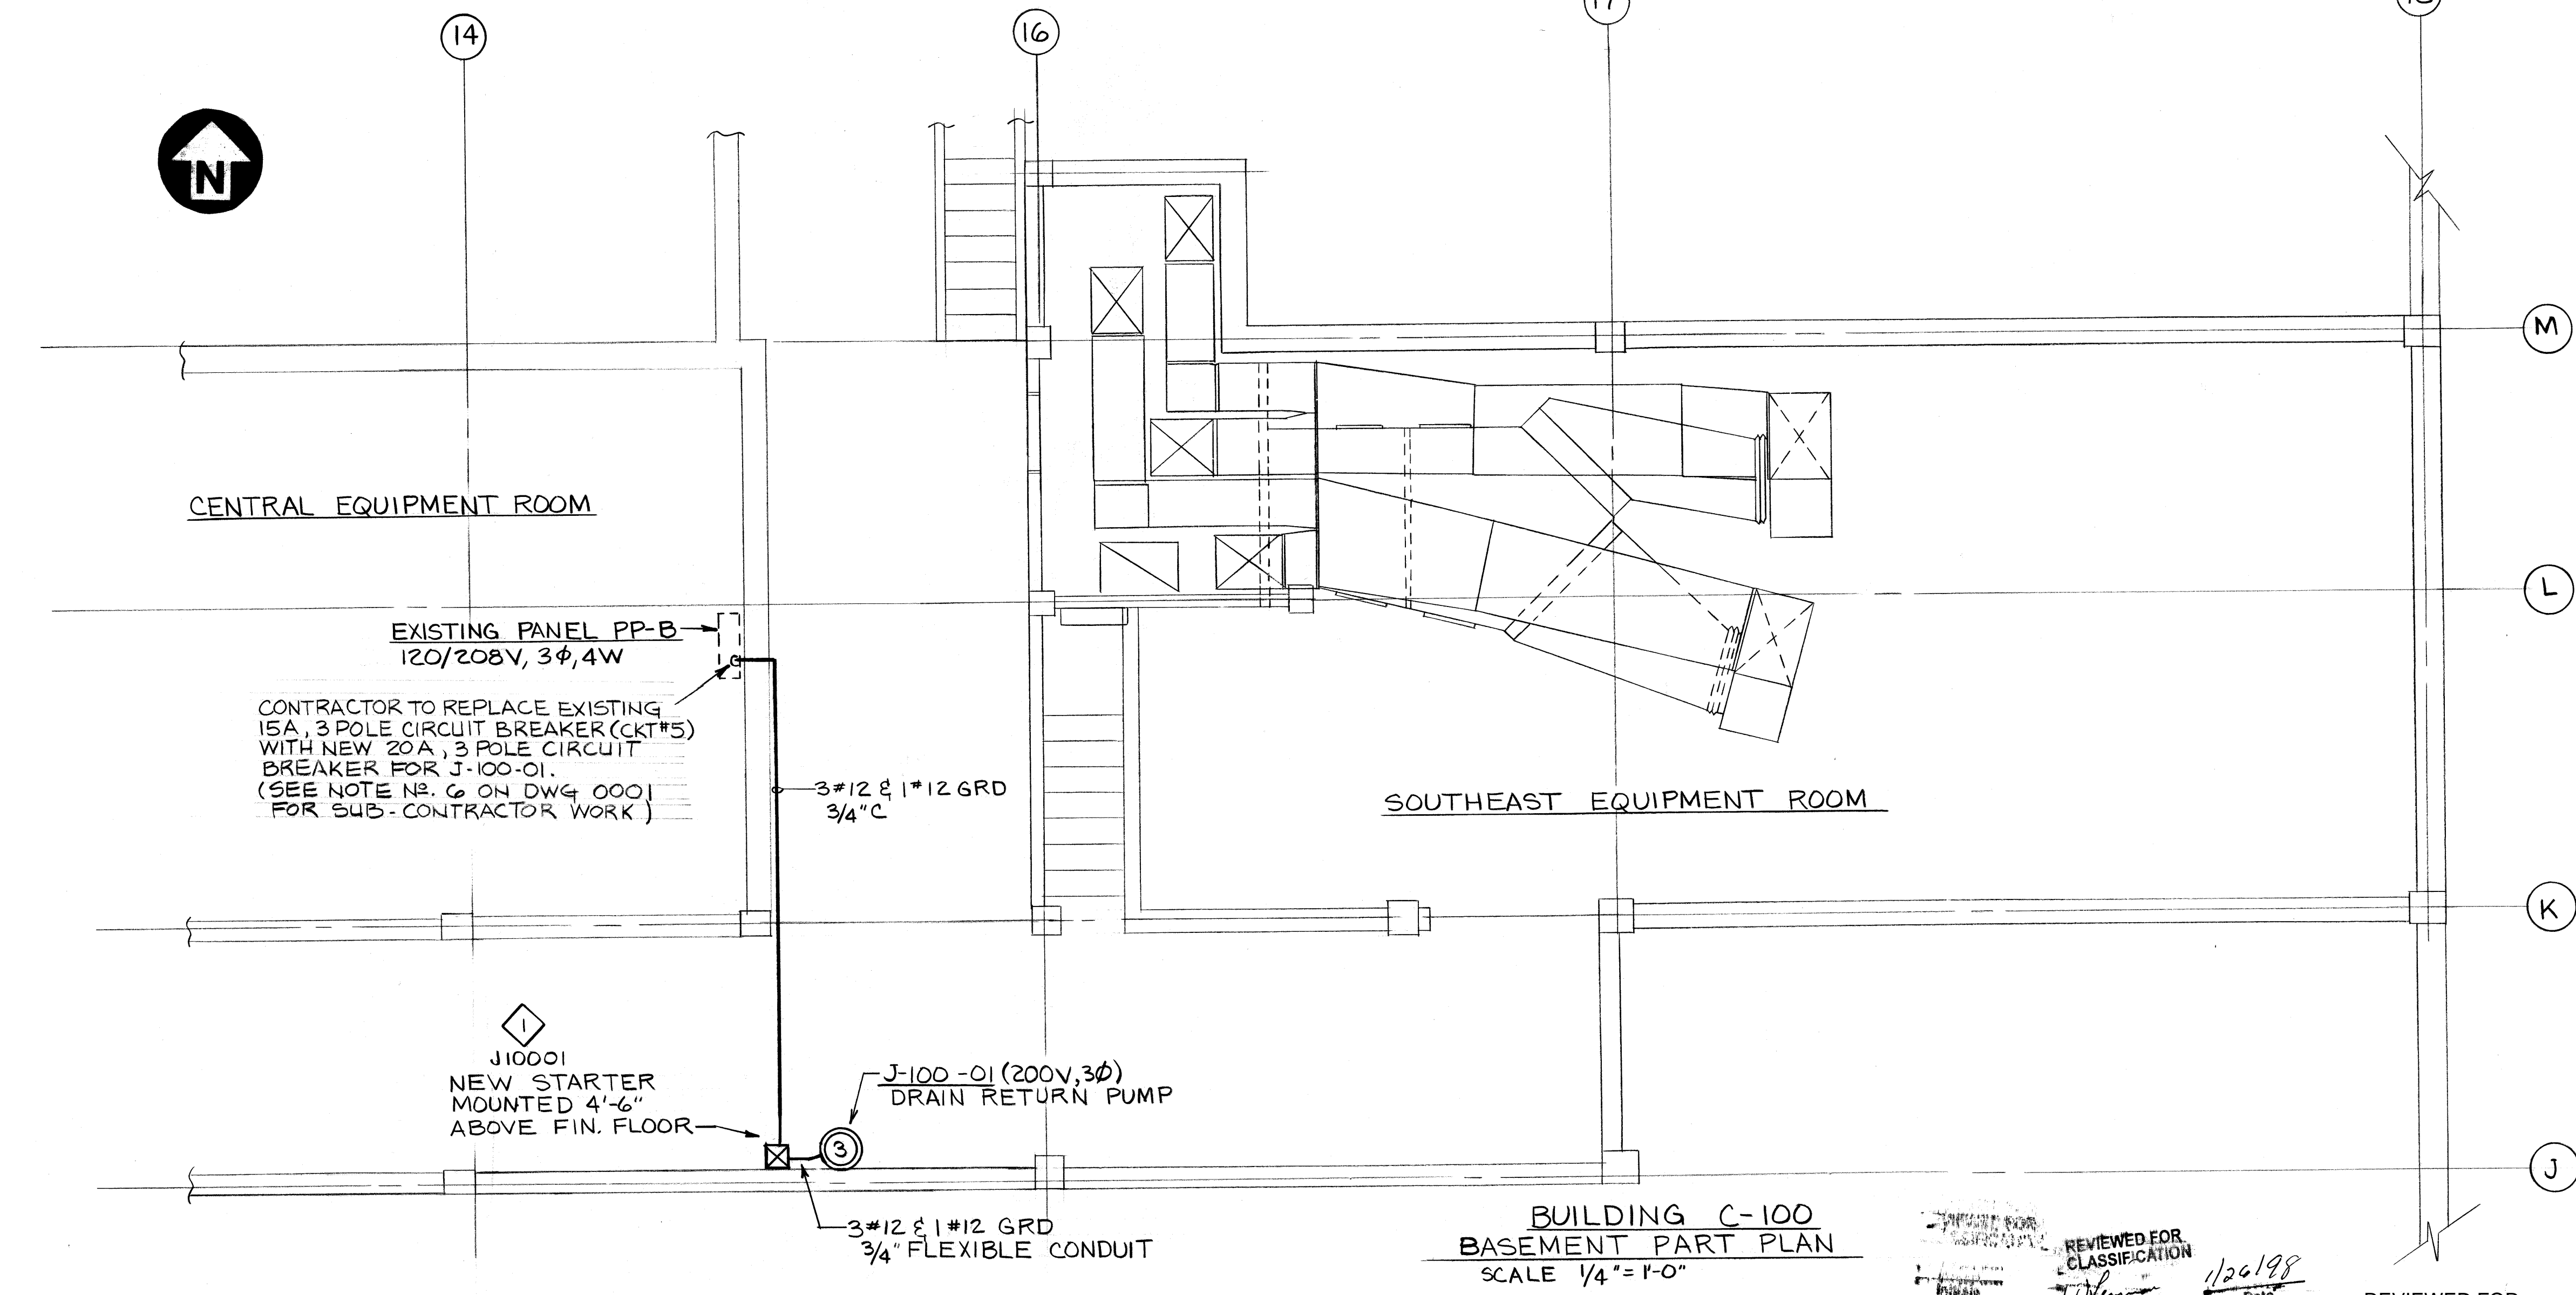
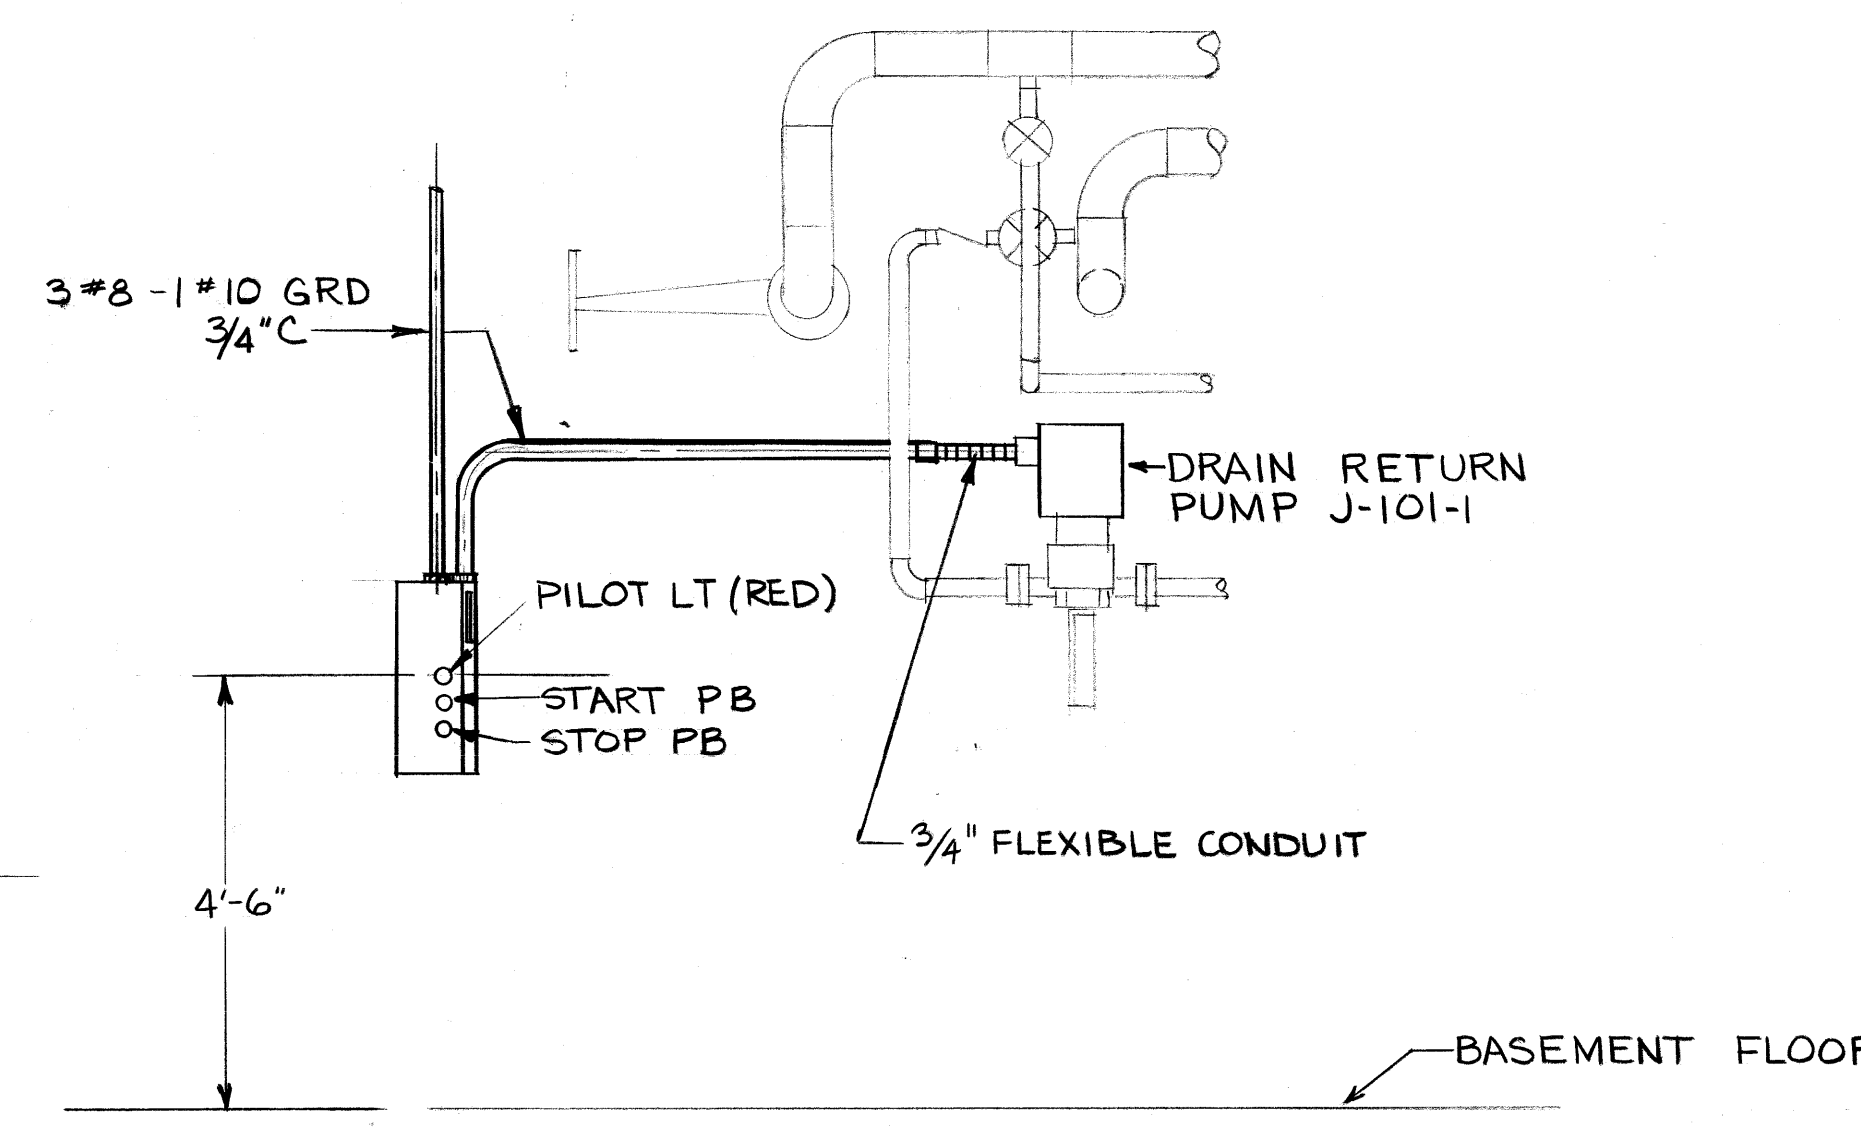




Unclassified

NOTES

- 1. GENERAL NOTES & LEGEND ON DWG. ESE-14951-0001
- 2. ELEMENTARY DIAGRAM DWG ESE-14951-0016

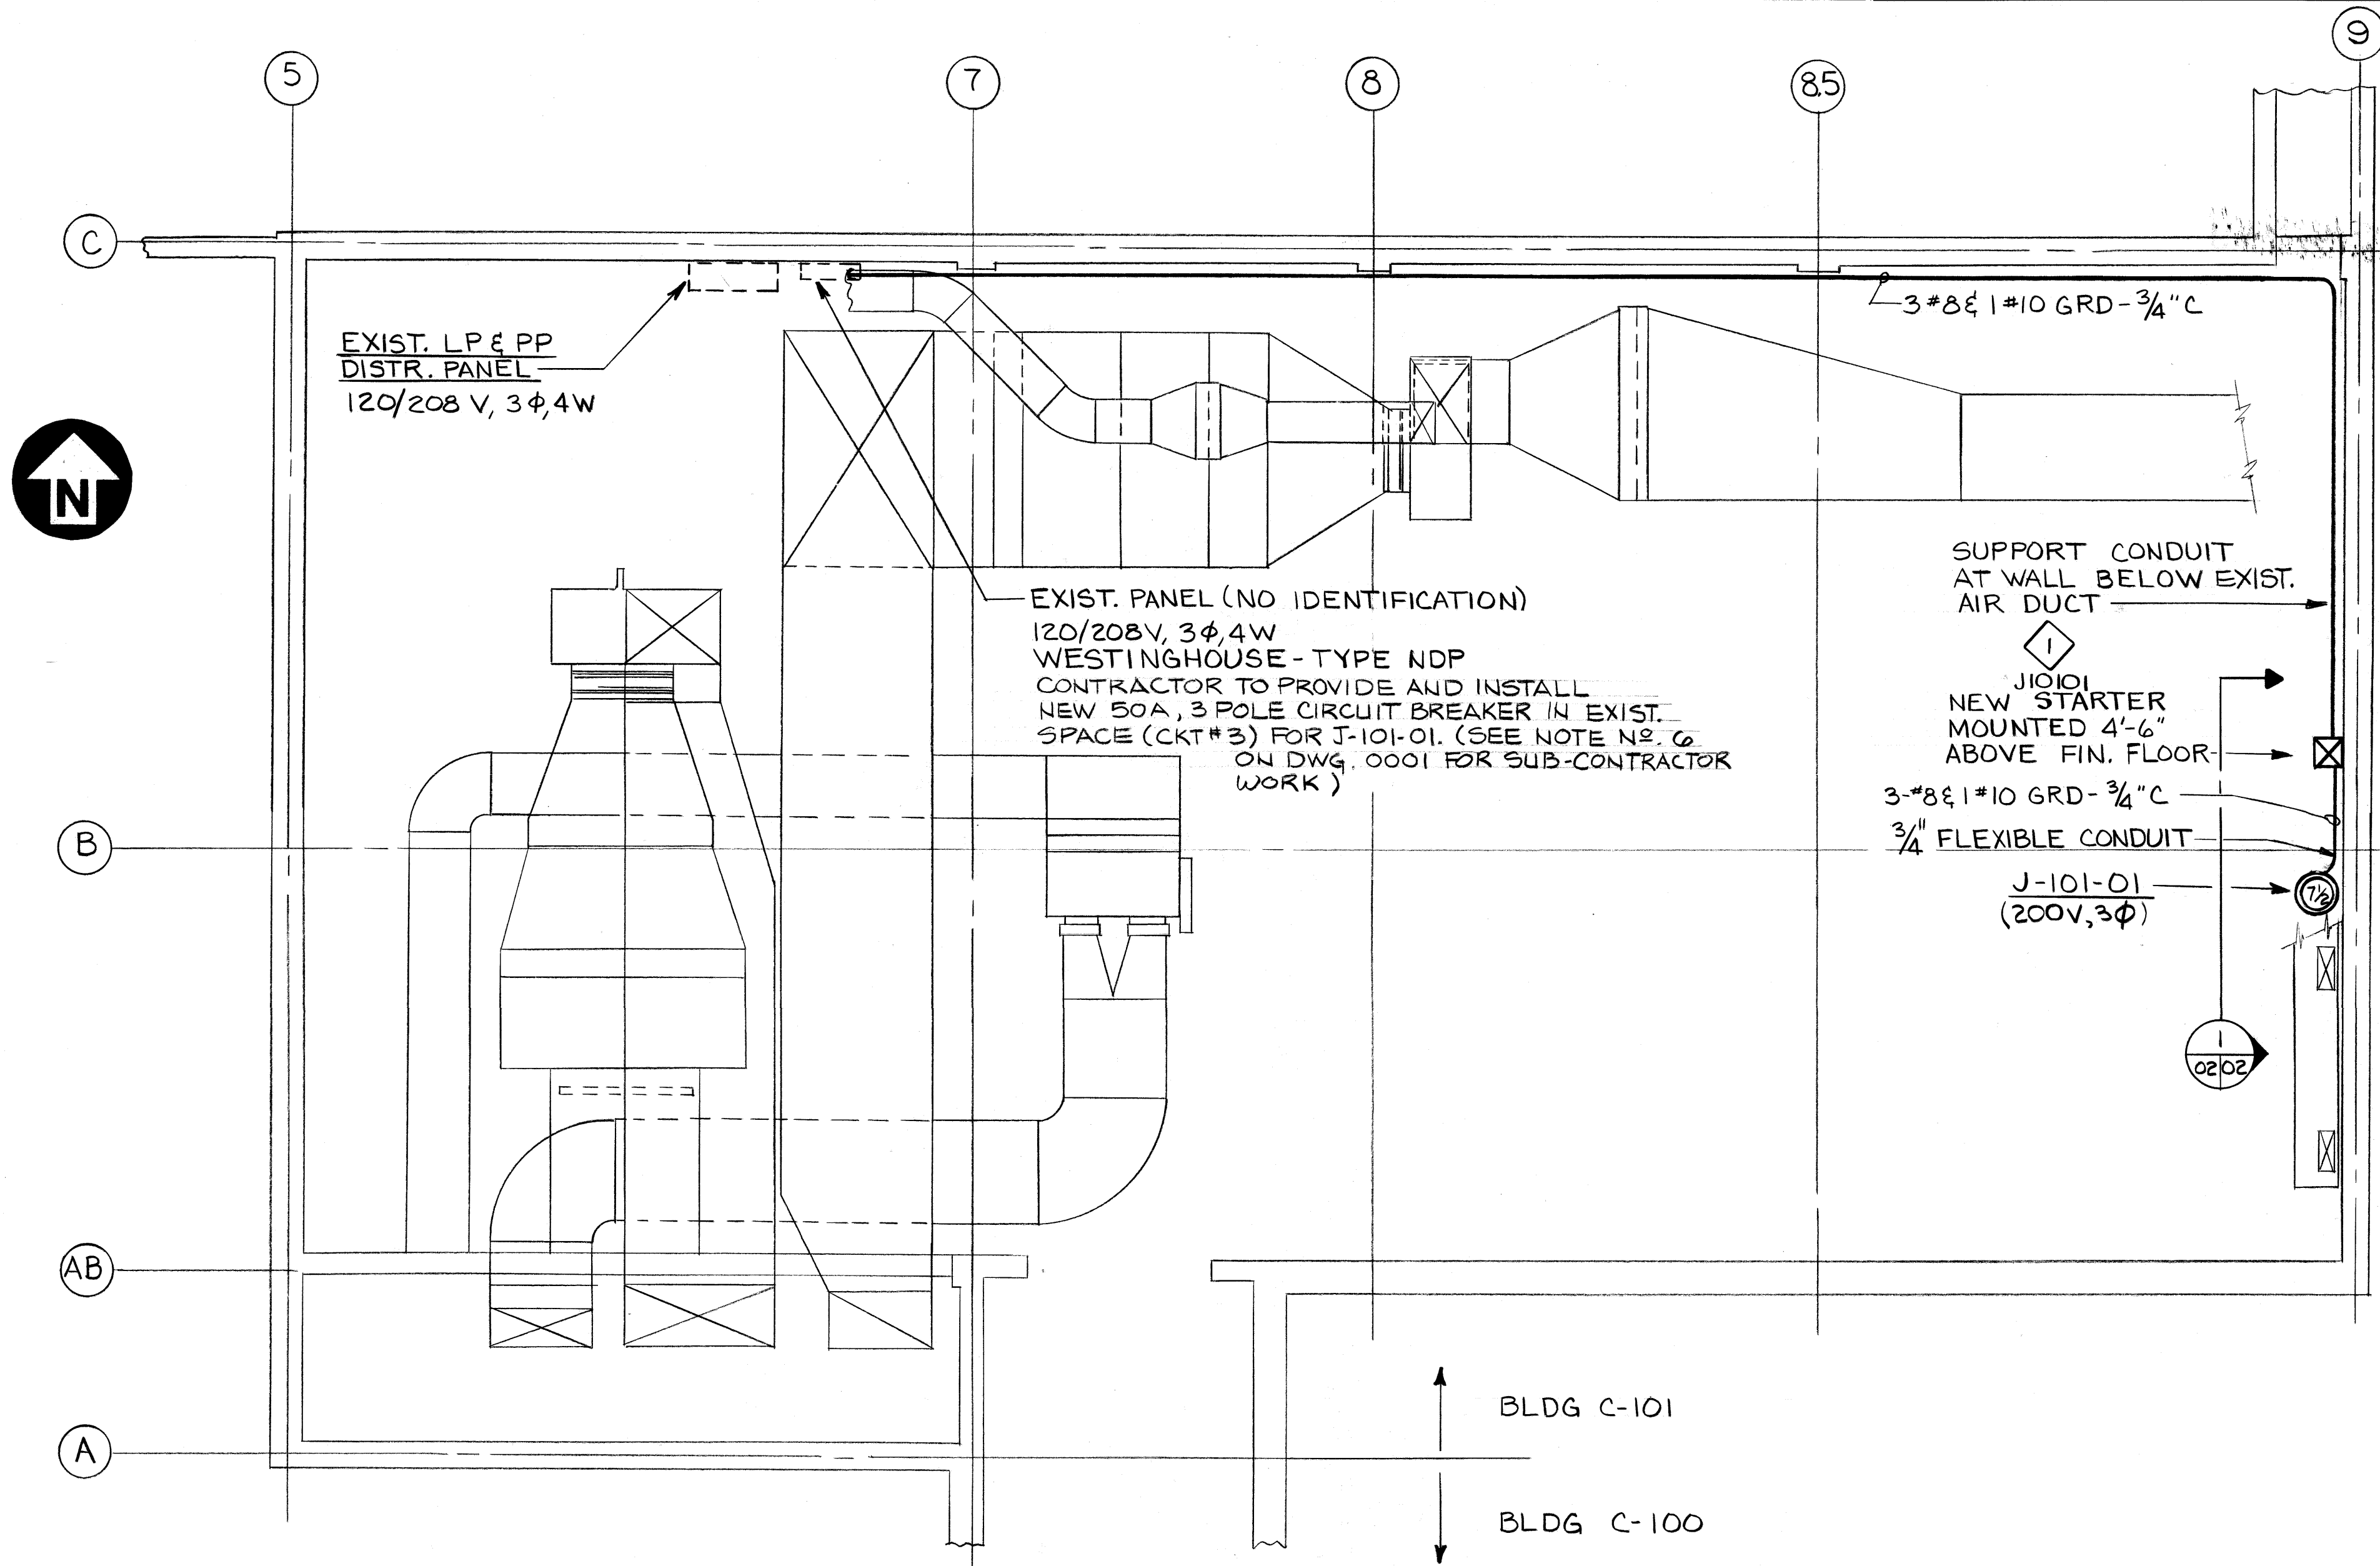



GRAPHIC SCALES

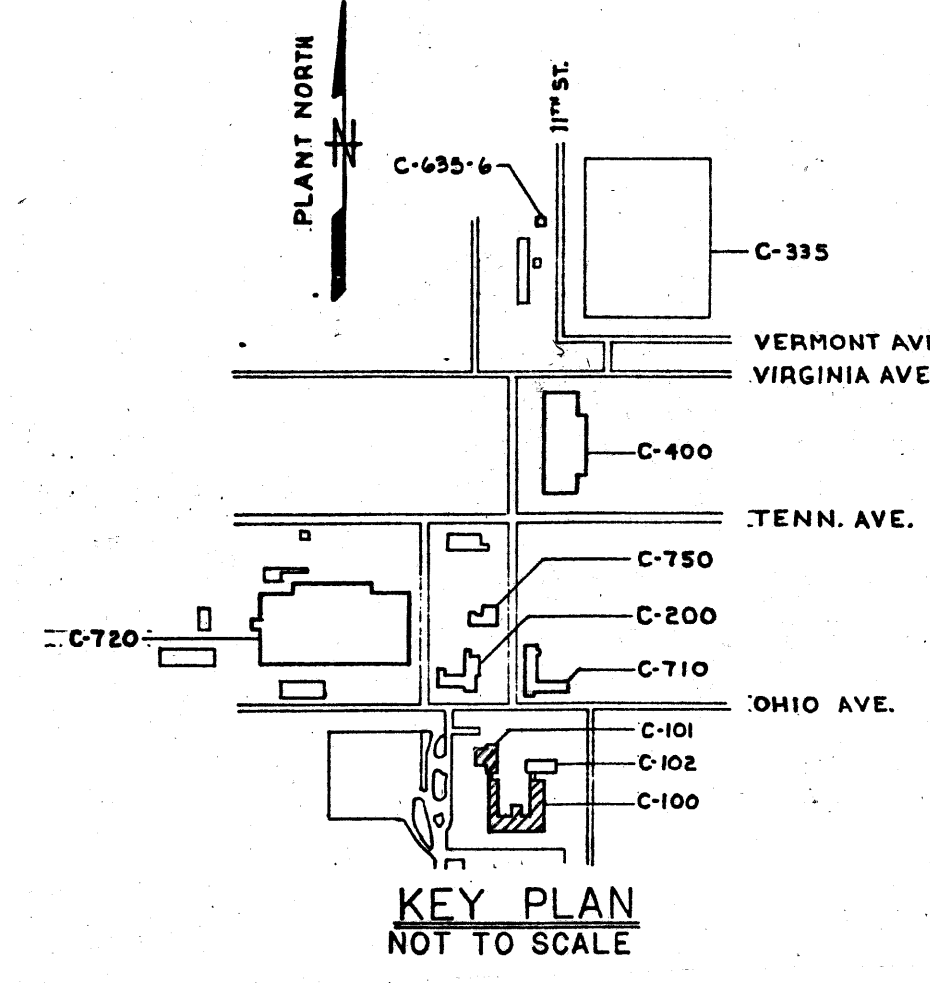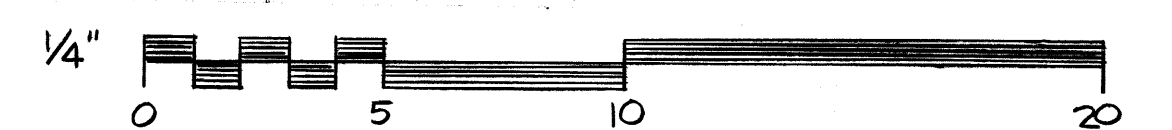

REVIEWED FOR  
CLASSIFICATION  
1/20/198  
UNCLASSIFIED

REVIEWED FOR  
CLASSIFICATION  
KW 06/13/2014  
Initials Date  
UNCLASSIFIED

BT Images, Inc.  
00021552

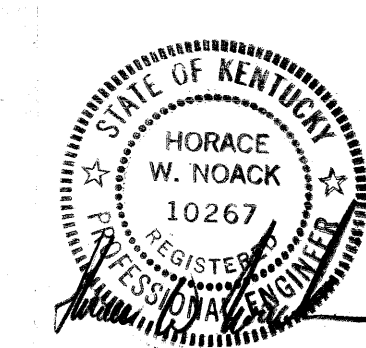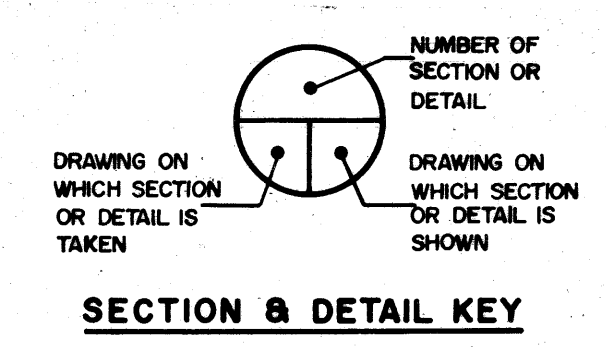

1 AS-BUILT		12 ML	1/1/18
0 CERTIFIED FOR CONSTRUCTION		1/1/18	2/27/19
REV. NO.	ISSUE PURPOSE (P#E-C-6279)	A.S.	OPERATOR
<b>UNITED STATES DEPARTMENT OF ENERGY</b>			
<b>A. M. KINNEY, INC.</b>			
DOE CONTRACT NO. EW79C-05-5886 A/E PROJECT NO. 02436			
<b>ELECTRICAL</b>			
<b>BUILDING C-100 &amp; C-101</b>			
<b>EQUIPMENT ROOM PLANS</b>			
SUBMITTED - DATE	APPROVAL RECOMMENDED - DATE	DRAWING APPROVED - DATE	
1/1/18	2-4-19	3/27/19	
ARCHITECT/ENGINEER	DATE	CHECKED	DATE
J. KOERNER	2-4-19	R.M. LANGDON	2-4-19
PLANT OPERATOR	DATE	DOE ENGINEER	DATE
1	48	H.W. NOACK	2-4-19
DRAWING NUMBER		REV. NO.	
ESE-14951-0002		1	

MICROFILMED