



**PLAN**  
SPRINKLER SYS MODIFICATION  
SCALE 1/2" = 1'-0"


Unclassified

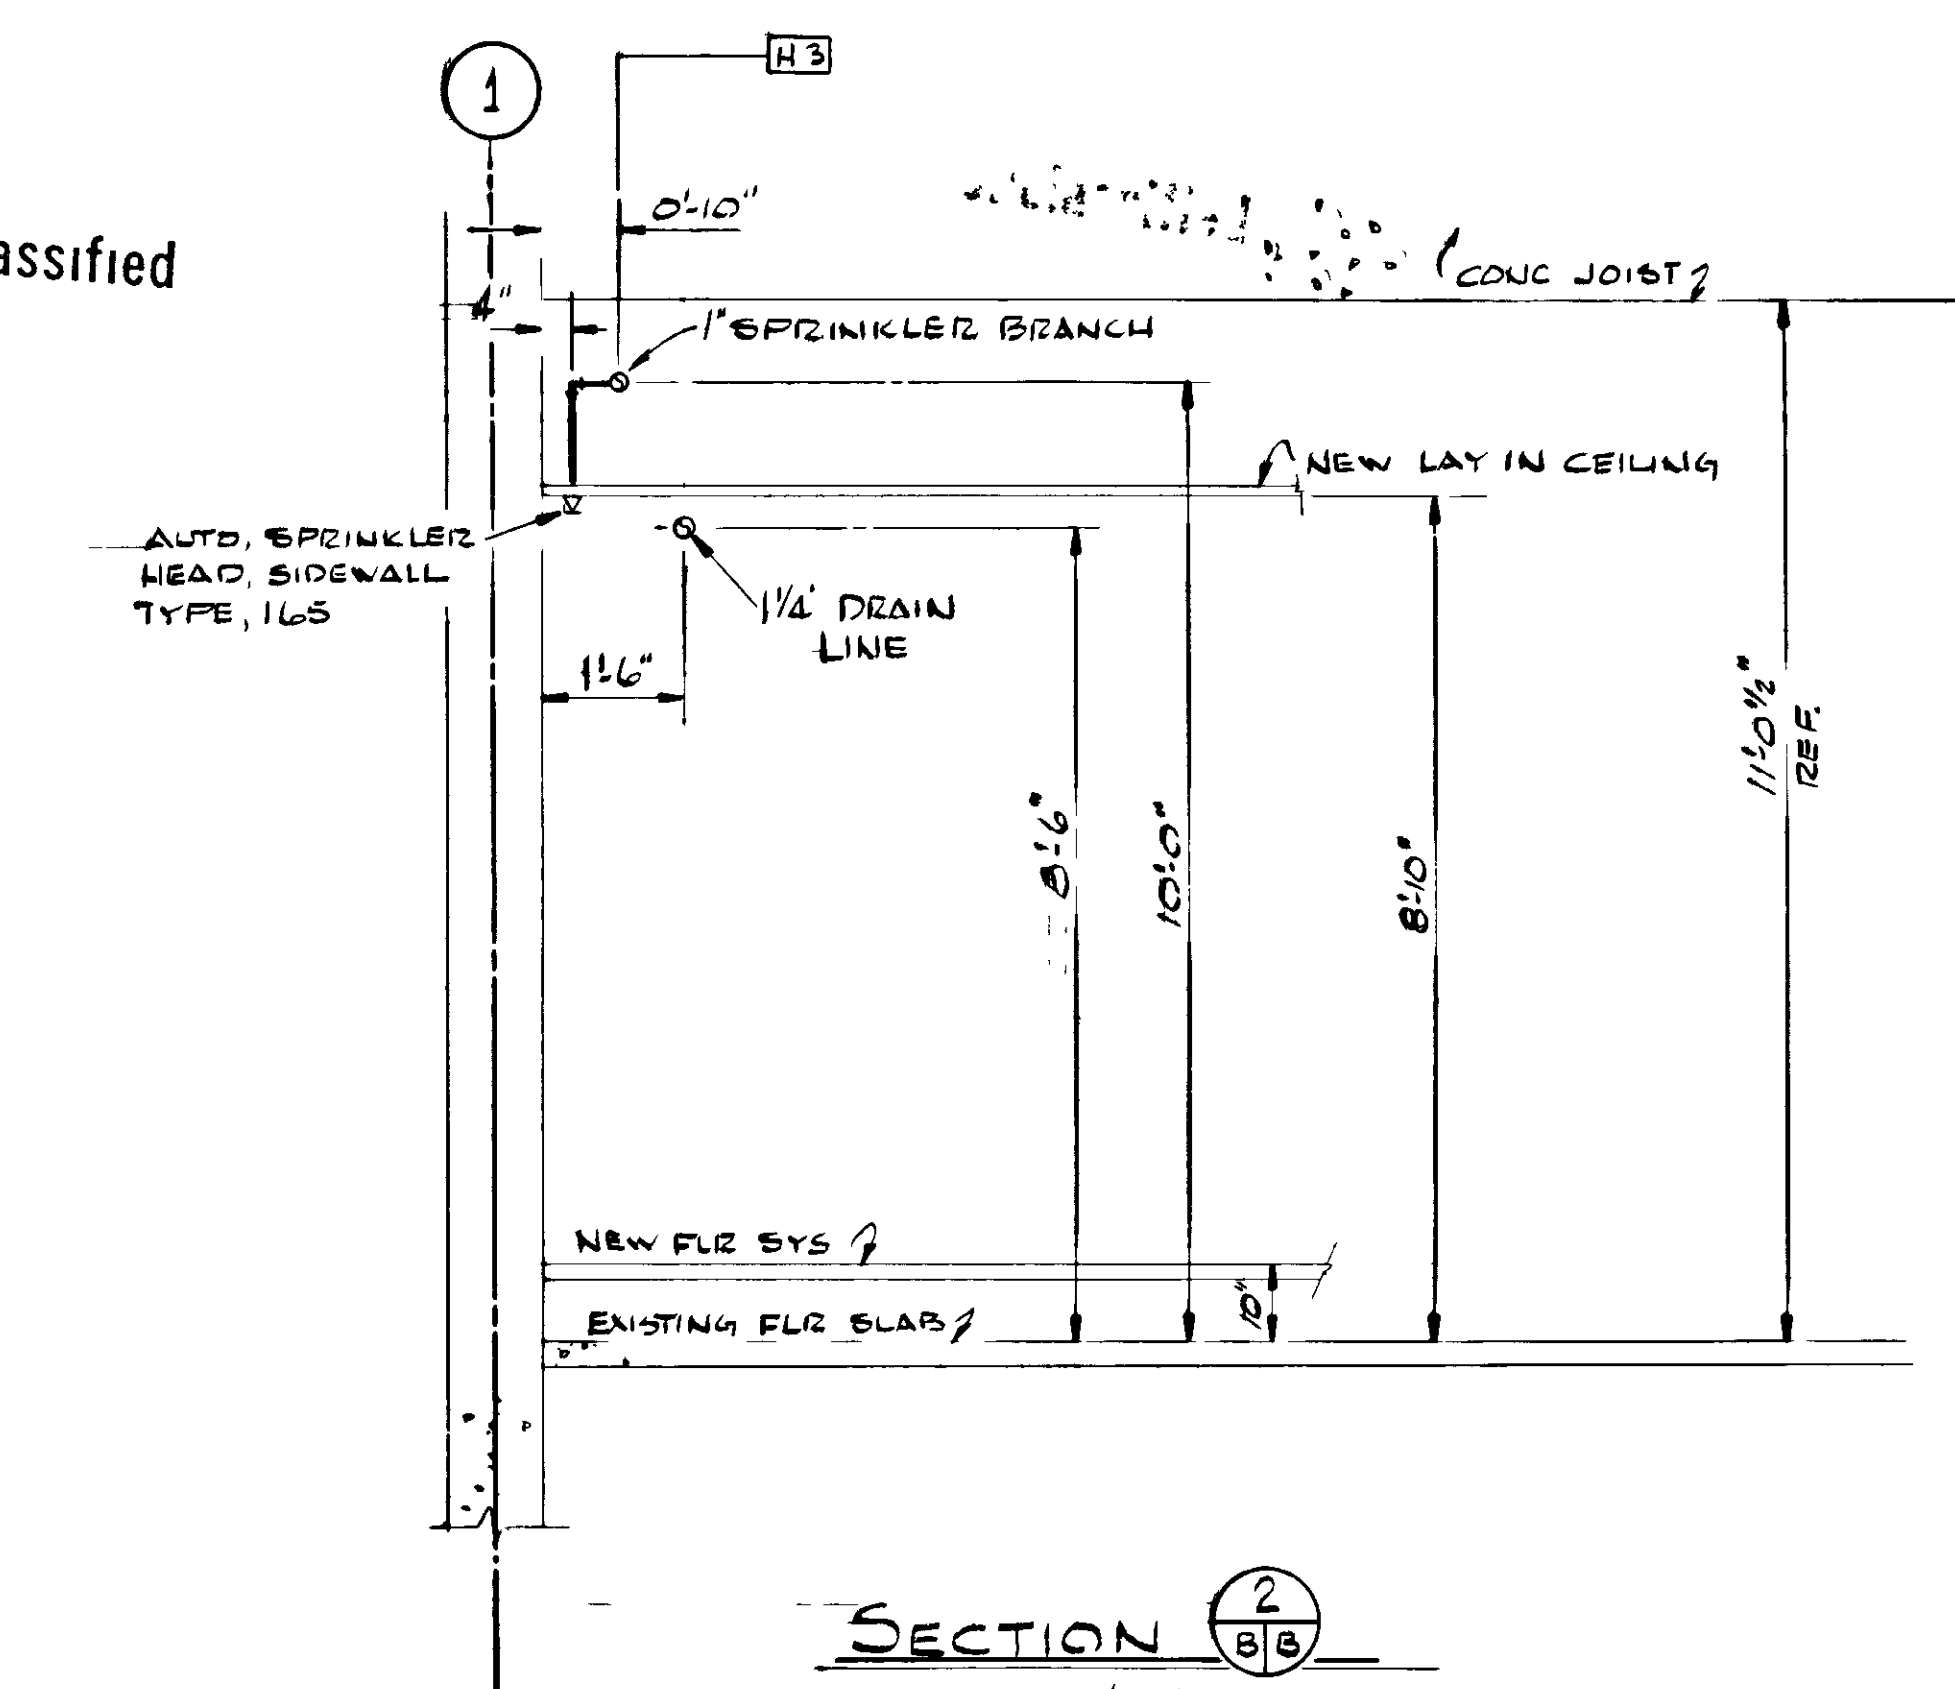

**SECTION 2 (2/8)**  
SCALE 1/2" = 1'-0"

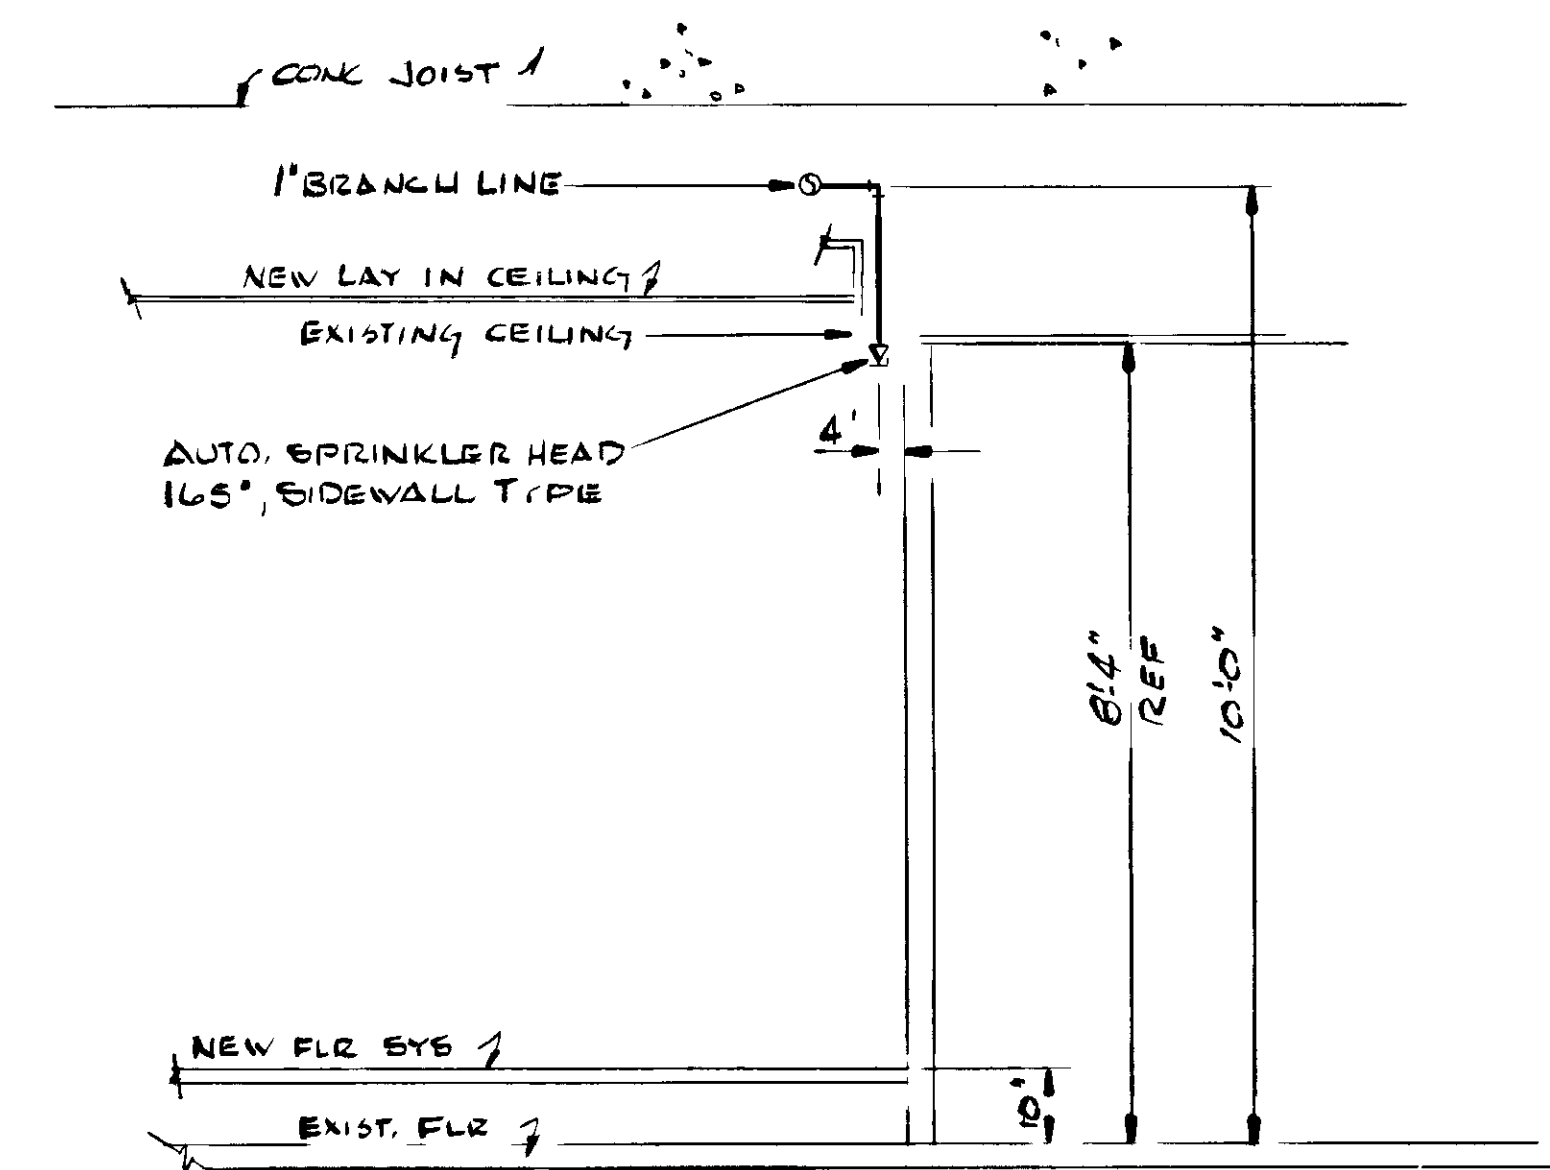

**SECTION 3 (3/8)**  
SCALE 1/2" = 1'-0"

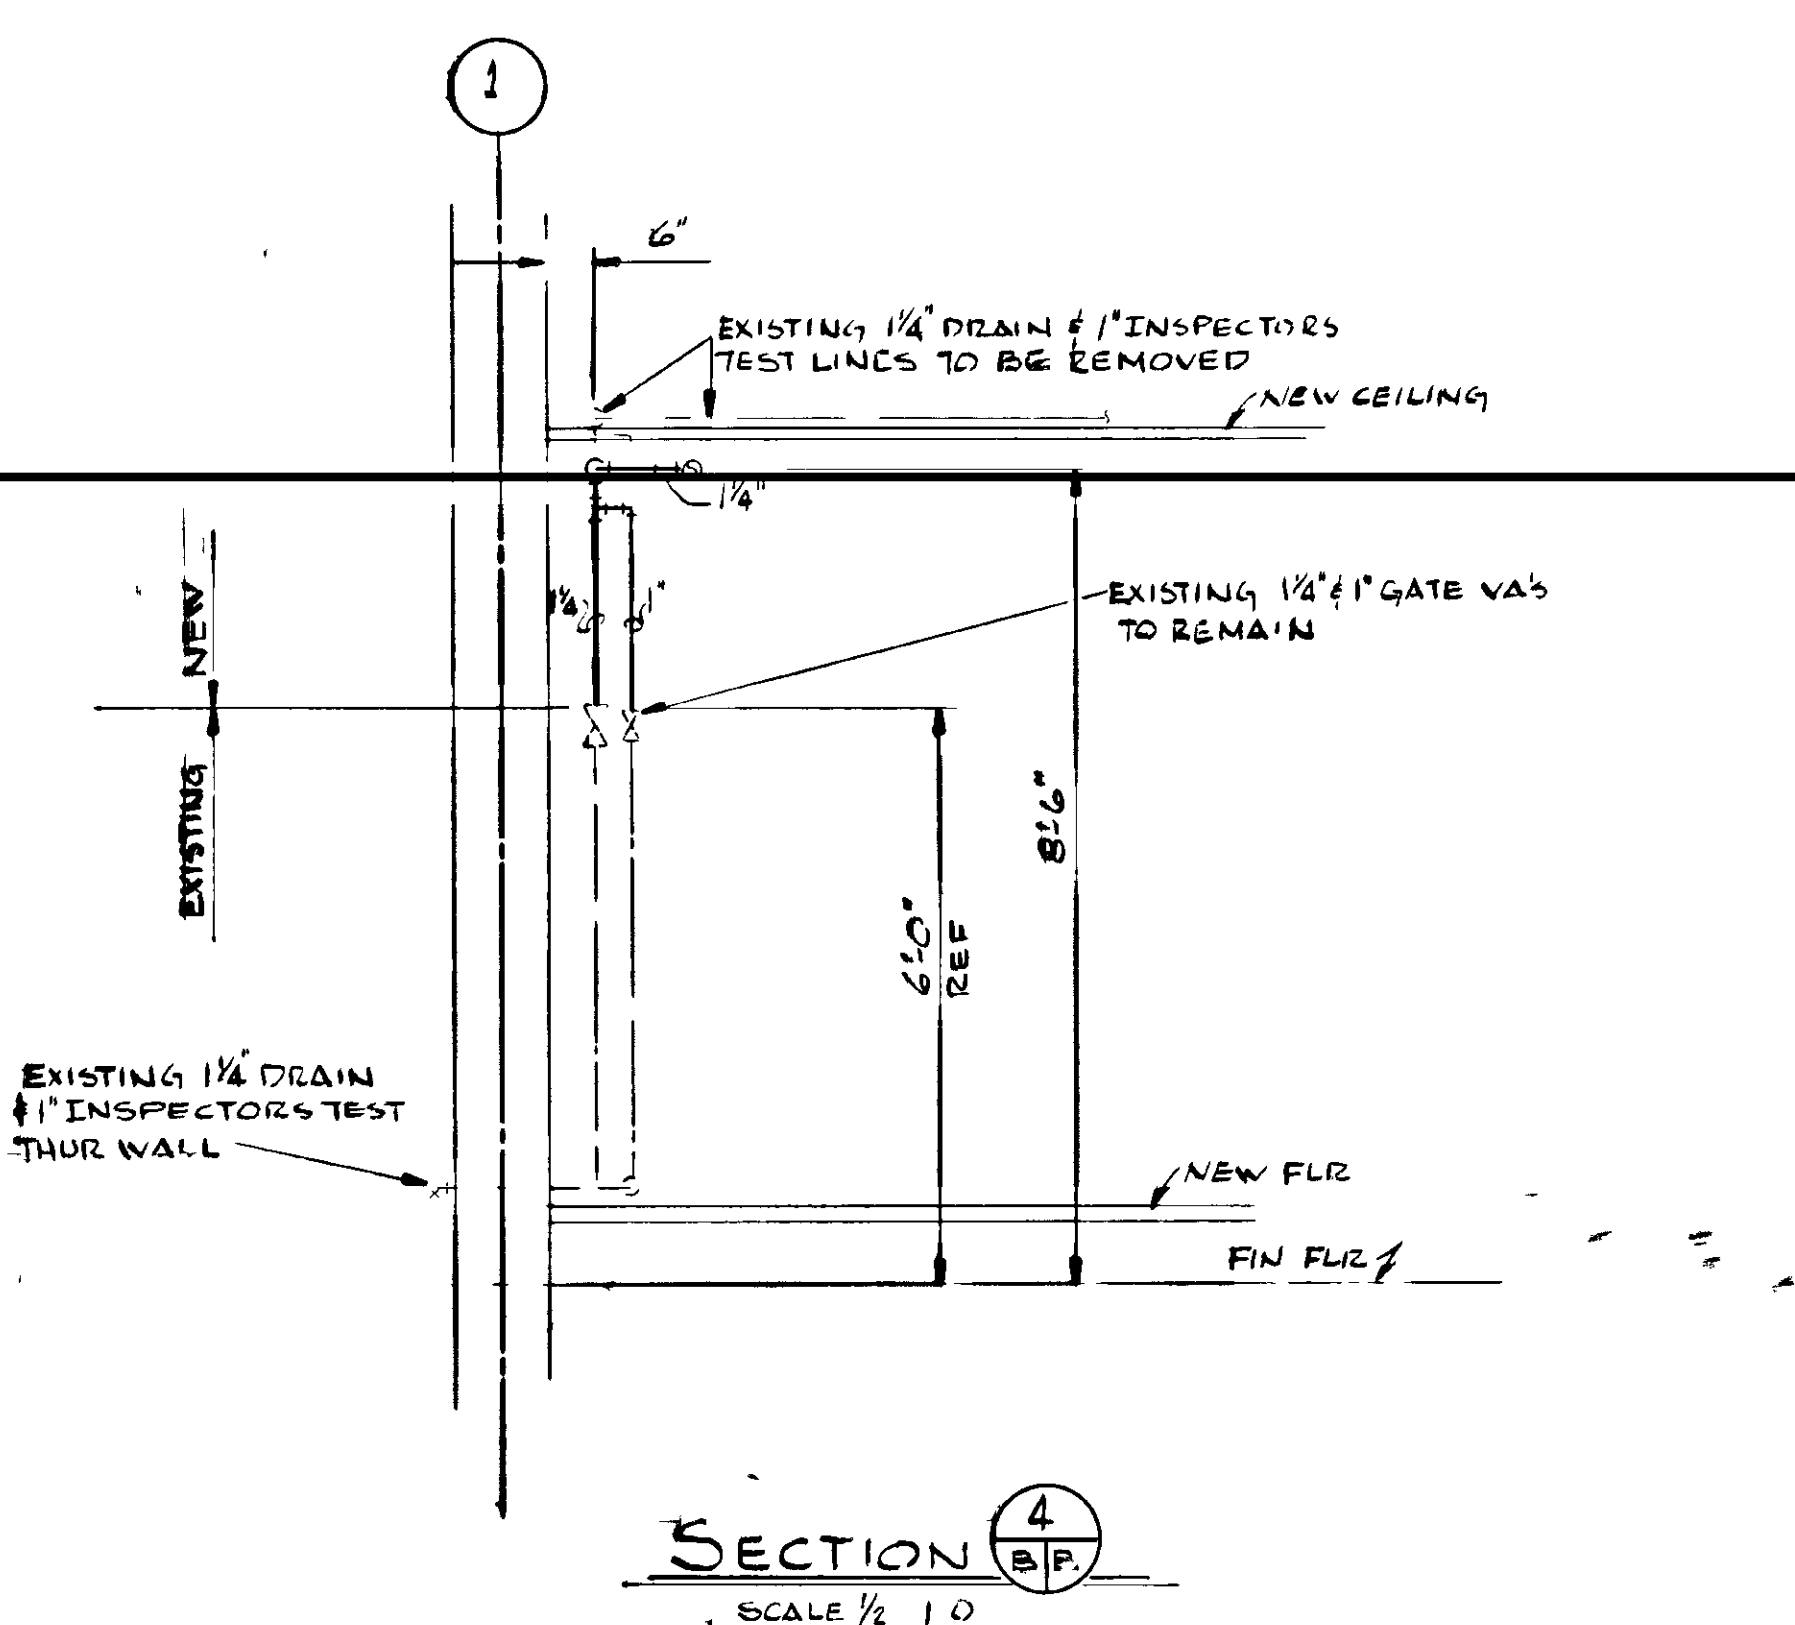

**SECTION 4 (4/8)**  
SCALE 1/2" = 1'-0"

**LEGEND:**

- DENOTES 1/2" NPT SIDEWALL AUTO SPRINKLER HEADS (4)
- DENOTES 1/4" AUX. DRAIN LINE EXPOSED UNDER NEW CEILING.
- DENOTES EXISTING SPRINKLER LINES TO BE DEMOLISHED
- DENOTES EXISTING SPRINKLER LINES TO REMAIN
- DENOTES HANGER LOCATION

REVIEWED FOR  
CLASSIFICATION  
05/13/2014

Initials Date  
UNCLASSIFIED

REVIEWED FOR  
CLASSIFICATION  
1/20/198  
Date  
UNCLASSIFIED

BT Images, Inc  
00042918

**NOTES:**

1. ALL WORK SHALL BE DONE IN STRICT ACCORDANCE WITH THE SUBCONTRACT SPECIFICATIONS
2. AUTOMATIC SPRINKLER HEADS SHALL BE 1/2" NPT SIDEWALL TYPE W/ CHROME ESCUTCHEON PLATE - 4 TOTAL
3. ALL HANGERS & SUPPORTS SHALL BE AS PER NFPA # 13
4. CHROME WALL PLATES SHALL BE INSTALLED AT ALL WALL PENETRATIONS
5. SEE PLAN FOR EXISTING SYSTEM DEMOLITION
6. H-3 HANGER TO CONSIST OF GRINNELL FIG. 260 CLEVIS, 3/8" ROD AND 3/8" CONC ANCHOR

NO REPRESENTATION OR WARRANTY EXPRESSED OR IMPLIED IS MADE THAT THE USE OR DISCLOSURE OF ANY INFORMATION, APPARATUS, METHOD OR PROCESS DISCLOSED IN THESE DRAWINGS MAY NOT INFRINGE PRIVATE RIGHTS OF OTHERS. NO LIABILITY IS ASSUMED WITH RESPECT TO THE USE OF OR FOR DAMAGES RESULTING FROM THE USE OF ANY INFORMATION, APPARATUS, METHOD OR PROCESS DISCLOSED IN THESE DRAWINGS. THE DRAWINGS ARE BEING MADE AVAILABLE FOR INFORMATION TO BIDDER AND ARE NOT TO BE USED FOR OTHER PURPOSES. AND ARE TO BE RETURNED UPON REQUEST OF THE FORWARDING CONTRACTOR.

SECTION NUMBER OR DETAIL LETTER	
SHEET WHERE DETAIL OR SECTION IS CUT	
SHEET WHERE DETAIL OR SECTION IS SHOWN	

BY	DATE	SECT	REV	DESCRIPTION
MAB	11/18/82	AH	0	CFC APPROVAL TITLE II
AS BUILT				REVISION OR ISSUE PURPOSE

MLO	MLB	MLC	MLD	MLE	MLF	MLG	MLH	MLI	MLJ	MLK	MLL	MLM	MLN	MLO	MLP	MLQ	MLR	MLS	MLT	MLU	MLV	MLW	MLX	MLY	MLZ
BY	CHK	REQ	SECT	DEPT	DATE	RE	REQ	DATE	USO	DATE	DOE	DATE	QE	CA	EC	EE	MD	IE	MA	CP	SE	CE			
REVISION OR ISSUE APPROVALS																									

TOLERANCES UNLESS OTHERWISE SPECIFIED	DES	DRW	CHK	SECT	DEPT & PLANT	REQUESTER	FIRE / SECURITY	SAFETY	IND HYGIENE
FRACTIONS ±	M.L. BOREN	M.L. BOREN	D. BELLOTT	D. H. H. H.	W. B. B. B.	A. B. B. B.	R. W. W. W.	R. W. W. W.	R. W. W. W.
XX DECIMALS ±									
XXX DECIMALS ±									
ANGLES									
BREAK SHARP EDGES									
MAX FINISH									
DOE									
DRAWING APPROVALS									

UNION CARBIDE CORPORATION • NUCLEAR DIVISION									
Supplemental Air Conditioning									
C-100 COMPUTER ROOM									
PLAN & SECTIONS									
SPRINKLER SYS MOD.									
PLANT	BLDG	FL	SHT	OF	CLASS	REV	DATE		
3	P	F	E	F	PGDP	C 100	1st	2	
SCALE AS NOTED									
ID	MSE16061								