

Unclassified

INDEX OF DRAWINGS


INDEX OF DRAWINGS

ARCHITECTURAL	
NO	TITLE
B-1-A	PLOT PLAN & INDEX
B-2-A	SCHEDULE OF INTERIOR FINISHES
B-3-A	DOOR SCHEDULE
B-4-A	BASISMENTS & TUNNELS
B-5-A	FIRST FLOOR PLAN
B-6-A	SECOND FLOOR PLAN
B-7-A	ROOF PLAN & DETAILS
B-8-A	EXTERIOR ELEVATIONS
B-9-A	EXTERIOR ELEVATIONS & DETAILS
B-10-A	SECTIONS & DETAILS
B-11-A	SECTIONS & DETAILS
B-12-A	SECTIONS & DETAILS
B-13-A	SECTIONS & DETAILS
B-14-A	WINDOW & DOOR DETAILS
B-15-A	ROOM DETAILS
B-16-A	MISCELLANEOUS DETAILS
B-17-A	TOILET ROOM DETAILS
B-18-A	STAIR DETAILS
B-19-A	ELEVATOR & VAULT DETAILS
B-20-A	BASISMENTS & TUNNELS
B-21-A	BASISMENTS & TUNNELS
B-22-A	MAIN WING FIRST FLOOR PLAN
B-23-A	MAIN WING SECOND FLOOR PLAN
B-24-A	EAST WING FLOOR PLAN
B-25-A	WEST WING FLOOR PLAN
B-26-A	CEILING PATTERN MAIN WING-FIRST FLOOR
B-27-A	CEILING PATTERN MAIN WING-SECOND FLOOR
B-28-A	CEILING PATTERN EAST WING-FIRST FLOOR
B-29-A	CEILING PATTERN WEST WING-FIRST FLOOR
B-30-A	MISCELLANEOUS DETAILS

MECHANICAL	
NO	TITLE
B-1-M	AIR CONDITIONING LAYOUT - FIRST FLOOR PLAN
B-2-M	AIR CONDITIONING LAYOUT - SECOND FLOOR PLAN
B-3-M	AIR CONDITIONING LAYOUT - TYPICAL DETAILS
B-4-M	AIR CONDITIONING LAYOUT - SOUTHWEST EQUIPMENT ROOM
B-5-M	AIR CONDITIONING LAYOUT - NORTHWEST EQUIPMENT ROOM
B-6-M	AIR CONDITIONING LAYOUT - SOUTHEAST EQUIPMENT ROOM
B-7-M	AIR CONDITIONING LAYOUT - NORTHEAST EQUIPMENT ROOM
B-8-M	AIR CONDITIONING LAYOUT - CENTRAL EQUIPMENT ROOM
B-9-M	PIPING LAYOUT - STEAM PRESSURE REDUCING STATION
B-10-M	PIPING LAYOUT - BASEMENT & TUNNELS - MAIN WING
B-11-M	PIPING LAYOUT - BASEMENT & TUNNELS - EAST & WEST WINGS
B-12-M	AIR CONDITIONING LAYOUT - MAIN WING - SECOND FLOOR
B-13-M	AIR CONDITIONING LAYOUT - MAIN WING - FIRST FLOOR
B-14-M	AIR CONDITIONING LAYOUT - WEST WING - FIRST FLOOR
B-15-M	AIR CONDITIONING LAYOUT - EAST WING - FIRST FLOOR
B-16-M	AIR CONDITIONING LAYOUT - CHILLED WATER PIPING ISOMETRICS
B-17-M	AIR CONDITIONING LAYOUT - STEAM CONNECTION ISOMETRICS
B-18-M	AIR CONDITIONING LAYOUT - MISCELLANEOUS SECTIONS
B-19-M	AIR CONDITIONING LAYOUT - TYPICAL CONTROL DIAGRAMS
B-20-M	AIR CONDITIONING LAYOUT - MISCELLANEOUS SECTIONS
B-21-M	VENTILATING SYSTEMS - TOILET ROOMS
B-22-M	VENTILATING SYSTEMS - TOILET ROOMS
B-23-M	VENTILATING SYSTEMS - EQUIPMENT ROOMS
B-24-M	VENTILATING SYSTEMS - EQUIPMENT ROOMS
B-25-M	
B-26-M	
B-27-M	
B-28-M	
B-29-M	
B-30-M	UNDERGROUND PLUMBING PLAN - MAIN WING
B-31-M	UNDERGROUND PLUMBING PLAN - EAST & WEST WINGS
B-32-M	BASEMENT PLUMBING PLAN - MAIN WING
B-33-M	BASEMENT PLUMBING PLAN - EAST & WEST WINGS
B-34-M	FIRST FLOOR PLUMBING PLAN
B-35-M	SECOND FLOOR PLUMBING PLAN
B-36-M	ROOF DRAINAGE PLAN
B-37-M	TOILET ROOM PLUMBING DETAILS
B-38-M	MISCELLANEOUS PLUMBING DETAILS

STRUCTURAL	
NO	TITLE
B-1-S	FOUNDATION PLAN - MAIN WING
B-2-S	FOUNDATION PLAN - EAST WING
B-3-S	FOUNDATION PLAN - WEST WING
B-4-S	BASEMENT WALL ELEVATIONS - AREAWAYS - MAIN WING
B-5-S	BASEMENT WALL ELEVATIONS - EAST WING
B-6-S	BASEMENT WALL ELEVATIONS - WEST WING
B-7-S	FIRST FLOOR FRAMING PLAN - MAIN WING
B-8-S	FIRST FLOOR FRAMING PLAN - EAST WING
B-9-S	FIRST FLOOR FRAMING PLAN - WEST WING
B-10-S	SECOND FLOOR FRAMING PLAN - MAIN WING
B-11-S	SECOND FLOOR FRAMING PLAN - EAST WING
B-12-S	SECOND FLOOR FRAMING PLAN - WEST WING
B-13-S	ROOF FRAMING PLAN - MAIN WING
B-14-S	COLUMN SCHEDULE
B-15-S	FRAMING PLANS & DETAILS OF BENTHOUSES

ELECTRICAL	
NO	TITLE
B-1-E	KEY PLAN
B-2-E	SCHEDULE - FIXTURES
B-3-E	SCHEDULES - PANELS - MOTORS - EQUIPMENT
B-4-E	PRIMARY DUCT - GROUNDING
B-5-E	TRANSFORMER ROOMS 1 AND 2
B-6-E	LIGHT - BASEMENT
B-7-E	LIGHT - FIRST FLOOR - CENTER
B-8-E	LIGHT - FIRST FLOOR - EAST WING
B-9-E	LIGHT - FIRST FLOOR - WEST WING
B-10-E	LIGHT - SECOND FLOOR
B-11-E	UNDERFLOOR DUCT - FIRST FLOOR - CENTER
B-12-E	UNDERFLOOR DUCT - FIRST FLOOR - EAST WING
B-13-E	UNDERFLOOR DUCT - FIRST FLOOR - WEST WING
B-14-E	UNDERFLOOR DUCT - SECOND FLOOR
B-15-E	POWER - BASEMENT
B-16-E	SECTIONS - DETAILS
B-17-E	SECTIONS - DETAILS
B-18-E	SECTIONS - DETAILS
B-19-E	SECTIONS - DETAILS - DIAGRAMS
B-20-E	PHAT PLANS - DETAILS
B-21-E	LIGHT - POWER DIAGRAMS
B-22-E	
B-23-E	AUXILIARY SYSTEMS - BASEMENT
B-24-E	AUXILIARY SYSTEMS - FIRST FLOOR
B-25-E	AUXILIARY SYSTEMS - SECOND FLOOR
B-26-E	AUXILIARY SYSTEMS - DIAGRAM
B-27-E	AUXILIARY SYSTEMS - DIAGRAMS - DETAILS

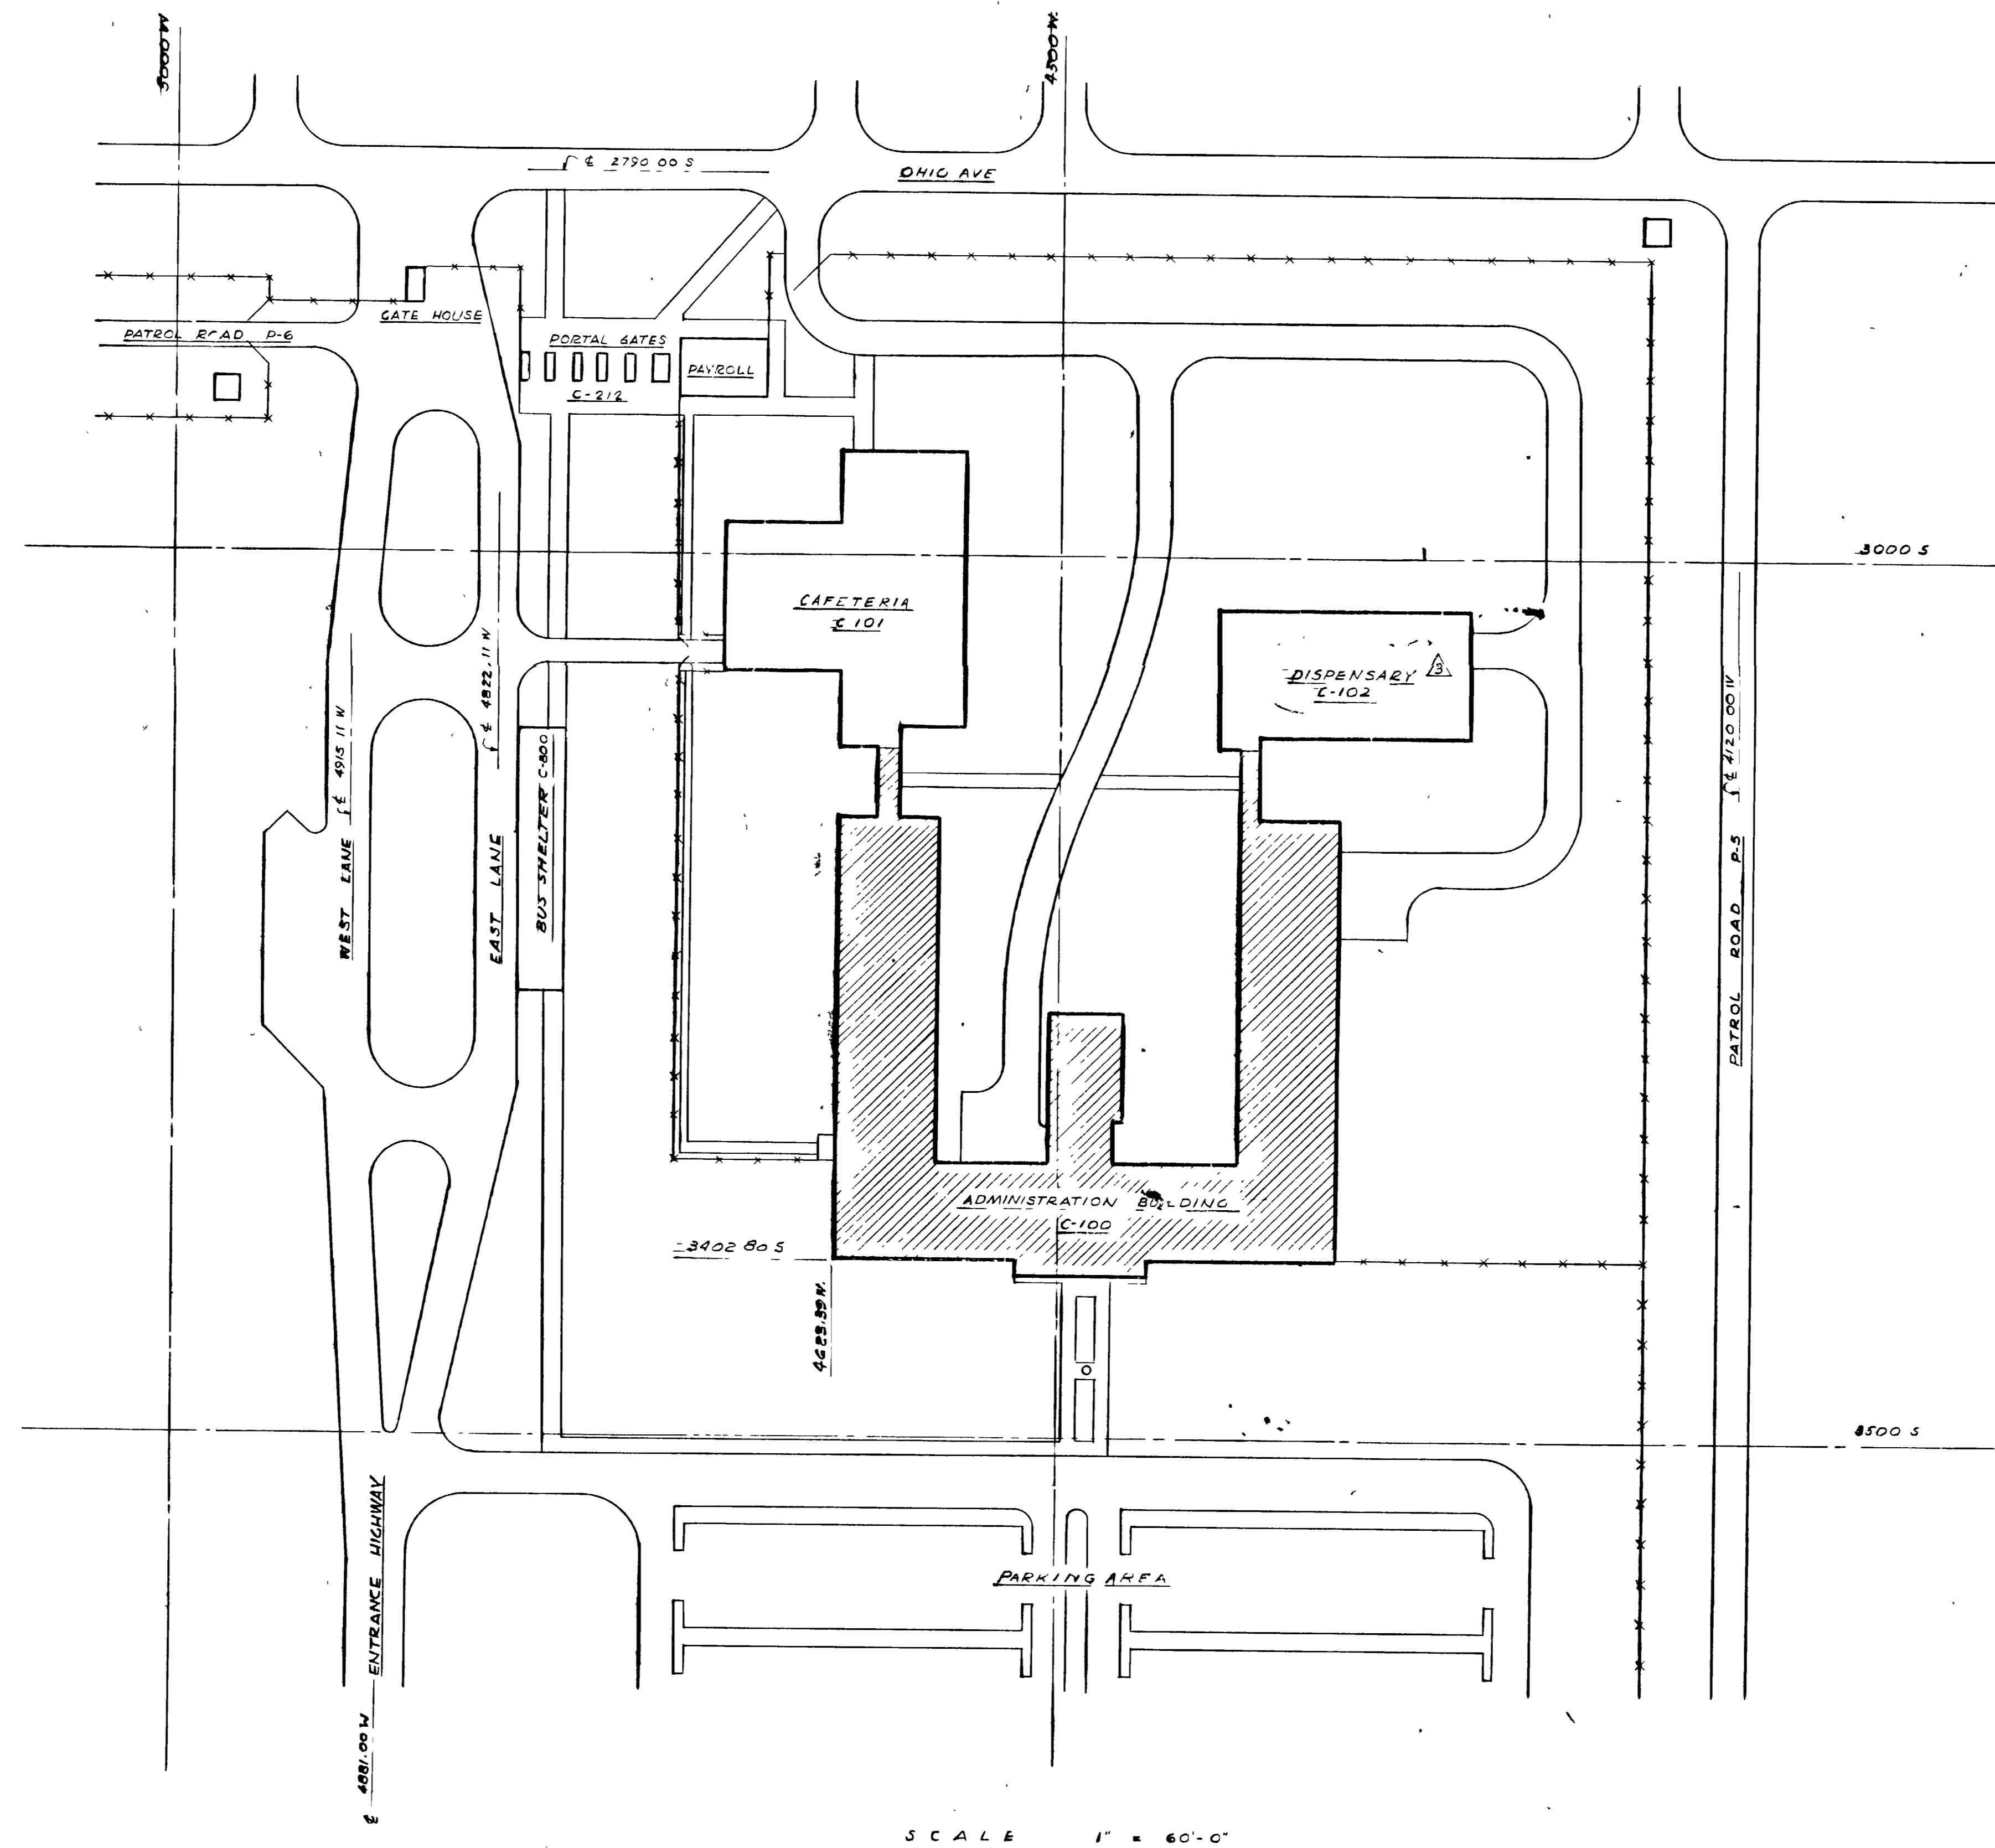


REVIEWED FOR CLASSIFICATION
sm 05/20/2014
Initials Date
UNCLASSIFIED

ADMINISTRATION BUILDING "C" PLANT - KENTUCKY AREA PADUCAH, KENTUCKY UNITED STATES ATOMIC ENERGY COMMISSION

DEPARTMENT OF ENERGY DECLASSIFICATION REVIEW	
1ST REVIEWER: [Signature]	2ND REVIEWER: [Signature]
DATE: 05/20/2014	DATE: 05/20/2014
CLASSIFICATION: UNCLASSIFIED	CLASSIFICATION: UNCLASSIFIED

CLASSIFICATION CHANGED BY: [Signature]
UNCLASSIFIED
DATE: 05/20/2014
REASON: [Signature]

BT Images, Inc
00000357

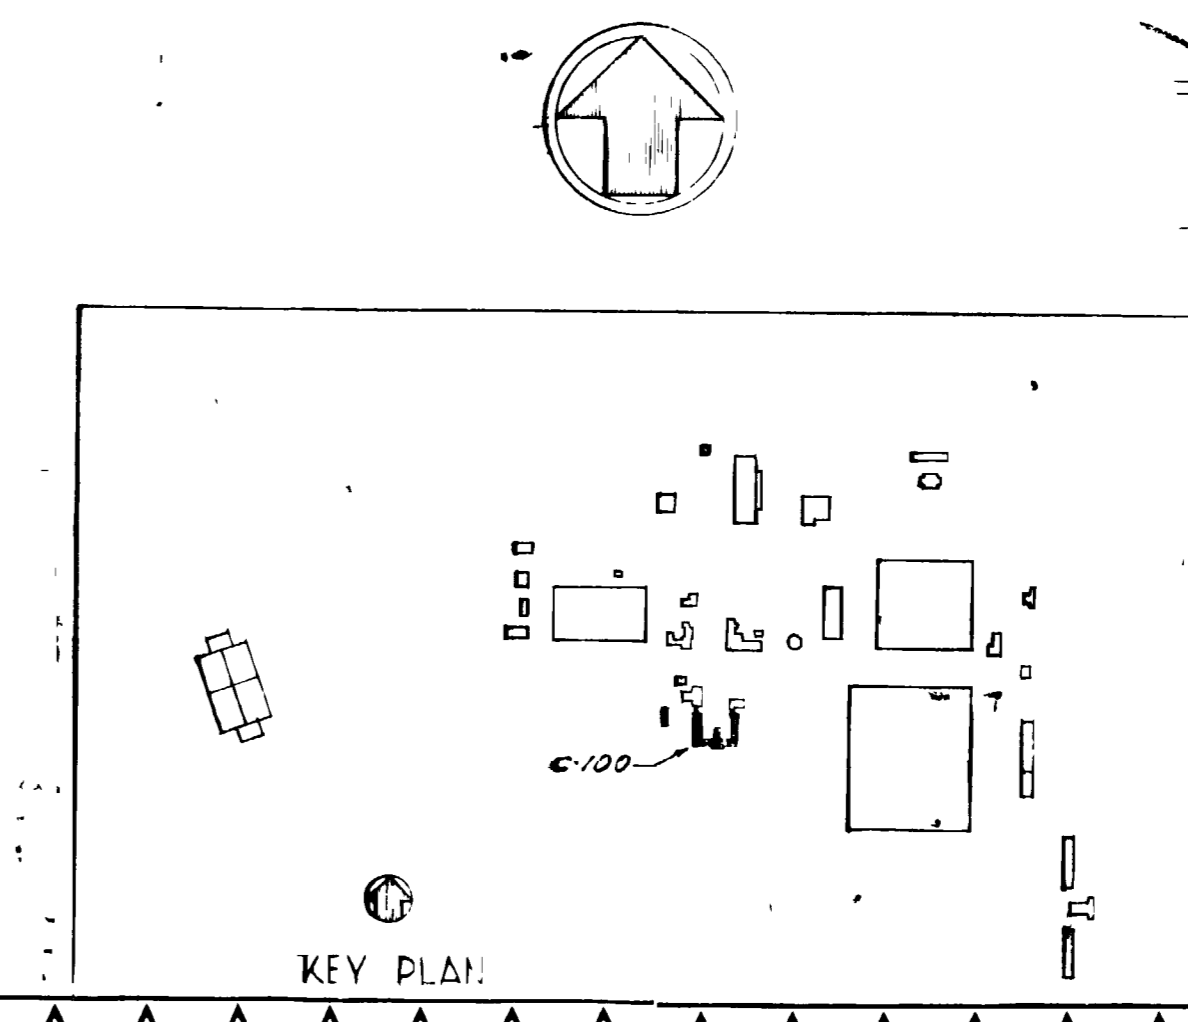

4	10/30/53	AS BUILT		EN 10/30/53
3	1/23/55	DEVIATION REQUEST NO. 028 ASHFC	EN 12/21/52	
2	1/16/51	CONSTRUCTION	B *	1/16/51
1	11/9/51	APPROVAL	AC	

UNITED STATES ATOMIC ENERGY COMMISSION			
SMITH, HINCHMAN & GRYLLS, INC.			
ARCHITECTS & ENGINEERS			
DETROIT 26, MICHIGAN			
DRAWING TITLE			
KEY PLAN			
DRAWING APPROVED - DATE	DRAWING APPROVED - DATE	DRAWING APPROVED - DATE	
[Signature]	[Signature]	[Signature]	
DATE	CHECKED	DATE	JOB
11/15/51	[Signature]	11/15/51	
IN CHARGE	DATE	DATE	8768
[Signature]	11/15/51	11/15/51	
PROJECT	BUILDING	C-100	SHEET
"C" PLANT	ADMINISTRATION		BI-1-E

Unclassified