


Unclassified

Unclassified

REFERENCE DRAWINGS
 FOR SUPPORTS & STRUCTURAL DETAILS:
 SEE DWG. C16-15
 FOR PLAN PROFILE & DETAILS OF:
 LINES 1-4 & 5 SEE DWG. C16-14
 C16-13
 C16-12
 C16-11
 C16-10
 C16-9
 C16-8
 C16-7
 C16-6
 C16-5
 C16-4
 C16-3
 C16-2
 C16-1
 LINES 3-6-7/8 SEE DWG. C16-14
 LINES SEE DWG. C16-12-M

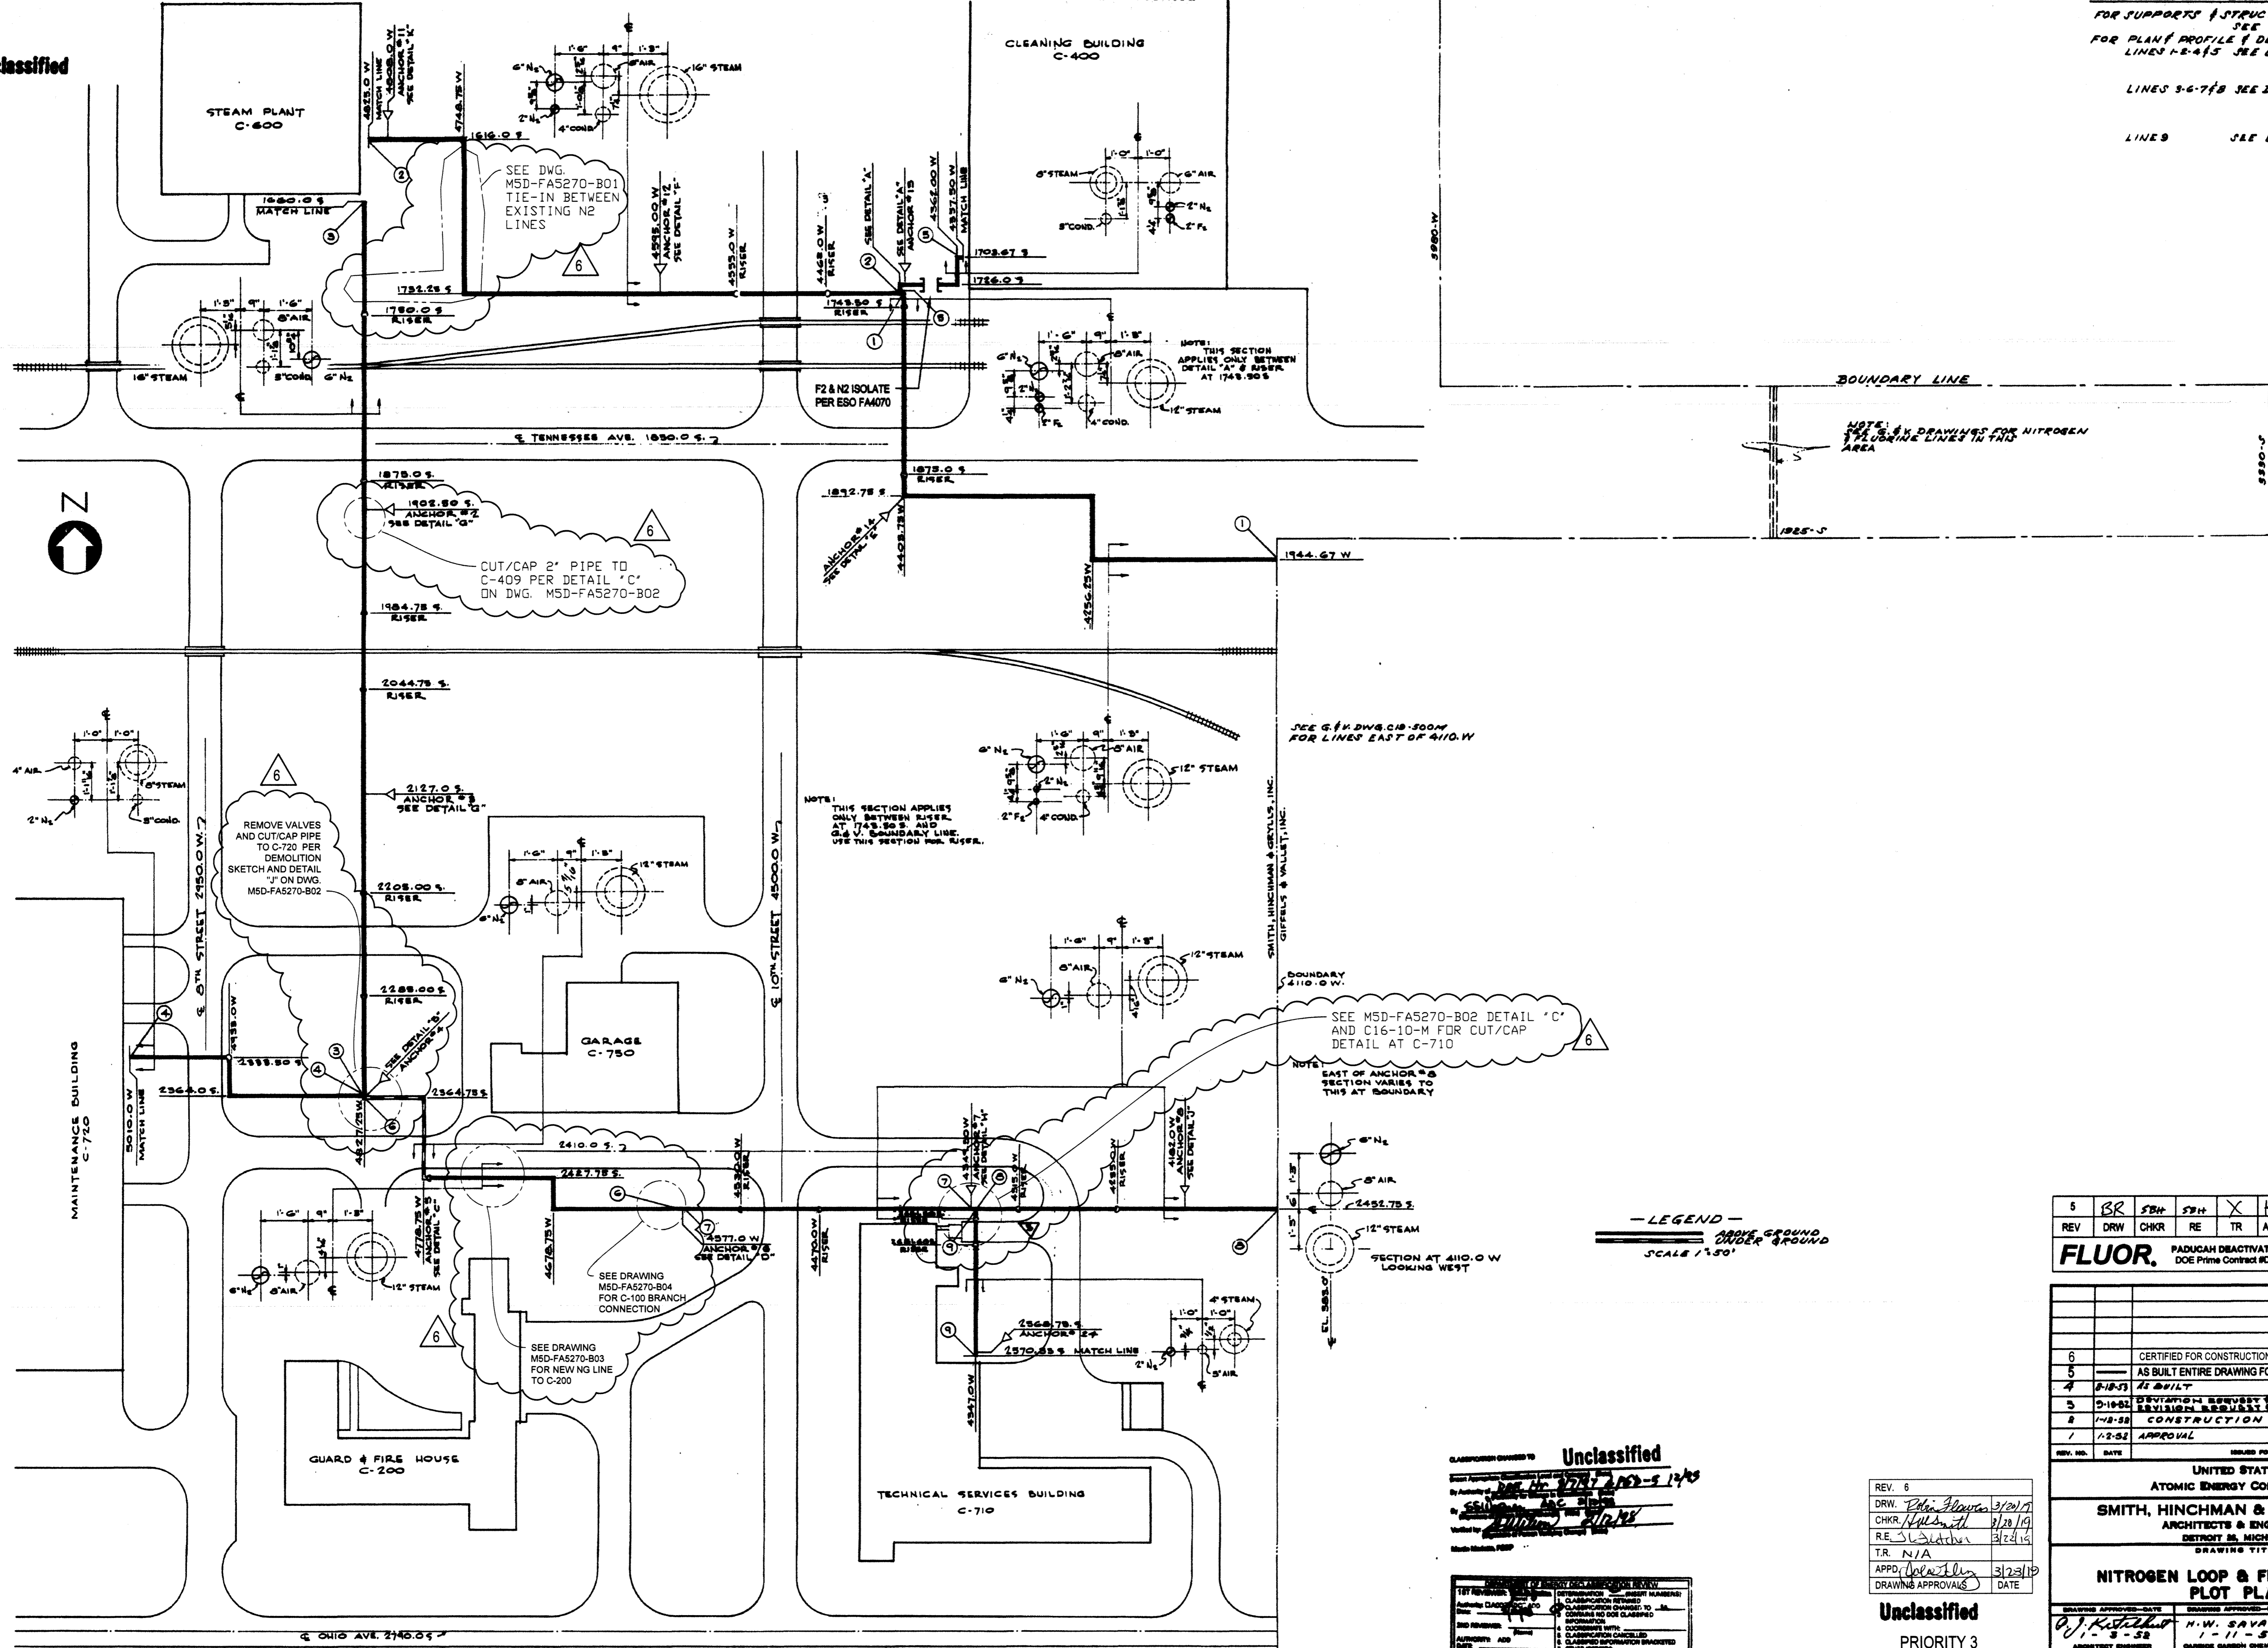

SEE G.I.H. DWG. C16-500W FOR LINES EAST OF 4110 W.

NOTE: THIS SECTION APPLIES ONLY BETWEEN RISEL AT 1748.90 S. AND 0.6 V. BOUNDARY LINE. USE THIS SECTION FOR RISEL.

NOTE: SEE MSD-FAS270-B02 DETAIL "C" AND C16-10-M FOR CUT/CAP DETAIL AT C-710
 NOTE: EAST OF ANCHOR #2 SECTION VARIES TO THIS AT BOUNDARY

— LEGEND —
 ABOVE GROUND
 UNDER GROUND
 SCALE 1"=50'

CLASSIFICATION CHANGED TO **Unclassified**
 1571-100-5-1240
 DATE 3/23/19

REV. 6
 DRW. *[Signature]* 3/23/19
 CHKR. *[Signature]* 3/23/19
 RE. *[Signature]* 3/23/19
 T.R. N/A
 APPD. *[Signature]* 3/23/19
 DRAWING APPROVALS DATE

Unclassified
 PRIORITY 3

1	1-2-52	APPROVAL	1/2-52
2	1-11-52	CONSTRUCTION	1-11-52
3	2-10-52	REVISIONS	2-10-52
4	3-18-52	REBUILT	3-18-52
5		AS BUILT	
6		CERTIFIED FOR CONSTRUCTION	

5	BR	SBH	SBH	X	KAS	9/26/17
REV	DRW	CHKR	RE	TR	APPD	DATE

FLUOR. RADUCAH DEACTIVATION PROJECT
 DOE Prime Contract #DE-OT000774

6						
5						
4						
3						
2						
1						

UNITED STATES ATOMIC ENERGY COMMISSION			
SMITH, HINCHMAN & GRYLLS, INC. ARCHITECTS & ENGINEERS DETROIT 26, MICHIGAN			
DRAWING TITLE NITROGEN LOOP & FLUORINE LINE PLOT PLAN			
DRAWING APPROVED - DATE <i>[Signature]</i> 1-11-52	DESIGNED - DATE H.W. SAVAGE 1-11-52	DRAWING APPROVED - DATE R.J. BROWN 1-11-52	
DATE 1-11-52	DATE 1-11-52	DATE 1-11-52	DATE 1-11-52
DESIGNED BY H.W. SAVAGE	DATE 1-11-52	DATE 1-11-52	DATE 1-11-52
PROJECT NITROGEN & FLUORINE DISTRIBUTION	DRAWING NUMBER C16-9-M	REV 6	

FOUR RIVERS
 NUCLEAR PARTNERSHIP, LLC
 DOE PRIME CONTRACT # DE-EM0004895