

SILENCERS TO BE LOCATED AND INSTALLED AS SHOWN ON THE LOCATION PLAN AND DETAILS IN THE STRUCTURAL DRAWINGS.

NOTE: PIPE SUPPORT SHOWN FOR VISUAL REFERENCE ONLY. SEE STRUCTURAL DRAWINGS FOR PIPE SUPPORT SECTIONS AND DETAILS.

NOTE: PIPE SUPPORT SHOWN FOR VISUAL REFERENCE ONLY. SEE STRUCTURAL DRAWINGS FOR PIPE SUPPORT SECTIONS AND DETAILS.

A-A PIPING PARTIAL ELEVATION PAD EAST END
HORIZ. SCALE : 1" = 6' VERT. SCALE : 1" = 3'


B-B TYPICAL PIPE RACK SECTION
SCALE : 1" = 1'

3 PIPING PARTIAL PLAN PAD EAST END
SCALE : 1" = 6'

REV.	3			
DRW.	<i>R. H. Hays</i>	3/20/19		
CHKR.	<i>N. Smith</i>	5/25/19		
R.E.	<i>J. Sedra</i>	3/22/19		
T.R.	N/A			
APPD.	<i>J. Sedra</i>	3/28/19		
DRAWING APPROVALS		DATE		

2	KTW	KK	KK	--	KAS	5/9/16
REV	DRW	CHKR	RED	TR	APPD	DATE

*SCALE SHOWN FOR FULL-SIZE 34" x 22" SHEETS

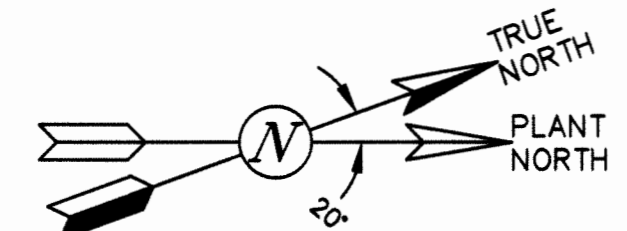

PRIORITY 3
FOUR RIVERS NUCLEAR PARTNERSHIP, LLC
DOE PRIME CONTRACT # DE-EM004895

FLUOR. PADUCAH DEACTIVATION PROJECT
DOE Prime Contract #DE-DT0007774

U.S. DEPARTMENT OF ENERGY
PADUCAH, PORTSMOUTH PROJECT OPERATIONS,
PADUCAH GASEOUS DIFFUSION PLANT

LATA Environmental Services of Kentucky, LLC managed for the DEPARTMENT OF ENERGY under U.S. GOVERNMENT contract DE-AC30-10CC40020 Paducah, Kentucky

DOE CONTRACT NO. DE-AC30-10CC40020

PROJECT NAME:
STEAM PACKAGE BOILERS AND PERMITS
TITLE:
STEAM AND UTILITIES PIPING AT BOILER PAD - ELEVATION AND DETAILS IV

EDCS CAD FILENAME: *170000007 Rev.dwg* BUILDING: C-600 PLANT: PDGP CLASS: U

SCALE: AS SHOWN DRAWING NUMBER: M7DC60000A007 REV: 3

REV.	DATE	DESCRIPTION	DRAWN BY	DRAFT CHK	PROJ ENGR	LEAD ENGR	CONF CTRL/ NUCL SFTY	FAC MGR	EATS MGR
3		CERTIFIED FOR CONSTRUCTION FOR ESO FA5270	X	X	X	X	X	X	X
2		AS BUILT ENTIRE DRAWING FOR ESO FA1620	X	X	X	X	X	X	X
1	6/11/15	FIT DETAIL 16 CALLOUT & DIM/PIPE RACK FO INSULATION REMOVED	TCW	KK	KK	TS	LCV	JRW	MAB
0	3/20/15	CERTIFIED FOR CONSTRUCTION	TCW	KK	KK	TS	JBU	RGS	KLH

DATE: PROFESSIONAL SEAL

DRAWING REVISIONS