
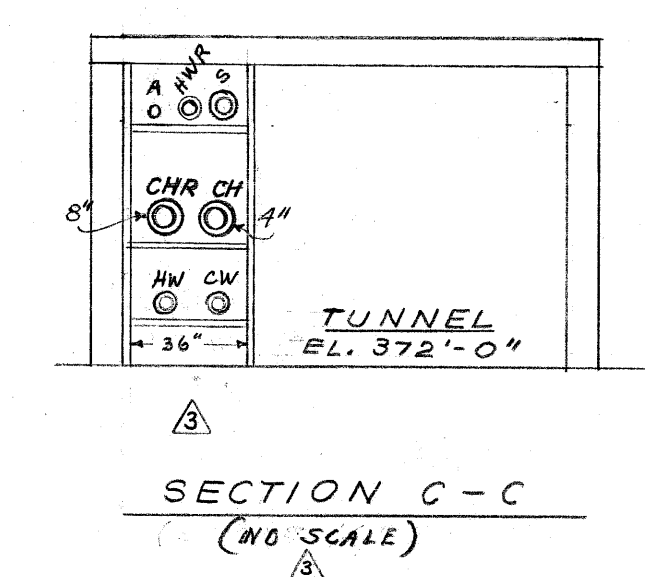
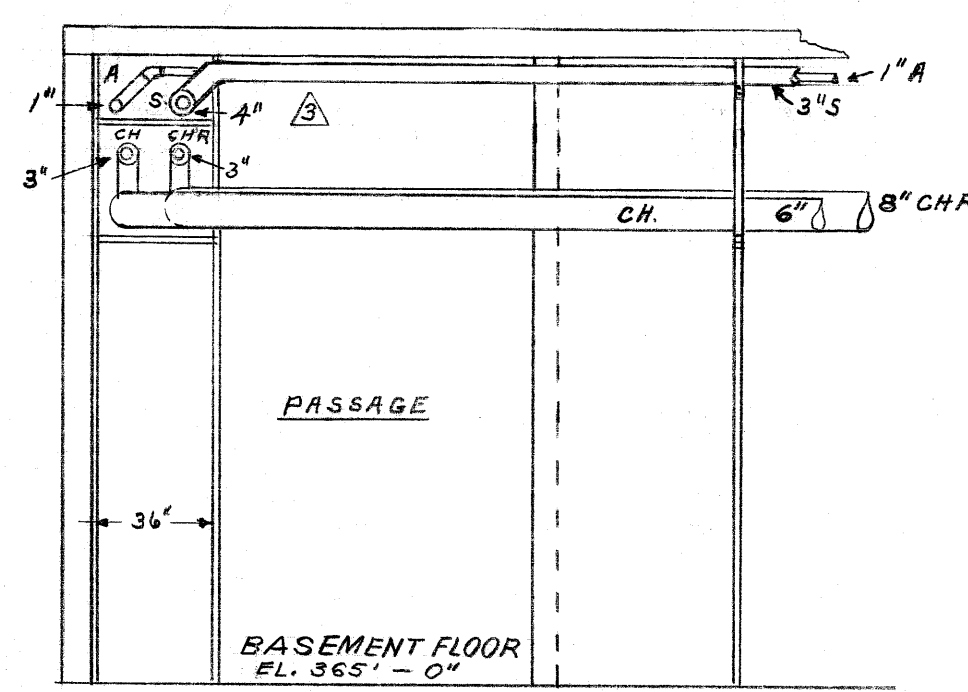



PLAN VIEW

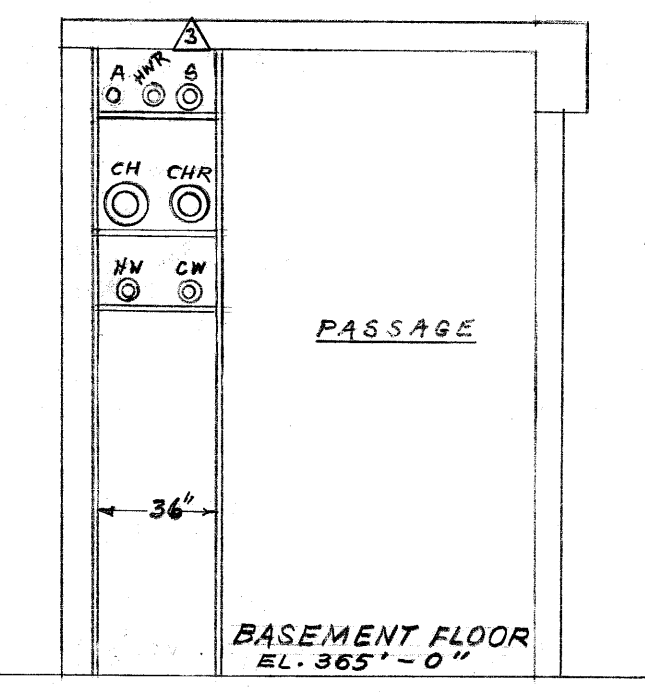

REFERENCE DRAWINGS

- BI-4-M SOUTHWEST EQUIPMENT ROOM
- BI-6-M SOUTHWEST EQUIPMENT ROOM
- BI-8-M CENTRAL EQUIPMENT ROOM
- BI-10-M PRESSURE REDUCING STATIONS
- BI-12-M DRILLED WATER PIPING ISOMETRICS
- BI-17-M STEAM CONNECTIONS ISOMETRICS
- BI-24-M VENTILATING SYSTEMS - MAIN WING
- BI-25-M PIPING LAYOUT - ANCHORS & SUPPORTS

BT Images, Inc. 0000602

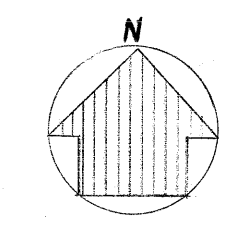

REVIEWED FOR CLASSIFICATION
 RLH 06/12/2014
 Initials Date
 UNCLASSIFIED

FOR INFORMATION ONLY

CLASSIFICATION CHANGED TO **Unclassified**
 Date: 11-16-53
 Authority: [Signature]
 Date: 11-16-53
 Verified by: [Signature]
 Date: 11-16-53

DEPARTMENT OF ENERGY DECLASSIFICATION REVIEW
 1. CLASSIFICATION REVIEWED
 2. CLASSIFICATION CHANGED TO UNCLASSIFIED
 3. COORDINATE WITH []
 4. INFORMATION
 5. CLASSIFICATION CANCELLED
 6. CLASSIFIED INFORMATION IDENTIFIED
 7. OTHER SPECIFY

| | | | |
|---|---|-----|----------|
| 6 | 11-16-53 AS BUILT | GC | 11-16-53 |
| 5 | 1-24-52 REVISION REQUEST NO. 542 & DEVIATION REQUEST NO. 288-M.A. | DR | |
| 4 | 3-26-52 REVISION REQUEST NO. 45B | DR | |
| 3 | 12-6-51 REVISION REQUESTS NOS. 101 & 102 | WW | |
| 2 | 11-9-51 CONSTRUCTION | W | 11-9-51 |
| 1 | 11-31-51 APPROVAL | A-C | WW |

REV. NO. DATE ISSUED FOR BY APP. DATE

UNITED STATES
 ATOMIC ENERGY COMMISSION
 SMITH, HINCHMAN & GRYLLS, INC.
 ARCHITECTS & ENGINEERS
 DETROIT 26, MICHIGAN
 DRAWING TITLE
BASEMENT & TUNNELS - MAIN WING

| | | |
|-------------------------|---------------------------|-------------------------|
| DRAWING APPROVED - DATE | DRAWING APPROVED - DATE | DRAWING APPROVED - DATE |
| [Signature] 11-8-51 | R.A. WALKER 11-8-51 | R.J. BROWN 11-8-51 |
| DATE | DATE | DATE |
| 11-9-51 | 11-9-51 | 11-9-51 |
| ARCHITECT ENGINEER | CARBIDE CARBON CHEM. DIV. | A. E. C. ENGINEER |
| DATE | DATE | DATE |
| 11-9-51 | 11-9-51 | 11-9-51 |
| IN CHARGE | DATE | DATE |
| [Signature] | 11-9-51 | 11-9-51 |
| PROJECT | BUILDING | SHEET |
| C-PLANT | ADMINISTRATION C-100 | 8768 |
| | | BI-10-M |

This Material contains information affecting the national defense of the United States within the meaning of the espionage laws, Title 18, U.S.C., Secs. 793 and 794, the transmission or revelation of which in any manner to an unauthorized person is prohibited by law.

UNCLASSIFIED