


OFFICIAL USE ONLY

BT Images, Inc.
00000547

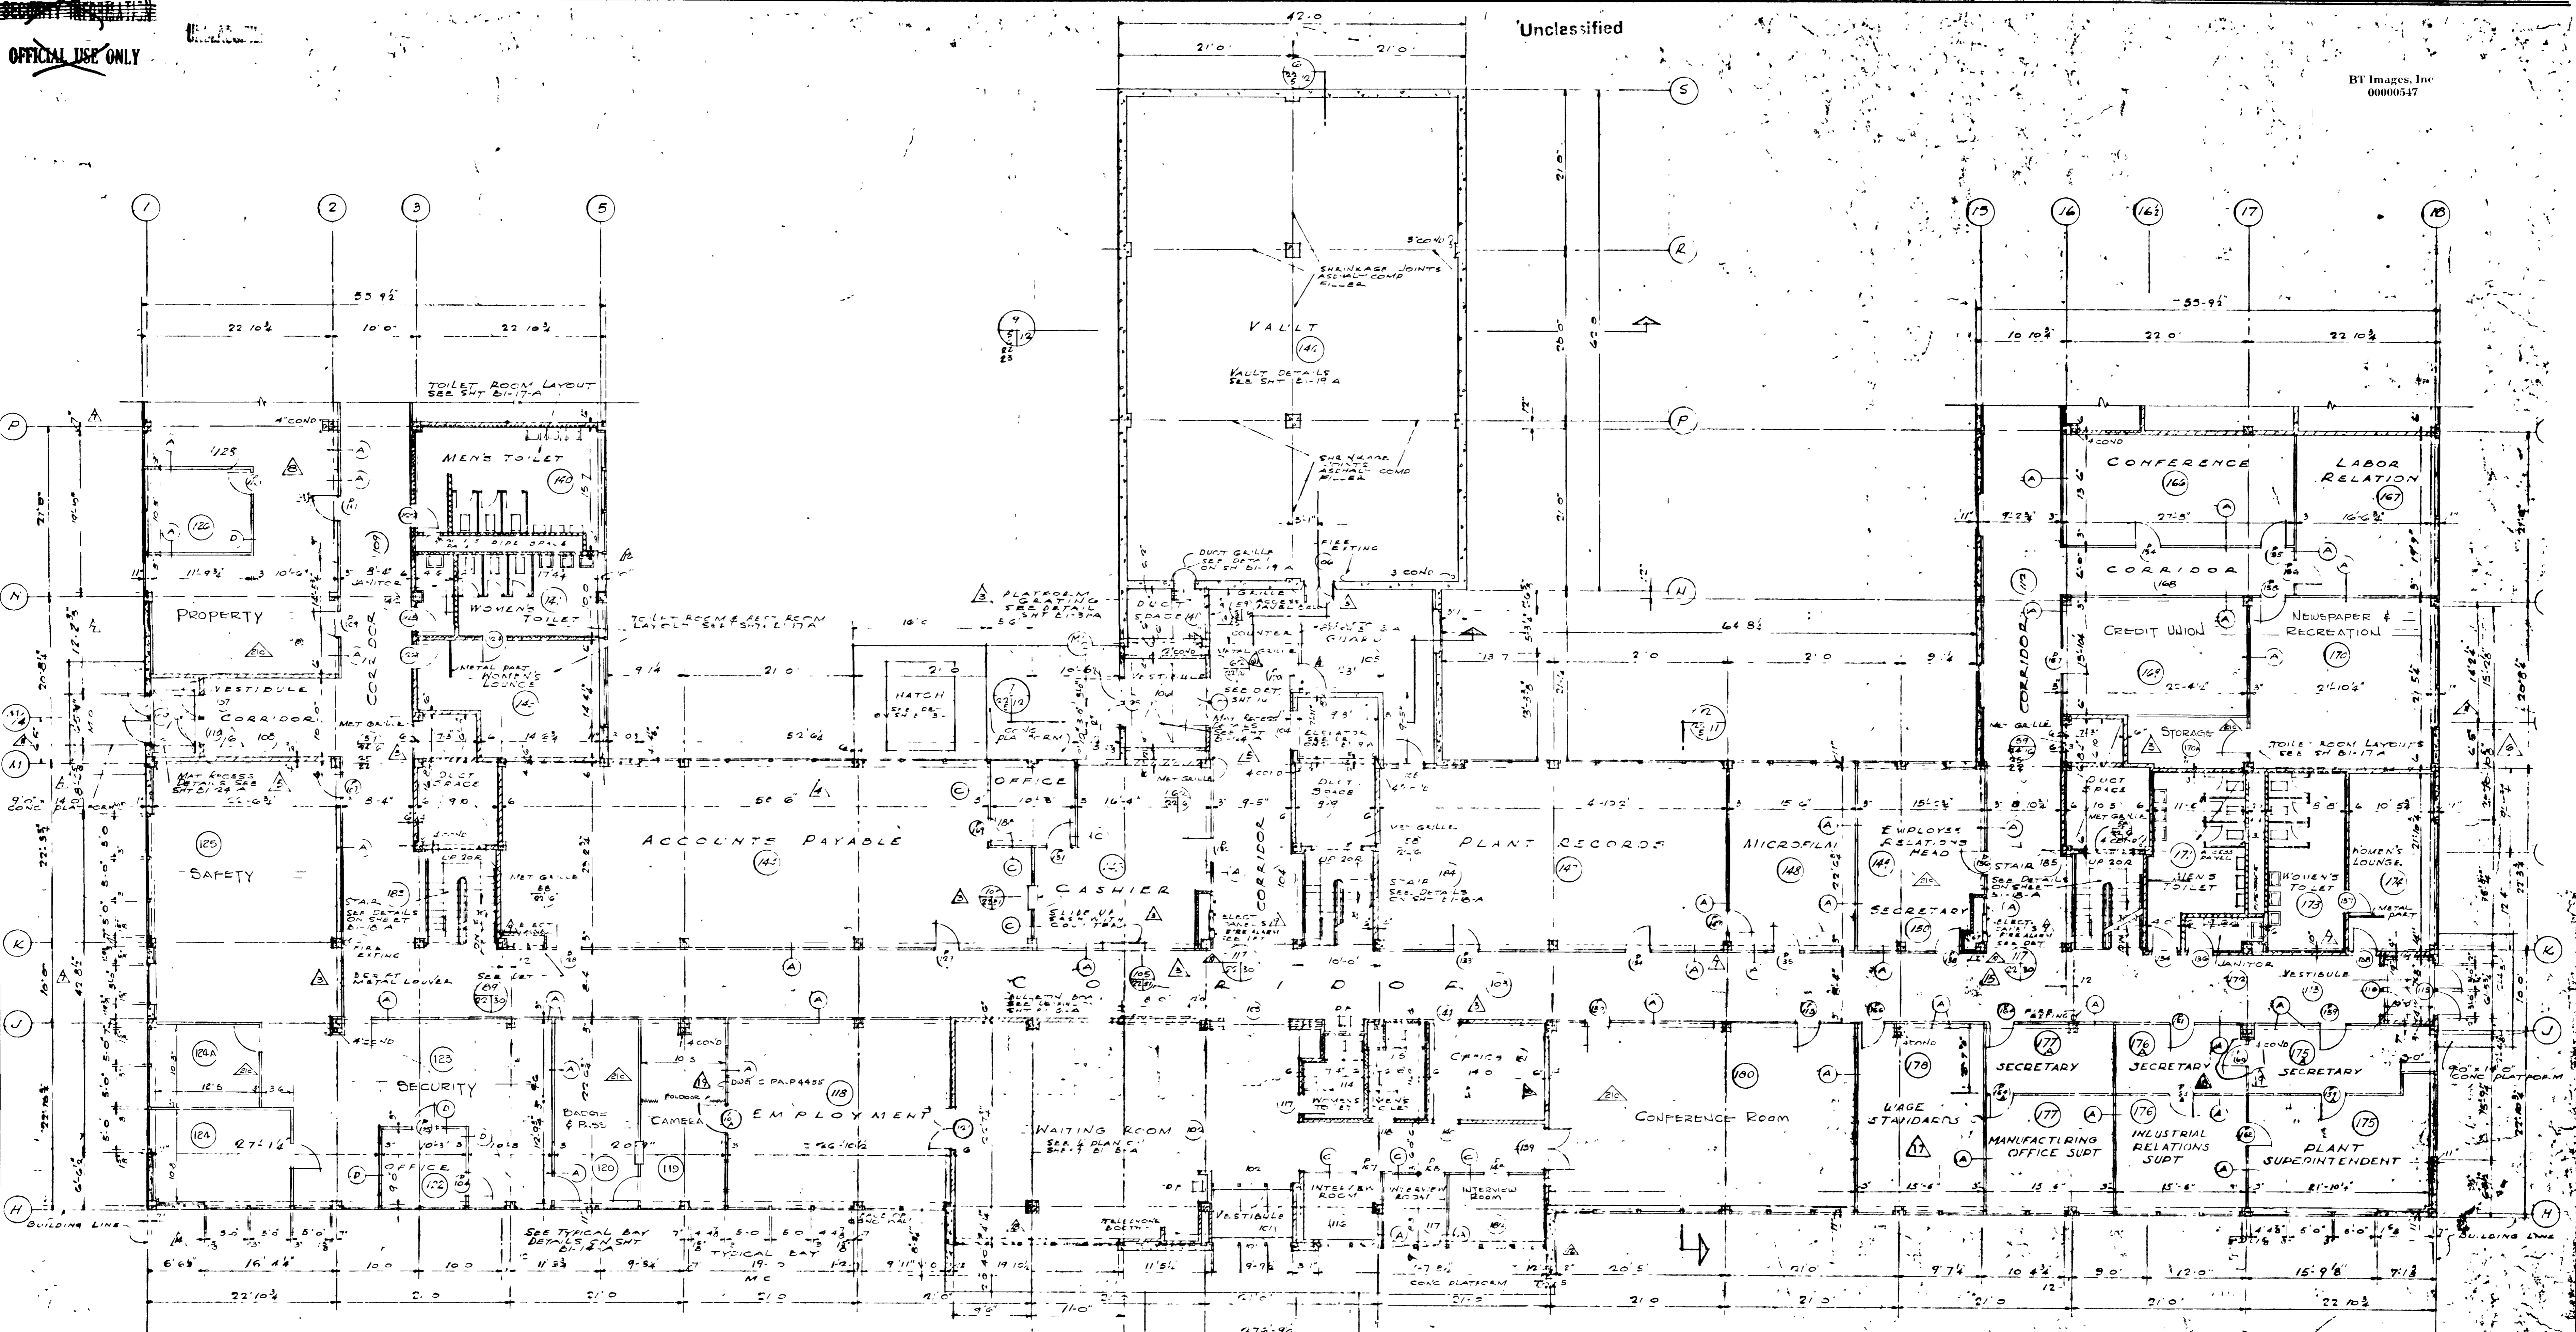

UNCLASSIFIED

REVIEWED FOR CLASSIFICATION
JBF 05/20/2014
Initials: _____ Date: _____
UNCLASSIFIED

UNITED STATES
ATOMIC ENERGY COMMISSION

SMITH, HINCHMAN & GRYLLS, INC.
ARCHITECTS & ENGINEERS
DETROIT 28 MICHIGAN

MAIN WING FIRST FLOOR
SCALE 1/8" = 1'-0"

REVISIONS:

REV NO	DATE	ISSUED FOR	BY	APP DATE
10	8/4/51	DEVIATION REQUEST NO 350-AE		
9	5/29/51	REVISION REQUEST NO 605		
8	4/10/51	REVISION REQUEST NO 508		
7	4/1/51	REVISION REQUEST NO 477		
6	3/16/51	REVISION REQUEST NO 464		
5	3/6/51	REVISION REQUEST NO 314		
4	2/17/51	REVISION REQUEST NO 368		
3	2/1/51	REVISION REQUEST NO 124		
2	1/2/51	CONSTRUCTION "B"		9/21/51
1	9/25/50	ISSUED FOR A AND C APPROVAL		

NOTE:
FOR LOCATIONS AND DIMENSIONS OF DUCT CANALS, LOUVERS, METAL GALLES, DAMPERS AND BARRIERS, SEE MECHANICAL DRAWINGS.

ALL ABOVE ITEMS ARE TO BE VERIFIED BY MECHANICAL CONTRACTOR.

ALL DOOR NUMBERS FOLLOWED BY LETTER A SHALL BE OF THE SAME TYPE AS THE CORRESPONDING DOOR WITHOUT LETTER. 10, 113 E/ISA ARE THE SAME.

CLASSIFICATION CHANGED TO **Unclassified**

DATE: 10/23/51
BY: JBF

REVISIONS:

REV NO	DATE	ISSUED FOR	BY	APP DATE
19	7/15/51	DEVIATION REQUEST NO 432-A		
18	7/15/51	DEVIATION REQUEST NO 432-A		
17	5/11/51	DEVIATION REQUEST NO 432-A		
16	12/23/50	REVISION REQUEST NO 77		
15	11/26/50	DEVIATION REQUEST NO 432-A		
14	11/16/50	DEVIATION REQUEST NO 556-A5		
13	7/16/50	REVISION REQUEST NO 732		
12	7/14/50	REVISION REQUEST NO 726		
11	6/30/50	DEVIATION REQUEST NO 504		

EIC PJ 9/10/51 PARTITION CHANGES

8768

ADMINISTRATION C-100 BI-22-A