
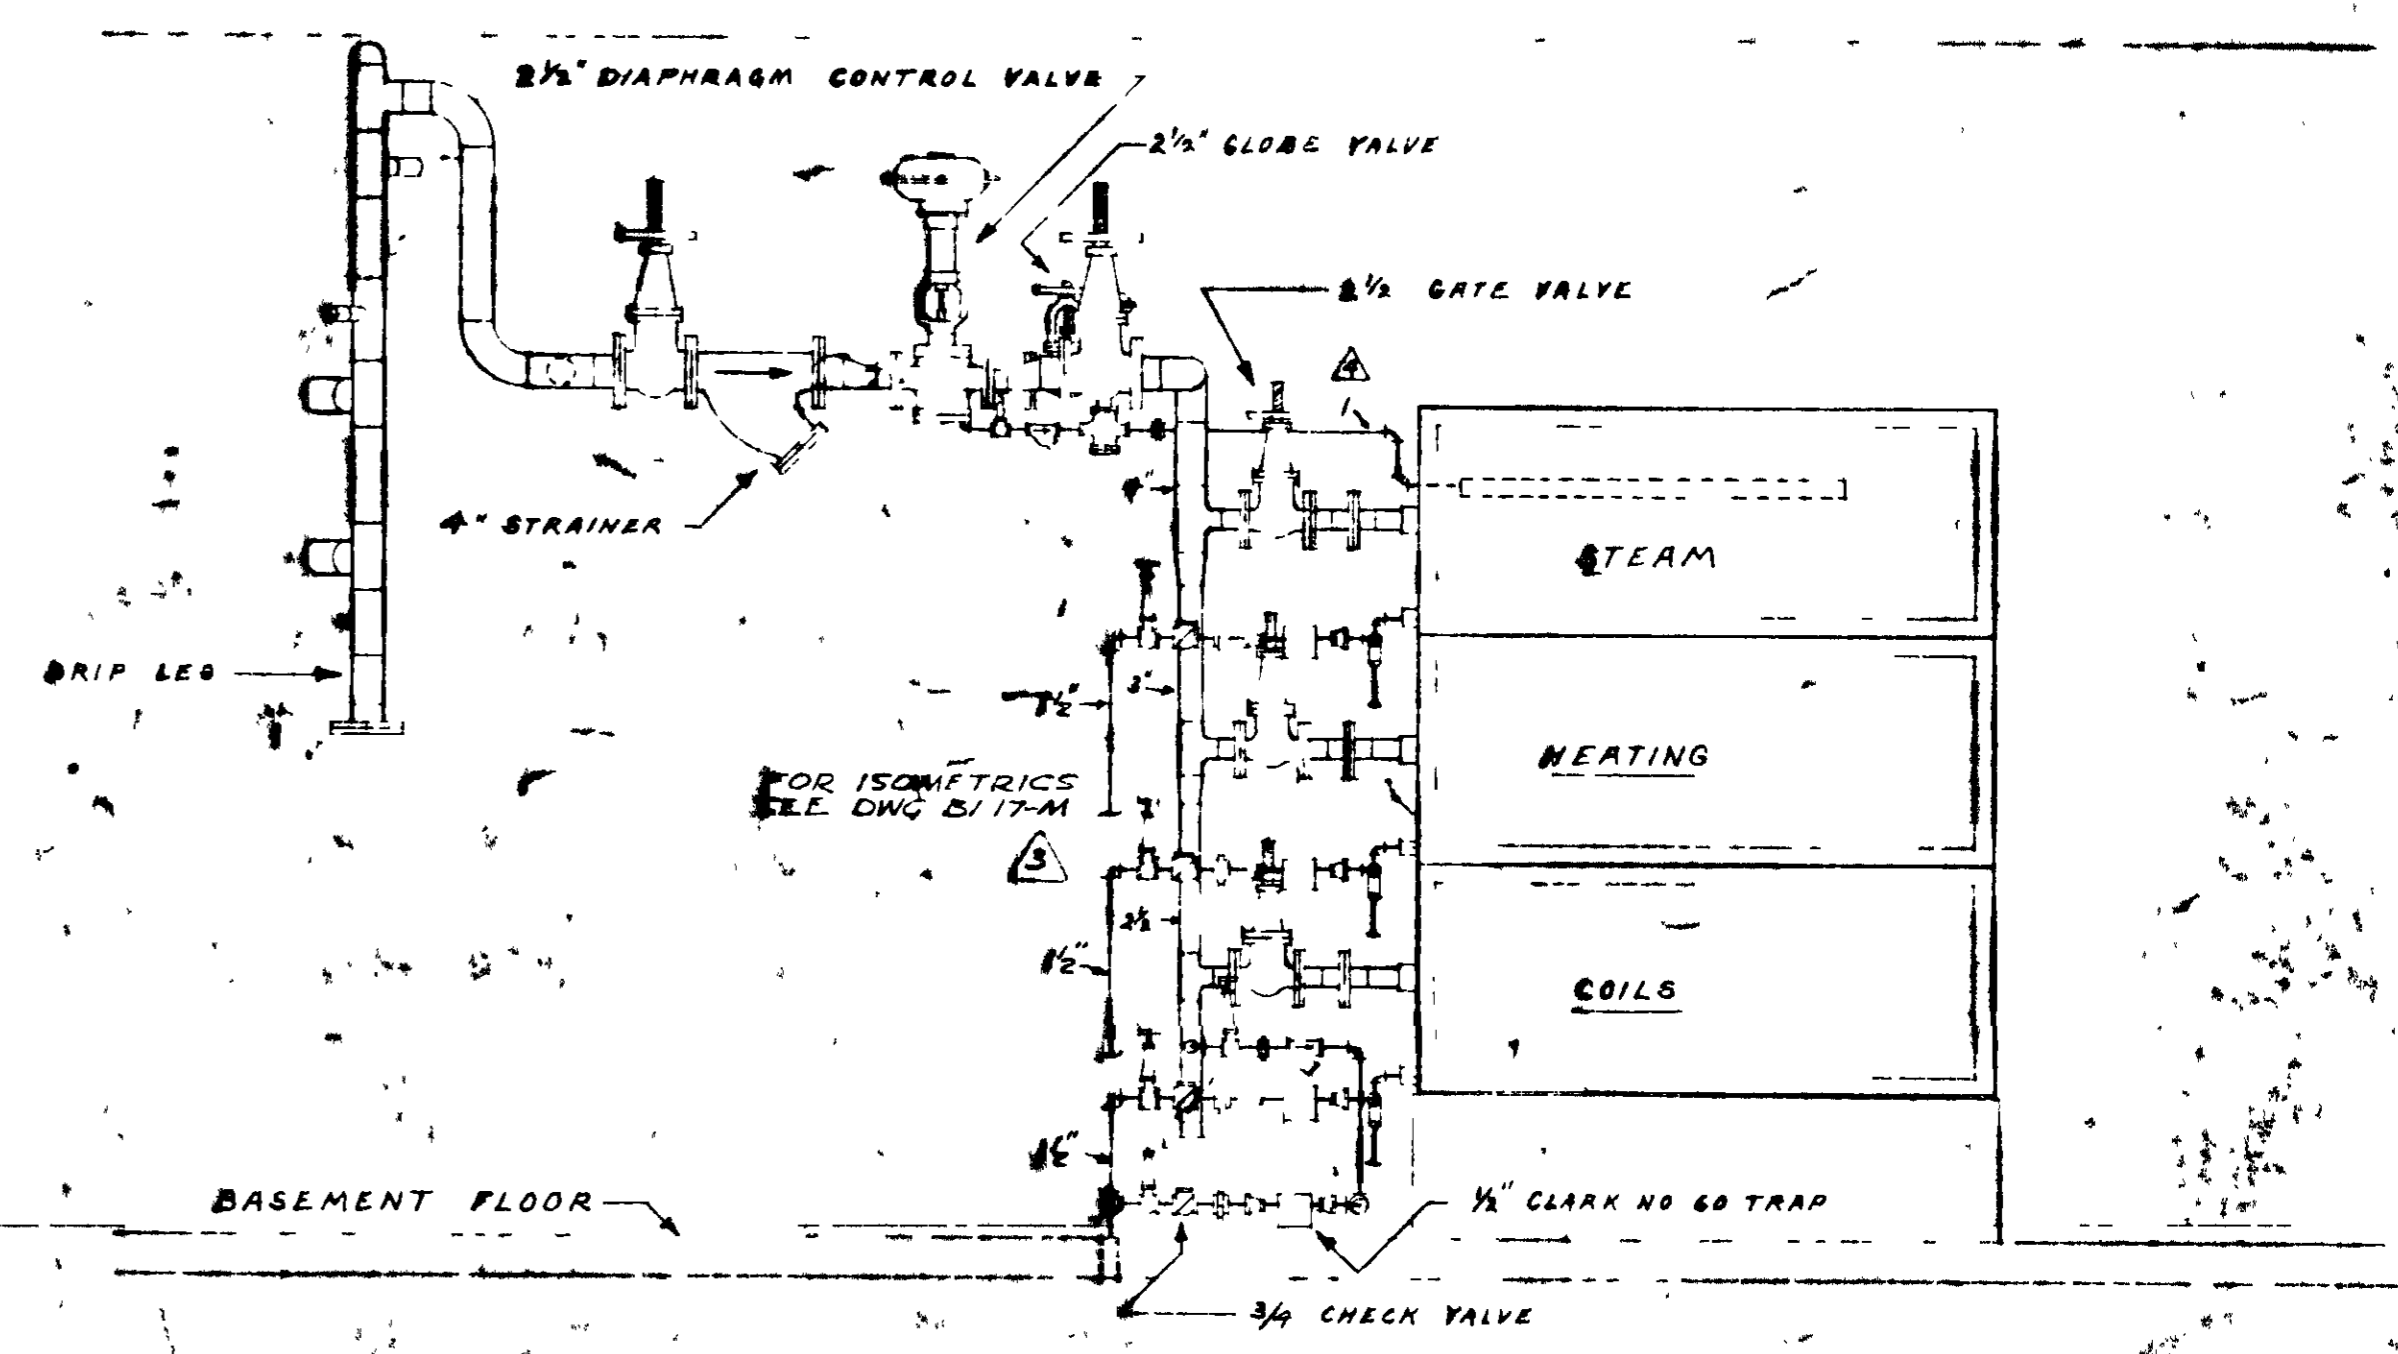


UNCLASSIFIED

UNCLASSIFIED

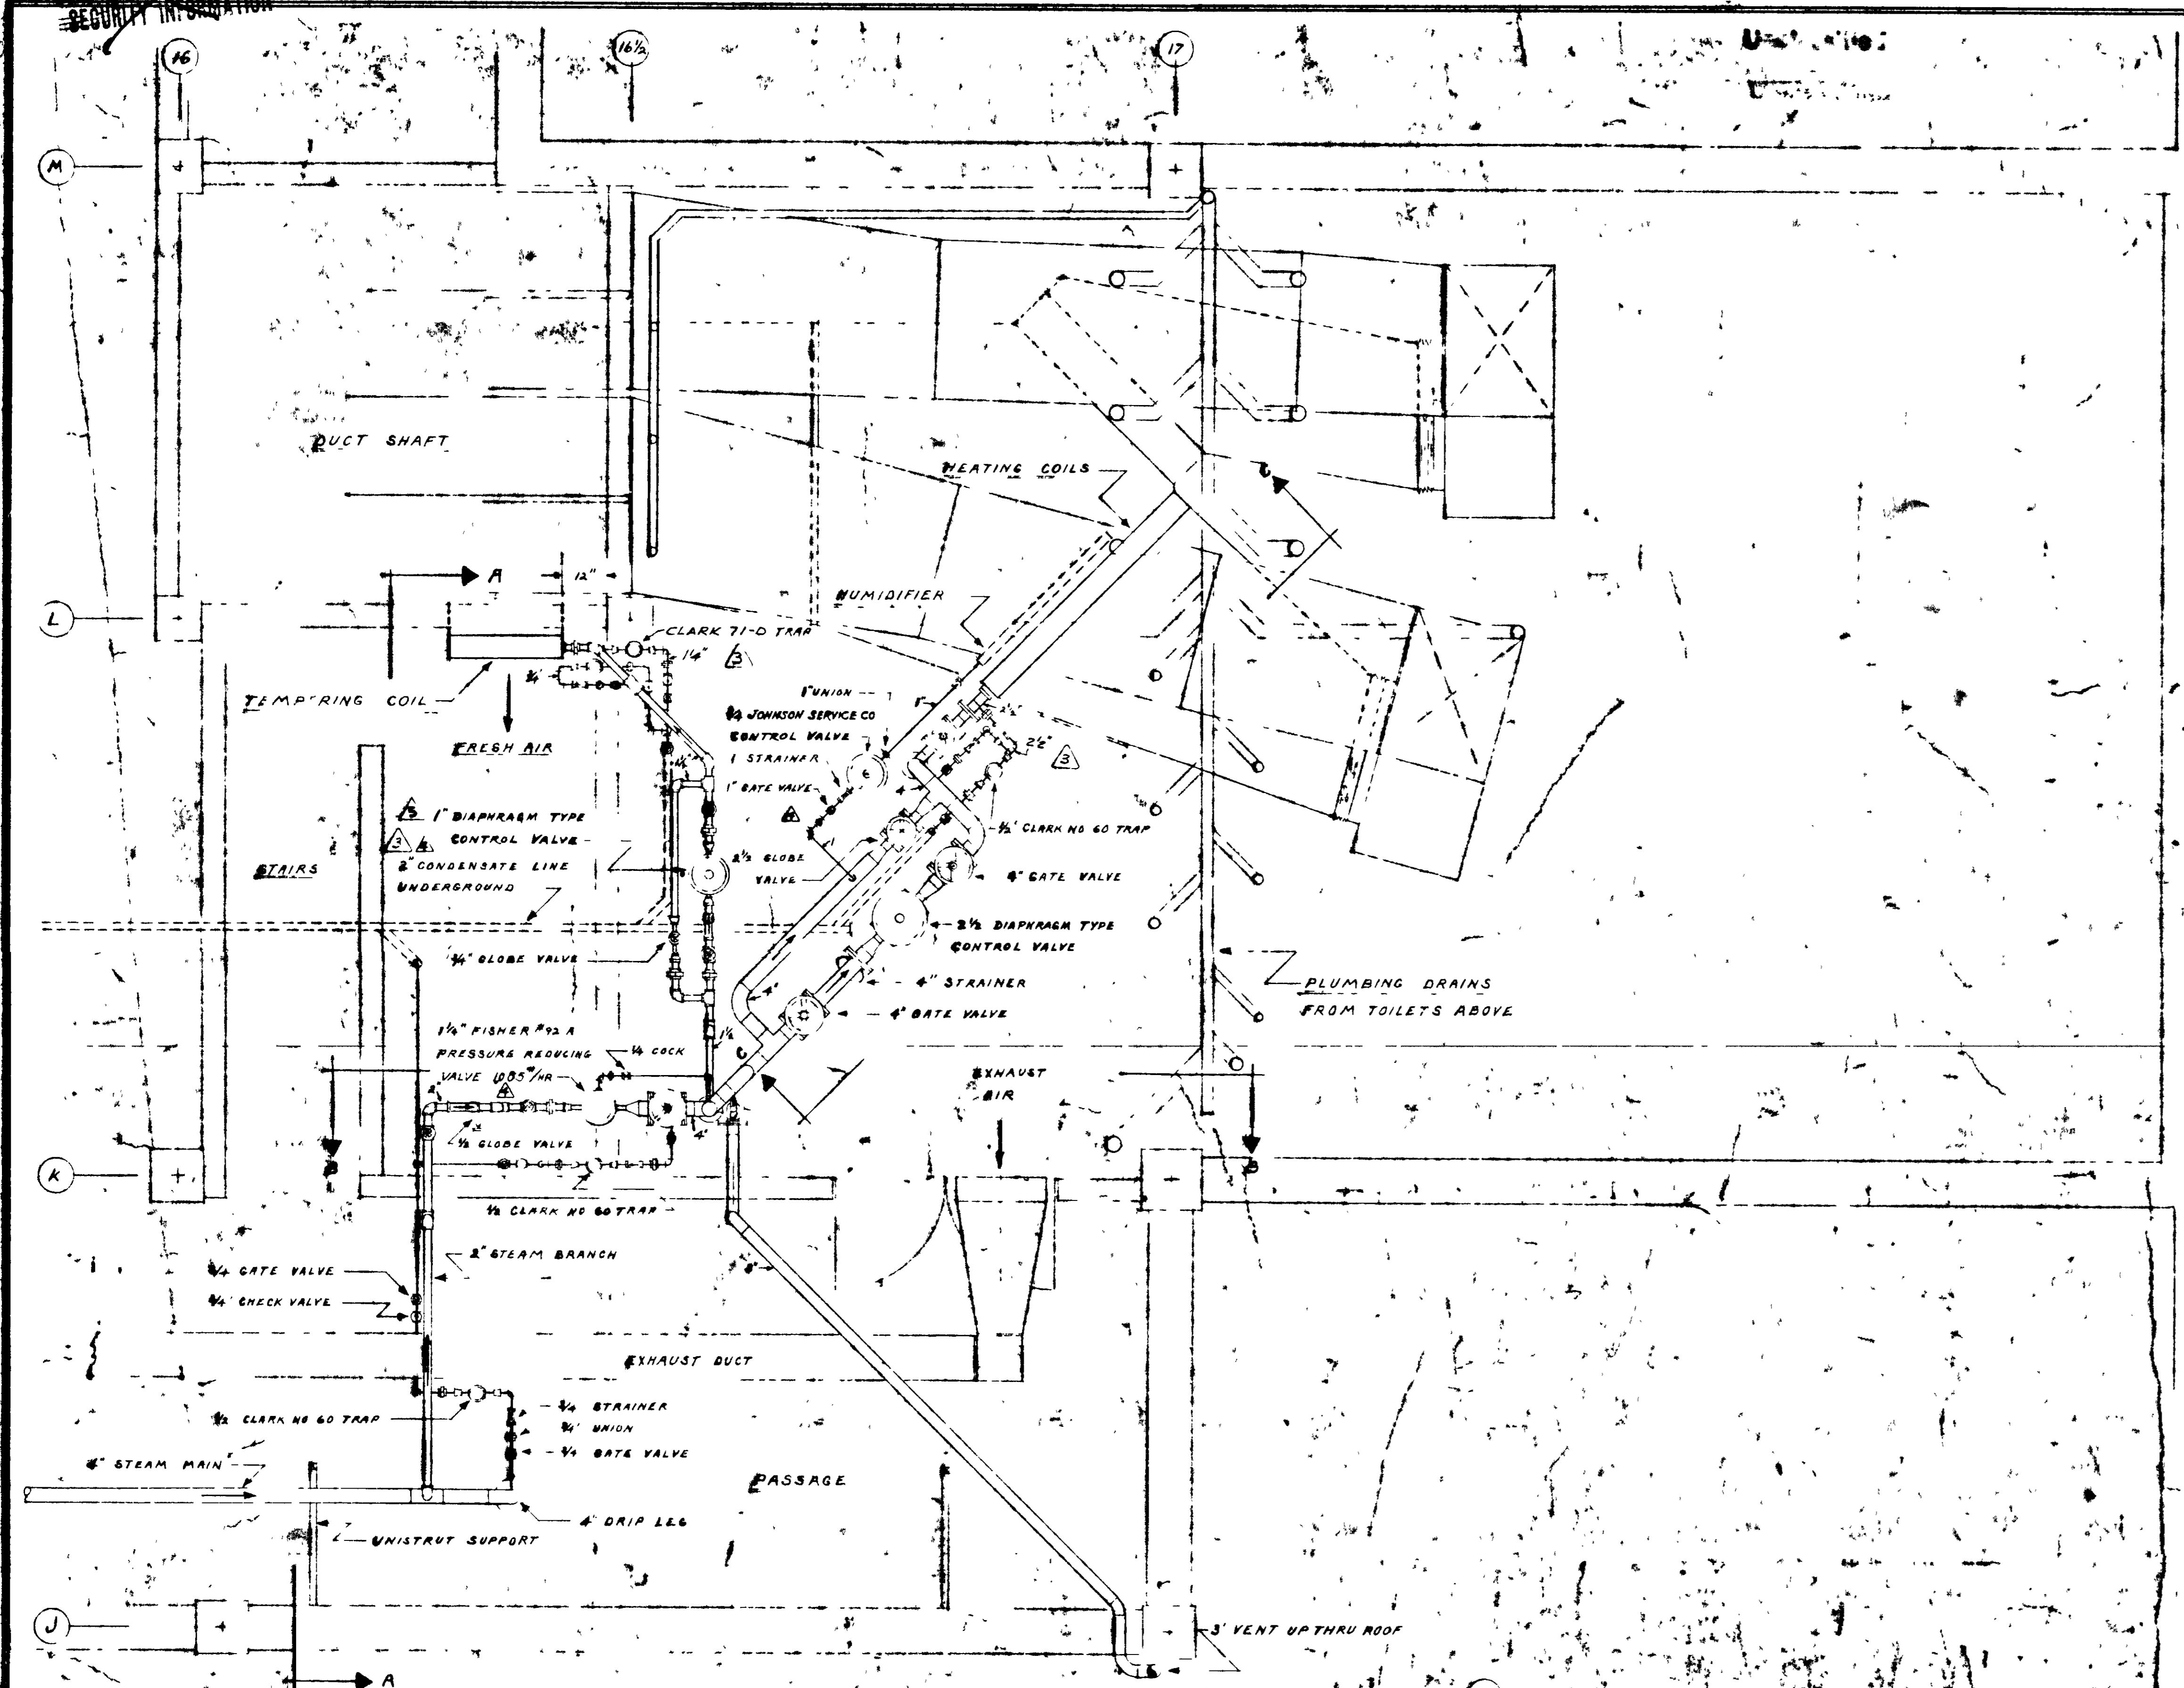

REVIEWED FOR CLASSIFICATION
 TWP 05/23/2014
 Initials: _____ Date: _____
 UNCLASSIFIED



GENERAL NOTES

- 1 - PITCH ALL STEAM AND CONDENSATE PIPING IN THE DIRECTION OF FLOW, NOT LESS THAN 1/8\"/>

REFERENCE DRAWINGS

- 81-6 M SOUTHWEST EQUIPMENT ROOM
- 81-10 M PIPING LAYOUT - BASEMENT & TUNNELS
- 81-17 M STEAM CONNECTIONS ISOMETRIES
- 81-22 M VENTILATING SYSTEMS - EQUIPMENT ROOMS
- 81-25 M PIPING LAYOUT - ANCHORS & SUPPORTS
- 81-29 M STEAM PRESSURE REDUCING STATIONS

PLAN VIEW (SCALE 1/4\"/>

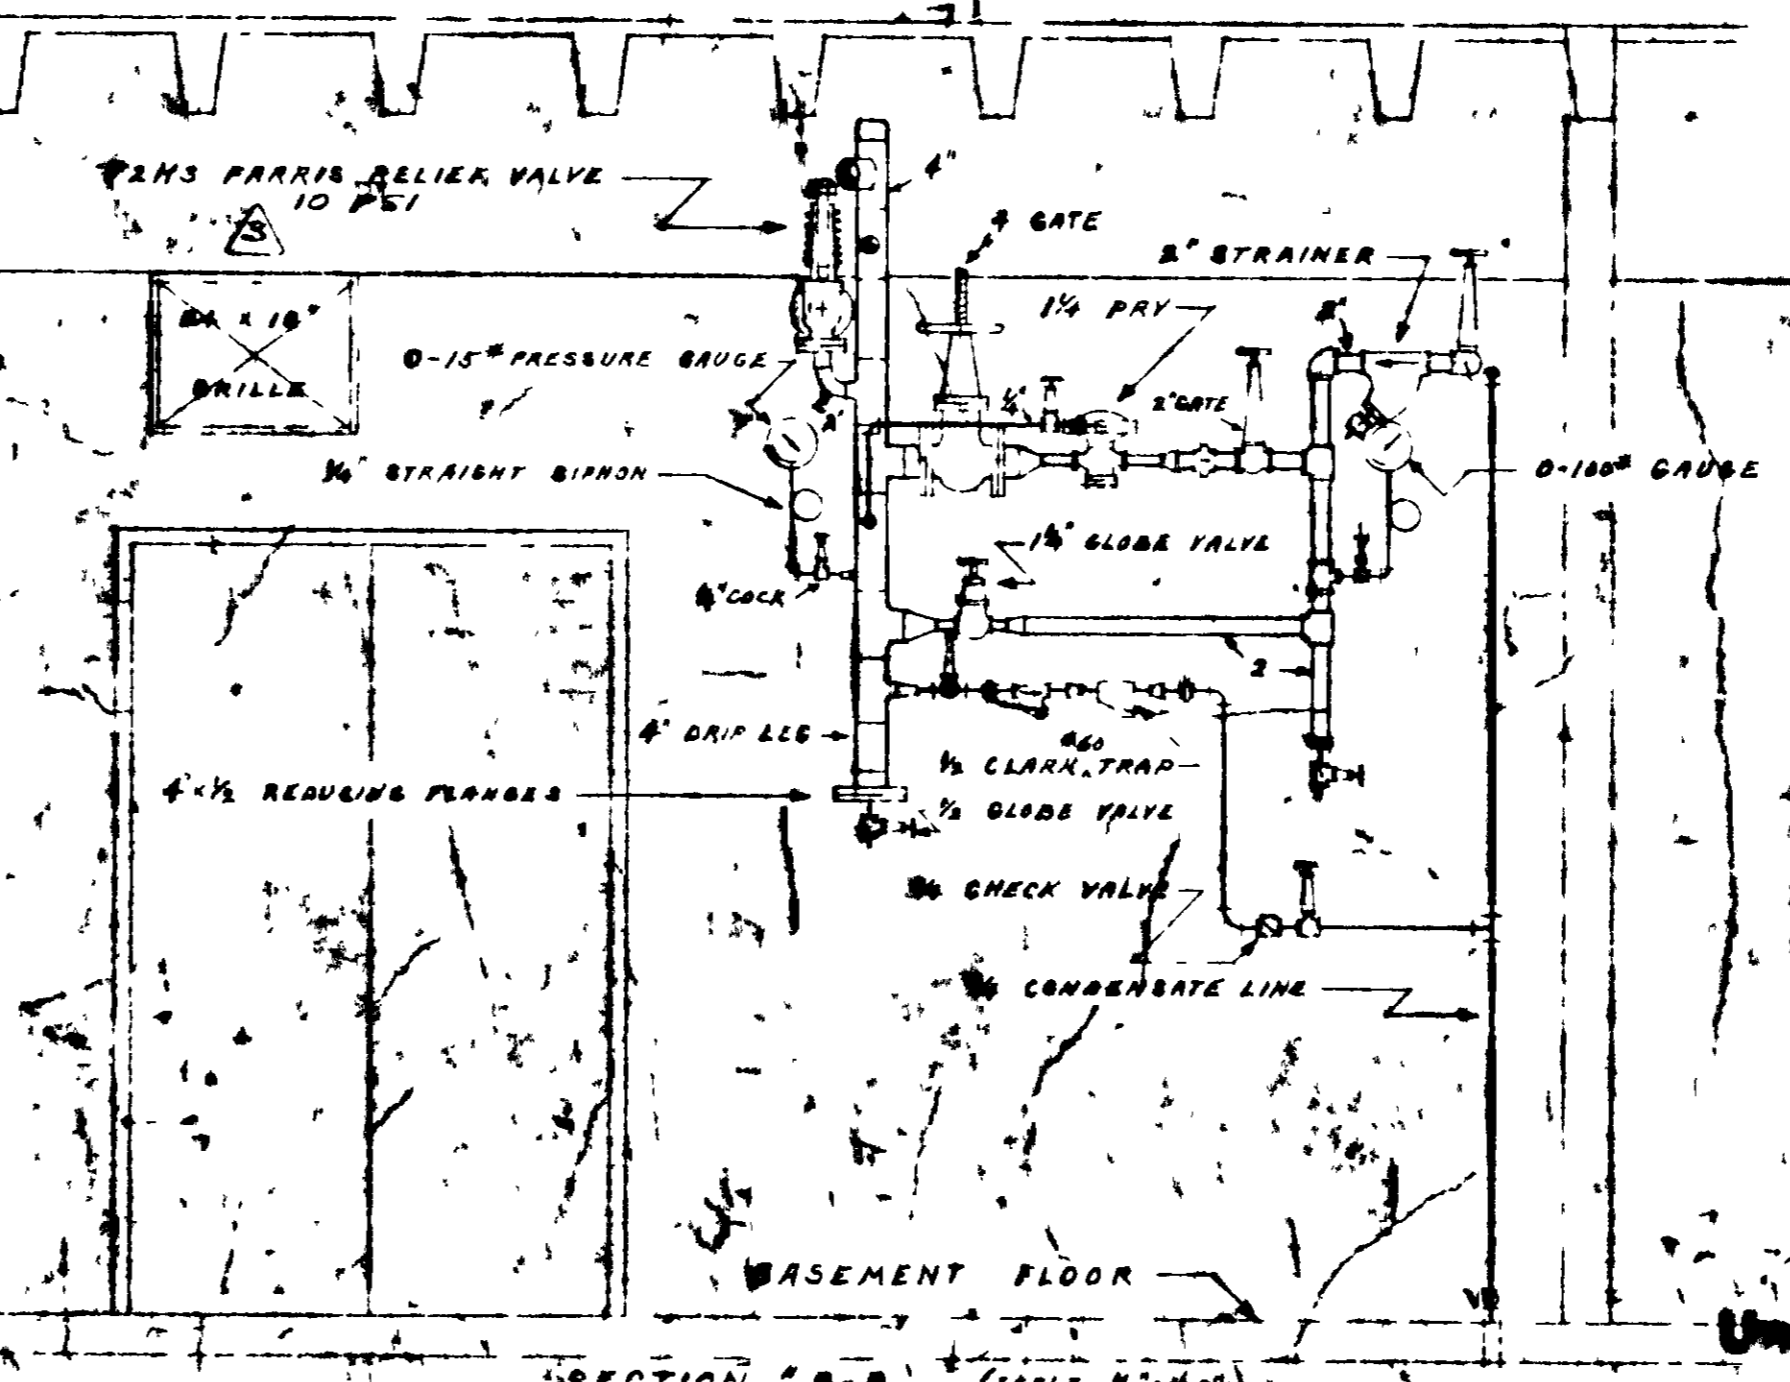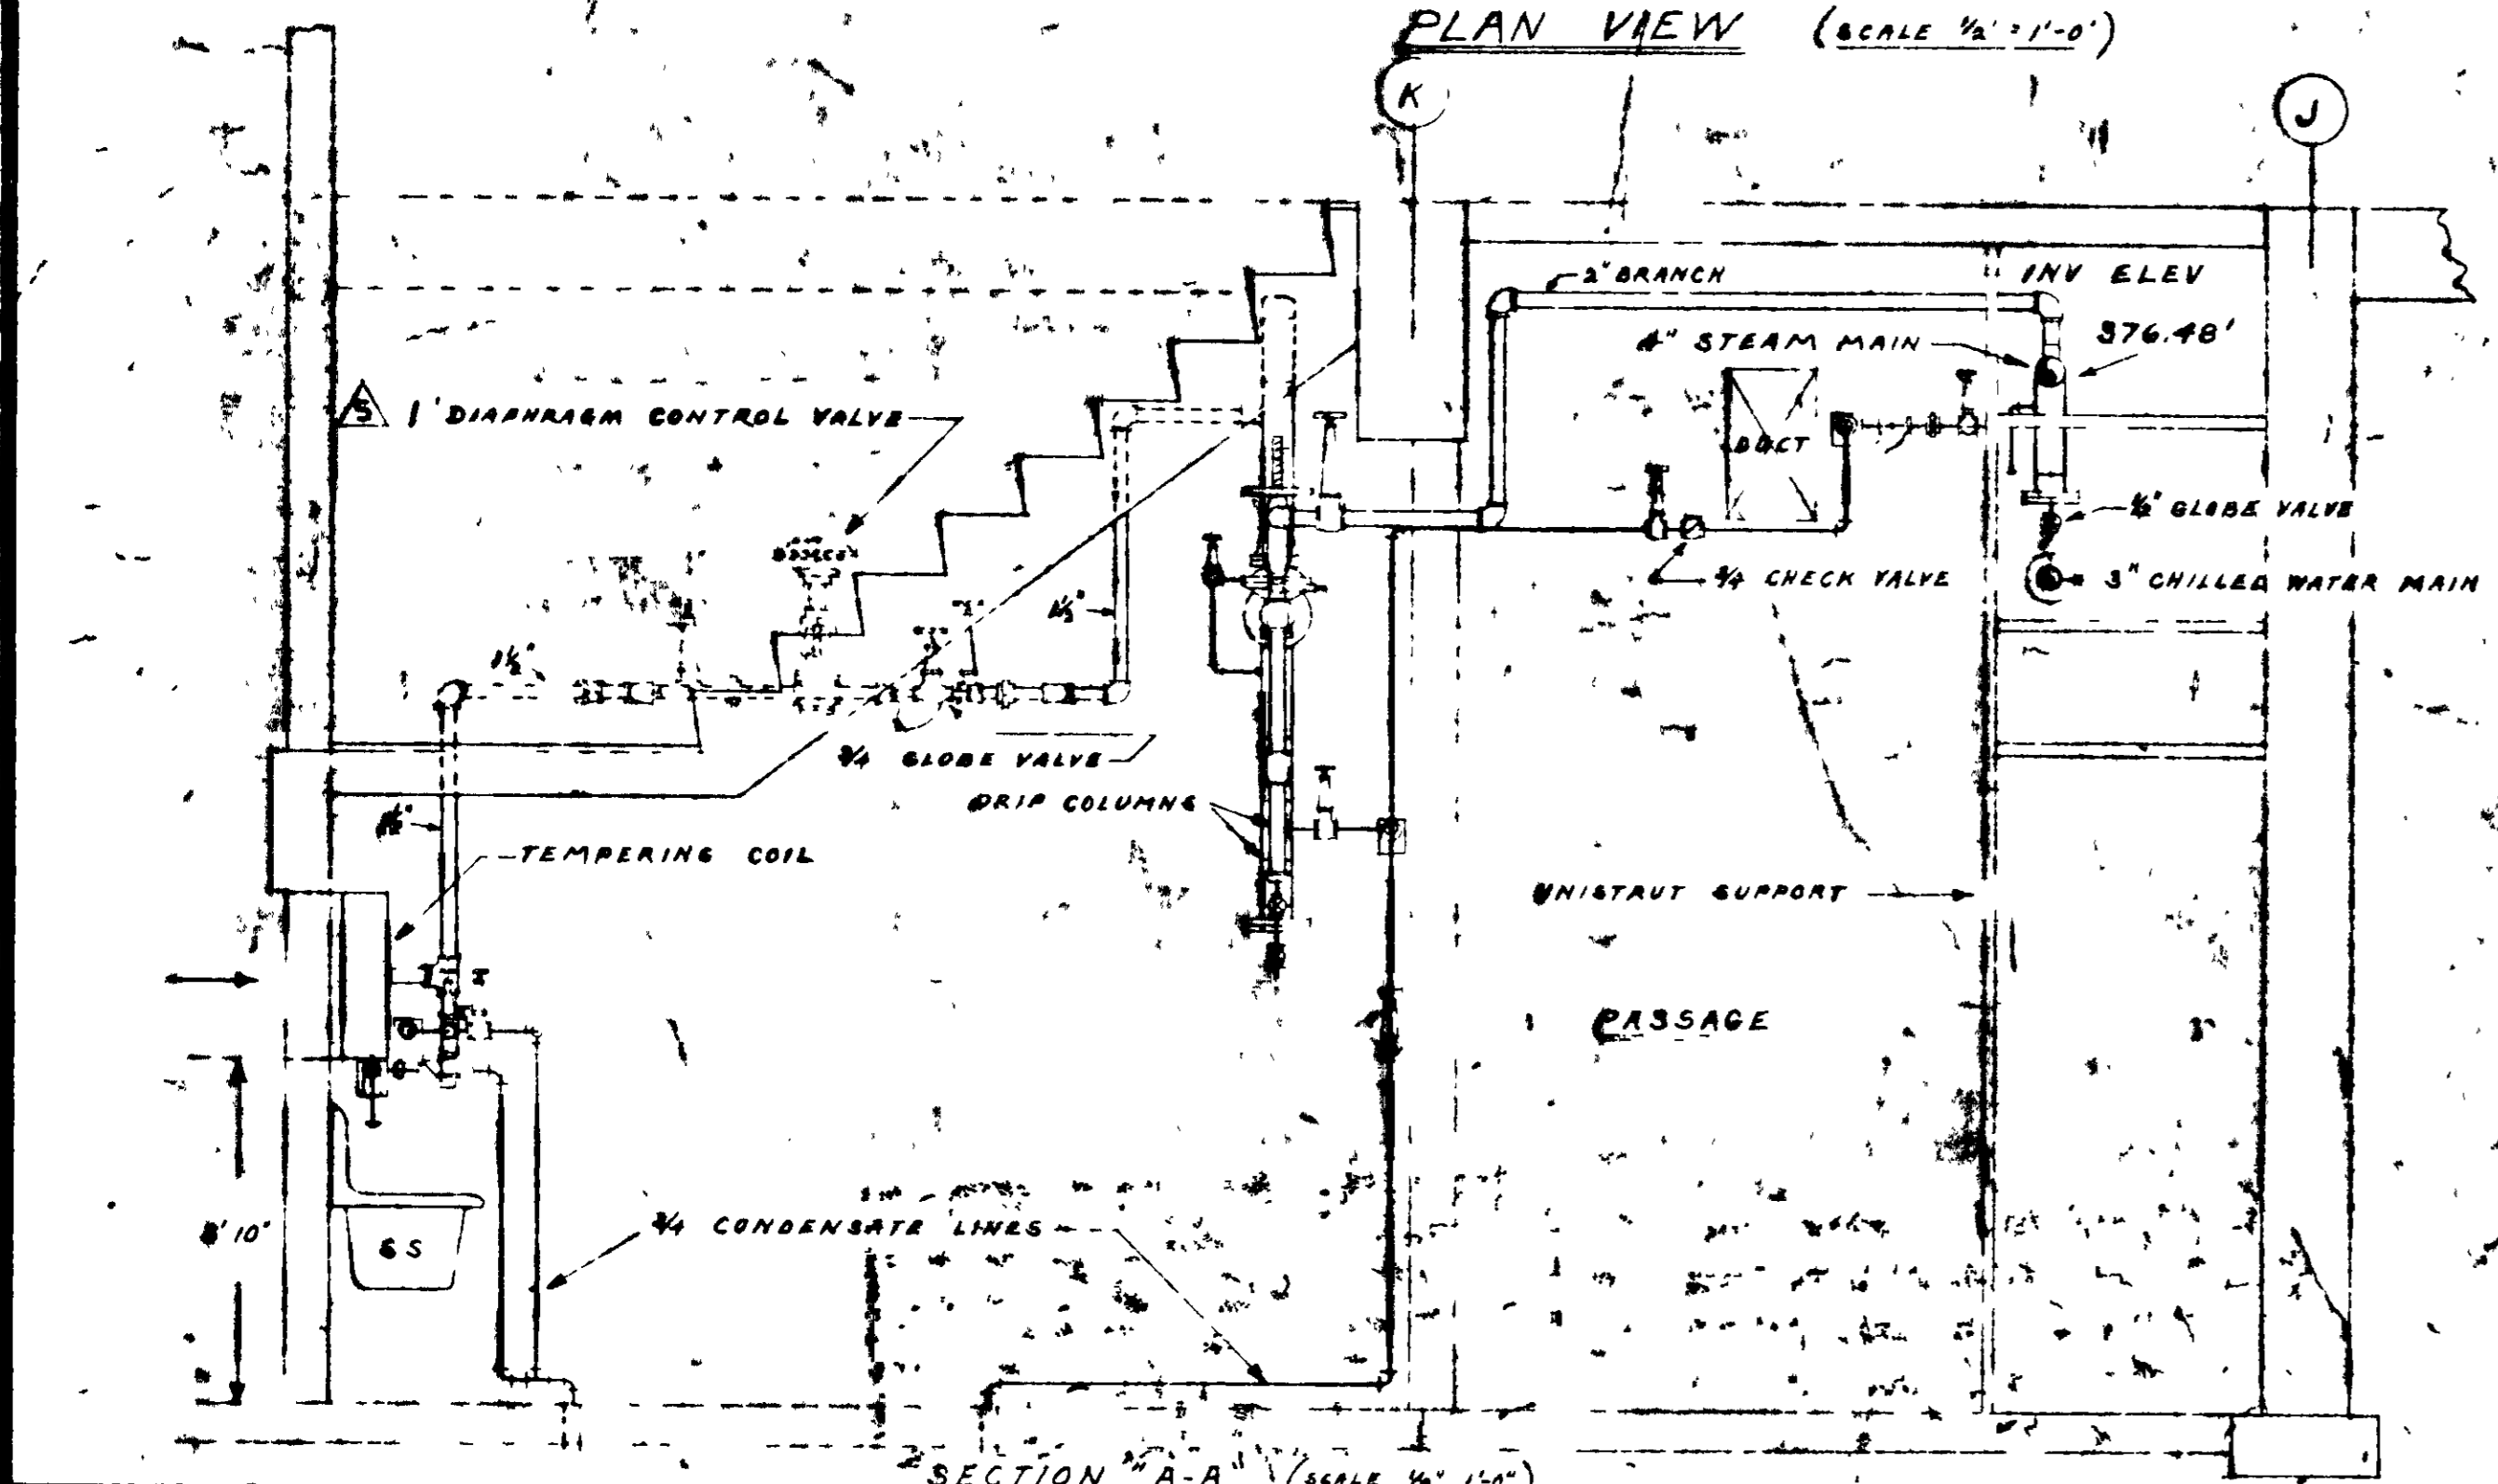

BT Images, Inc
 00000632

6	11/6/51	AS BUILT	4/24/53
5	4/28/52	DEVIATION REQUEST NO 760M	DR
4	4/24/52	REVISION REQUEST NO 542	DR
3	3/26/52	REVISION REQUEST NO 458	DR
2	1-31-52	CONSTRUCTION	W-1-31-52
1	1/24/52	APPROVAL	AEC HW

UNITED STATES
 ATOMIC ENERGY COMMISSION

SMITH, HINCHMAN & GRYLLS, INC.
 ARCHITECTS & ENGINEERS
 DETROIT 26, MICHIGAN

PIPING LAYOUT - STEAM
 SOUTHWEST EQUIPMENT ROOM

DESIGNED BY	DATE	CHECKED BY	DATE
APPROVED BY	DATE	APPROVED BY	DATE

8768

ADMINISTRATION C-100

B1-40

UNCLASSIFIED