


FIRST FLOOR PLAN  
 SCALE: 1/16" = 1'-0"

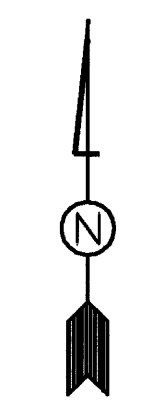

BT Images, Inc.  
 00094059

REVIEWED FOR CLASSIFICATION  
 CRB 06/06/2014  
 Initials Date UNCLASSIFIED

REVIEWED FOR CLASSIFICATION  
 KTW 11/9/98  
 Initials Date UNCLASSIFIED

COMPANION DRAWING  
 B1-5-A

SECTION NUMBER OR DETAIL LETTER	SECTION AND DETAIL KEY
(Symbol: circle with crosshair)	(Symbol: circle with crosshair)

SECTION AND DETAIL KEY

TOLERANCES UNLESS OTHERWISE SPECIFIED		FRACTIONS ±1/16"		XX DECIMALS		XXX DECIMALS		ANGLES		BREAK SHARP EDGES MIN. FINISH	
DRW	RED	SE	APPD	DATE	REV. NO.	AS BUILT					

DRW: KTW  
 CHKD: J.W. Brown, Jr.  
 RED: J.S. A. Hall  
 TR: J.S. A. Hall  
 APPD: J.S. A. Hall

LOCKHEED MARTIN LOCKHEED MARTIN UTILITY SERVICES, INC.  
 P.O. BOX 1410 PADUCAH, KENTUCKY 42001  
 ACTING UNDER CONTRACT USEC-HQ-93-C-0001 WITH THE U.S. ENRICHMENT CORPORATION

C-100 ADMINISTRATION BUILDING  
 FIRST FLOOR PLAN  
 PRIORITY 3

SCALE: 1/16" = 1'-0"  
 PLANT PGDP: C-100  
 BLDG FL: 1  
 SHEET OF: 1  
 CLASS: U  
 ID: Z98550  
 REV: 0

"NO REPRESENTATION OR WARRANTY, EXPRESSED OR IMPLIED, IS MADE THAT THE USE OR DISCLOSURE OF ANY INFORMATION, APPARATUS, METHOD OR PROCESS DISCLOSED IN THESE DRAWINGS MAY NOT INFRINGE PRIVATE RIGHTS OF OTHERS. NO LIABILITY IS ASSUMED WITH RESPECT TO THE USE OF, OR FOR DAMAGES RESULTING FROM THE USE, ANY INFORMATION, APPARATUS, METHOD OR PROCESS DISCLOSED IN THESE DRAWINGS. THE DRAWINGS ARE BEING MADE FOR INFORMATION TO BIDDER AND ARE NOT TO BE USED FOR OTHER PURPOSES, AND ARE TO BE RETURNED UPON REQUEST OF THE FORWARDING CONTRACTOR."

DATE	DRW	CHKD	RED	TR	APPD	A-E	REVISION OR ISSUE	APPROVALS
	X	X	X	X	X	X	AS BUILT FOR ESO Z98550 & PR-97-1326	
							ISSUE / REVISION DESCRIPTION	

DRAWING APPROVALS  
 DATE