SCALE	PLANT	BLDG	FL	SHEET	OF	CLASS
1/8" = 1'-0"	PGDP	C-100	2	1	1	U

ID	REV
Z9855O	0

B1-6-A01

C-100 ADMINISTRATION BUILDING
SECOND FLOOR PLAN
PRIORITY 3

LOCKHEED MARTIN UTILITY SERVICES, INC.
P.O. BOX 1410 PADUCAH, KENTUCKY 42001
ACTING UNDER CONTRACT USEC-MO-93-C-0001 WITH THE U.S. ENRICHMENT CORPORATION

DRW	R.T. Cobb	11/5/98
CHKR	Dale A. Hickerson	11/6/98
RED		
TR		
APPD	Shawn Wade	11/6/98

DRAWING APPROVALS	DATE
A-E	

REVISION OR ISSUE APPROVALS											
DATE	DRW	CHKR	RED	TR	APPD	A-E					
X	X	X	X	X	X	X					

ISSUE / REVISION DESCRIPTION
AS BUILT FOR ESO Z9855O & PR-EN-97-1326

AS BUILT					
REV. NO.	DRW	RED	SE	APPD	DATE
0					

"NO REPRESENTATION OR WARRANTY, EXPRESSED OR IMPLIED, IS MADE THAT THE USE OR DISCLOSURE OF ANY INFORMATION, APPARATUS, METHOD OR PROCESS DISCLOSED IN THESE DRAWINGS MAY NOT INFRINGE PRIVATE RIGHTS OF OTHERS. NO LIABILITY IS ASSUMED WITH RESPECT TO THE USE OF, OR FOR DAMAGES RESULTING FROM THE USE, ANY INFORMATION, APPARATUS, METHOD OR PROCESS DISCLOSED IN THESE DRAWINGS. THE DRAWINGS ARE BEING MADE FOR INFORMATION TO BIDDER AND ARE NOT TO BE USED FOR OTHER PURPOSES, AND ARE TO BE RETURNED UPON REQUEST OF THE FORWARDING CONTRACTOR."

SECTION AND DETAIL KEY

SECTION NUMBER OR DETAIL LETTER

DRAWING ON WHICH SECTION OR DETAIL IS TAKEN

DRAWING ON WHICH SECTION OR DETAIL IS SHOWN

UNLESS OTHERWISE SPECIFIED
FRACTIONS ±1/16"
XX DECIMALS
XXX DECIMALS
ANGLES
BREAK SHARP EDGES MAX.
FINISH

REVIEWED FOR CLASSIFICATION
GHM 07/29/2014
Initials Date
UNCLASSIFIED

REVIEWED FOR CLASSIFICATION
Initials Date 11.6.98
UNCLASSIFIED

COMPANION DRAWING
B1-6-A

BT Images, Inc.
00094013

SECOND FLOOR PLAN
SCALE: 1/8" = 1'-0"

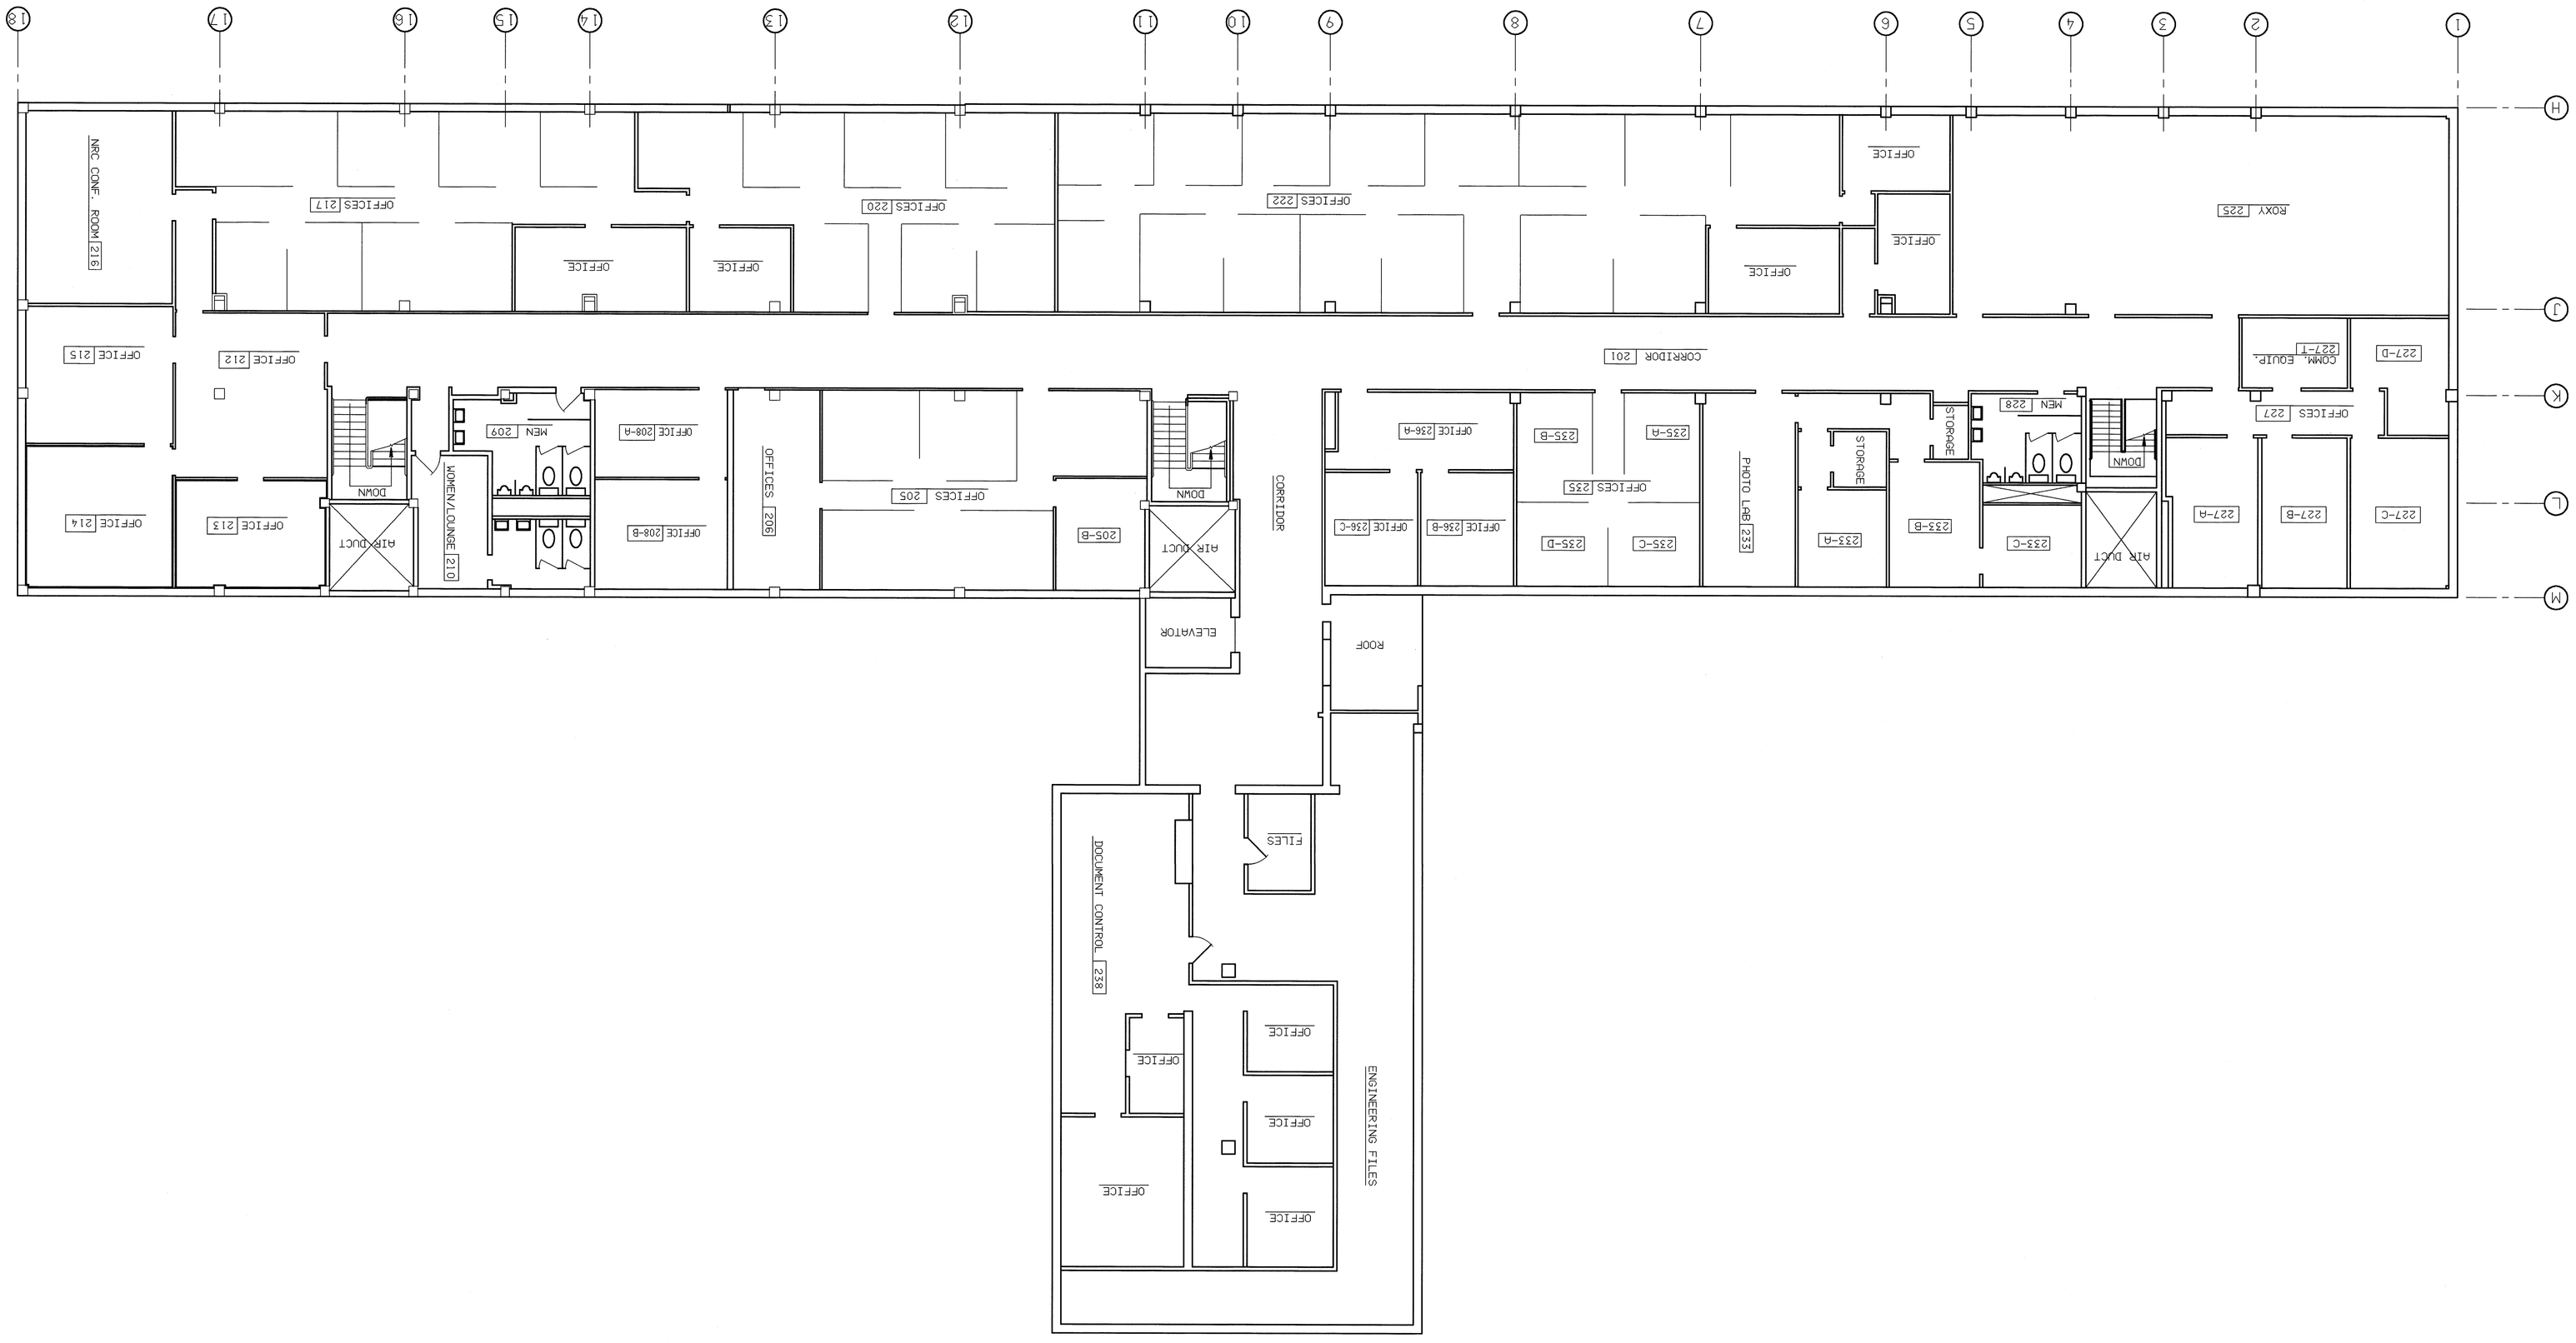

UNCLASSIFIED

NEXT ASS'Y:
FINAL ASS'Y: