RESTRICTED
SECURITY INFORMATION

Unclassified

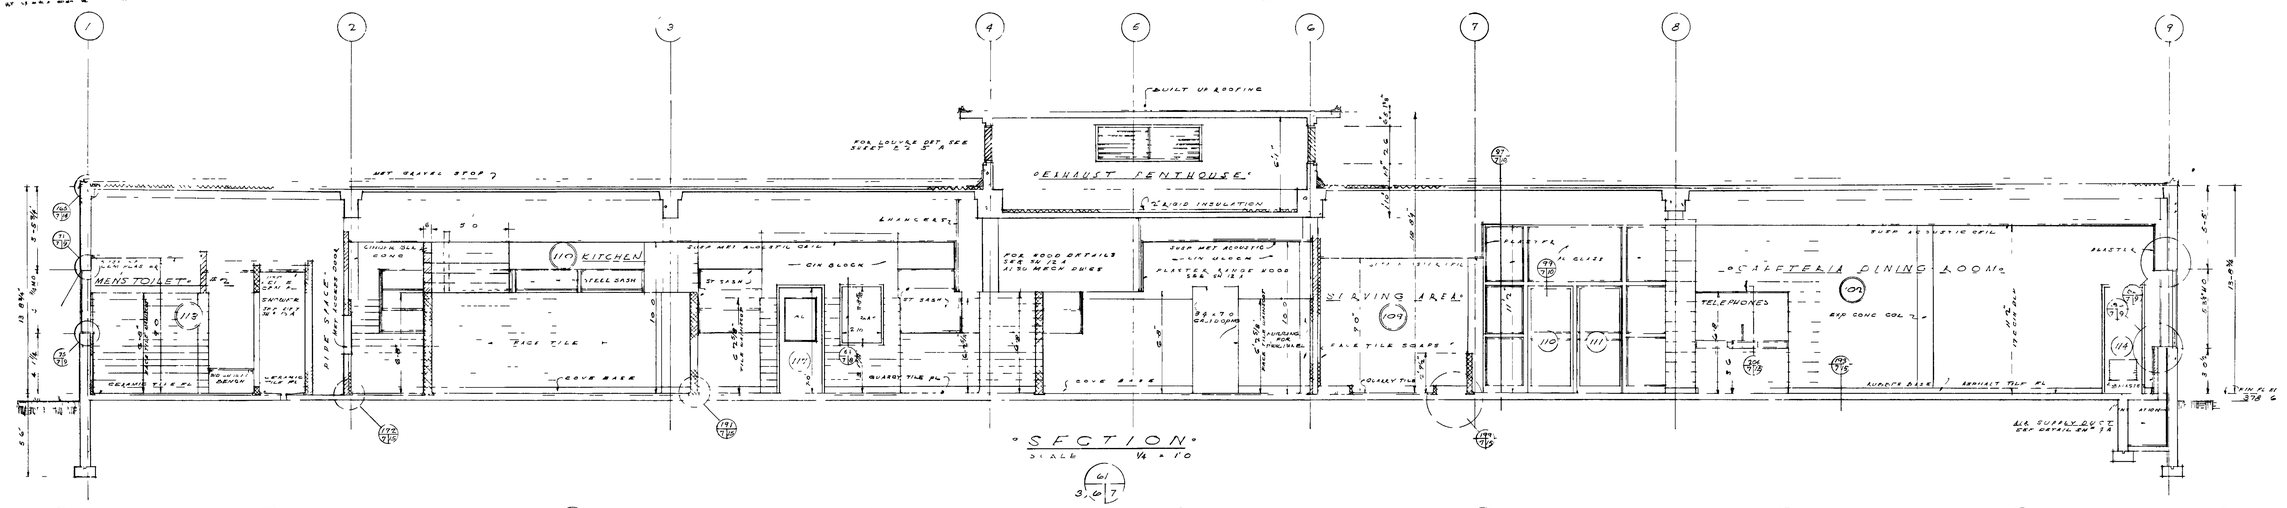

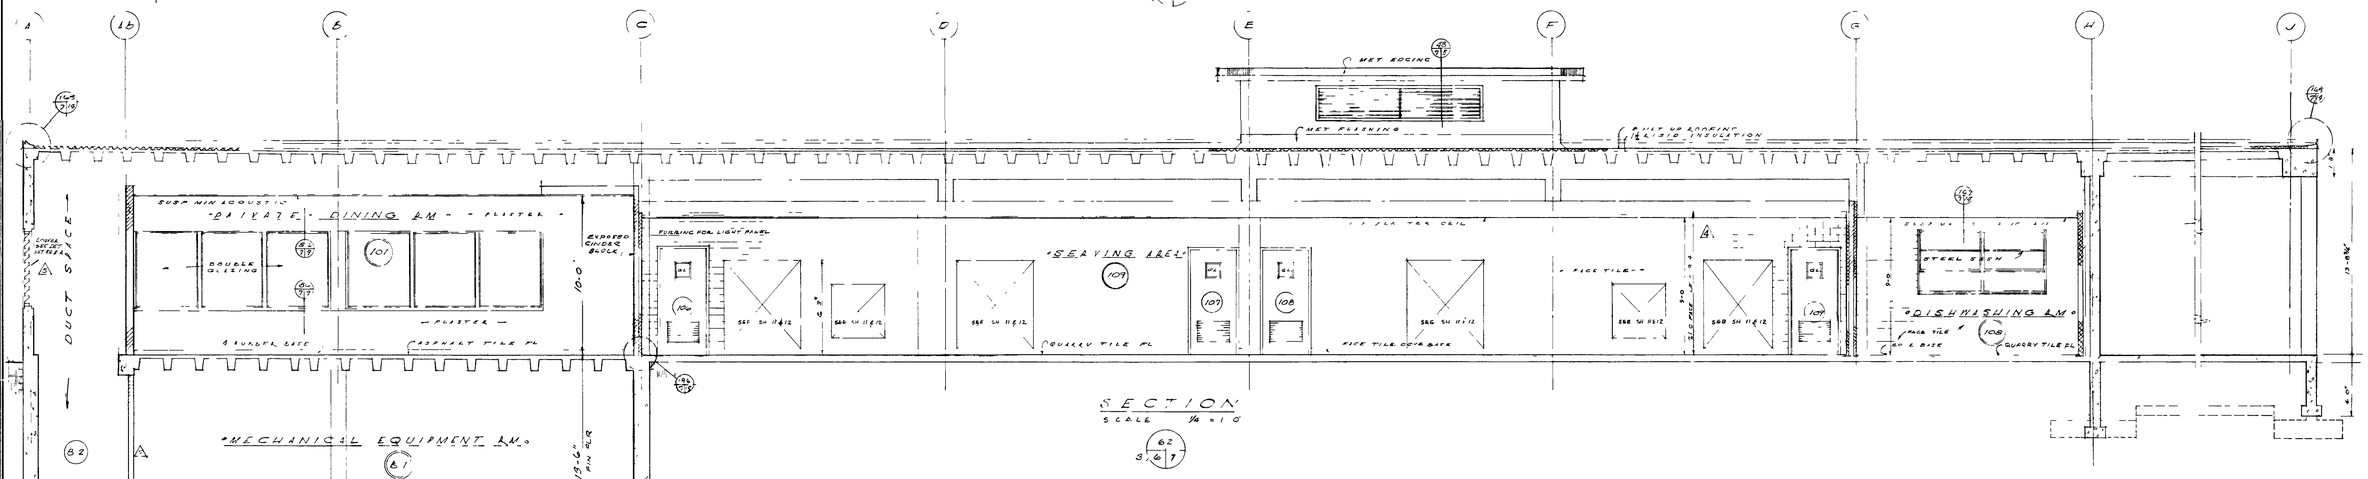

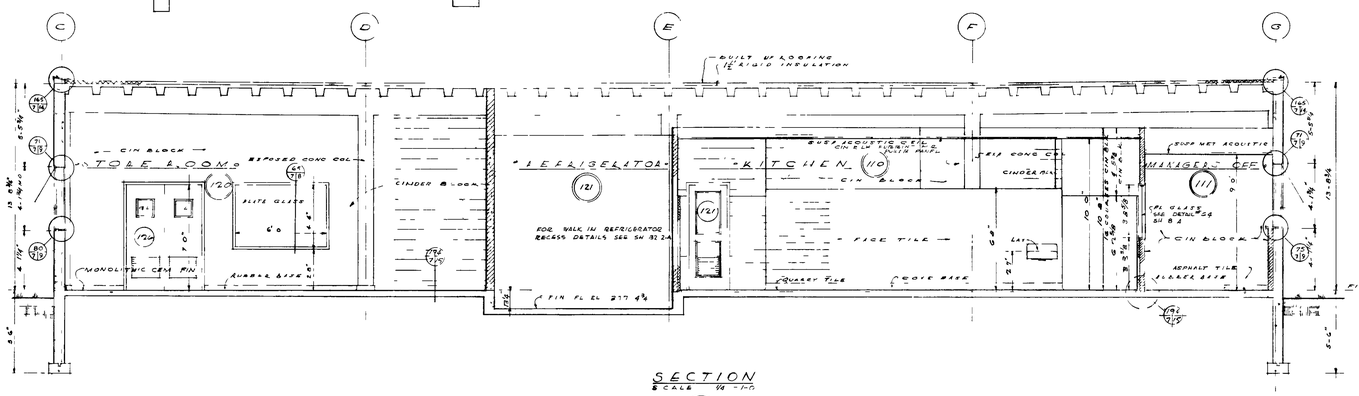

REVIEWED FOR CLASSIFICATION
SM 06/04/2014
Initials Date
UNCLASSIFIED

DERIVATIVE CLASSIFIER
Unclassified

DETAIL NUMBER
SHEET DETAIL LOCATED ON
SHEET DETAIL DRAWN ON

CLASSIFICATION CHANGED TO Unclassified
Insert Appropriate Classification Level and Category(ies) (Date)
By Authority of (Authority) Doe Ltr. 8/12/97
By (Signature) Gary Wilson ADC 2/2/98
Verified by (Signature) WJ Turner 2/2/98 (Date)
Mart n Marietta PGDP

DERIVATIVE CLASSIFIER
1ST REVIEWER
Authority (CNEI)
Date 8/24/94
2ND REVIEWER
(Name)
AUTHORITY ADD
DATE
CLASSIFIED BY
DERIVATIVE CLASSIFICATION REVIEW
CLASSIFICATION REMAINED
CLASSIFICATION CHANGED TO
DOE CLASSIFIED
1. CLASSIFIED WITH
2. CLASSIFICATION CANCELLED
3. CLASSIFIED INFORMATION BRACKETED
4. OTHER (SPECIFY)

BT Images, Inc
00000860

REV NO	DATE	ISSUED FOR	BY	APP DATE
8	11 16 53	AS BUILT DEV REQ 1061 A ADDED	GD	11 16 53
7	8 13 53	DEVIATION REQUEST NO 1000 A		
6	6 11 53	DEVIATION REQ EST NO 957 A		
5	5/28/52	REVISION REQUEST NO 617		
4	1 28 52	REVISION REQUEST # 264		
3	12/2 51	REVISION REQUEST # 46 126		
2	10 27 51	CONSTRUCTION B		9 20 51
1	9/12/51	A & C APPROVAL		

UNITED STATES
ATOMIC ENERGY COMMISSION

SMITH, HINCHMAN & GRYLLS, INC
ARCHITECTS & ENGINEERS
DETROIT 26, MICHIGAN

DRAWING TITLE

BUILDING SECTIONS

DRAWING APPROVED DATE	DRAWING APPROVED DATE	DRAWING APPROVED DATE
O J Kirkbride 9 20 51	L A WALKER 9 20 51	R J BROWN 9 20 51
ARCHITECT ENGINEER	CARBIDE CARBON CHEM. DIV.	A.E.C. ENGINEER
DRAWN STONER	DATE 9/12	CHECKED L F L
IN CHARGE J STONER	DATE 9/12-51	CHIEF [illegible]
PROJECT "C" PLANT	BUILDING CAFETERIA C-101	SHEET B2-7-A

DRAWING NO. 8768

MICROFILMED