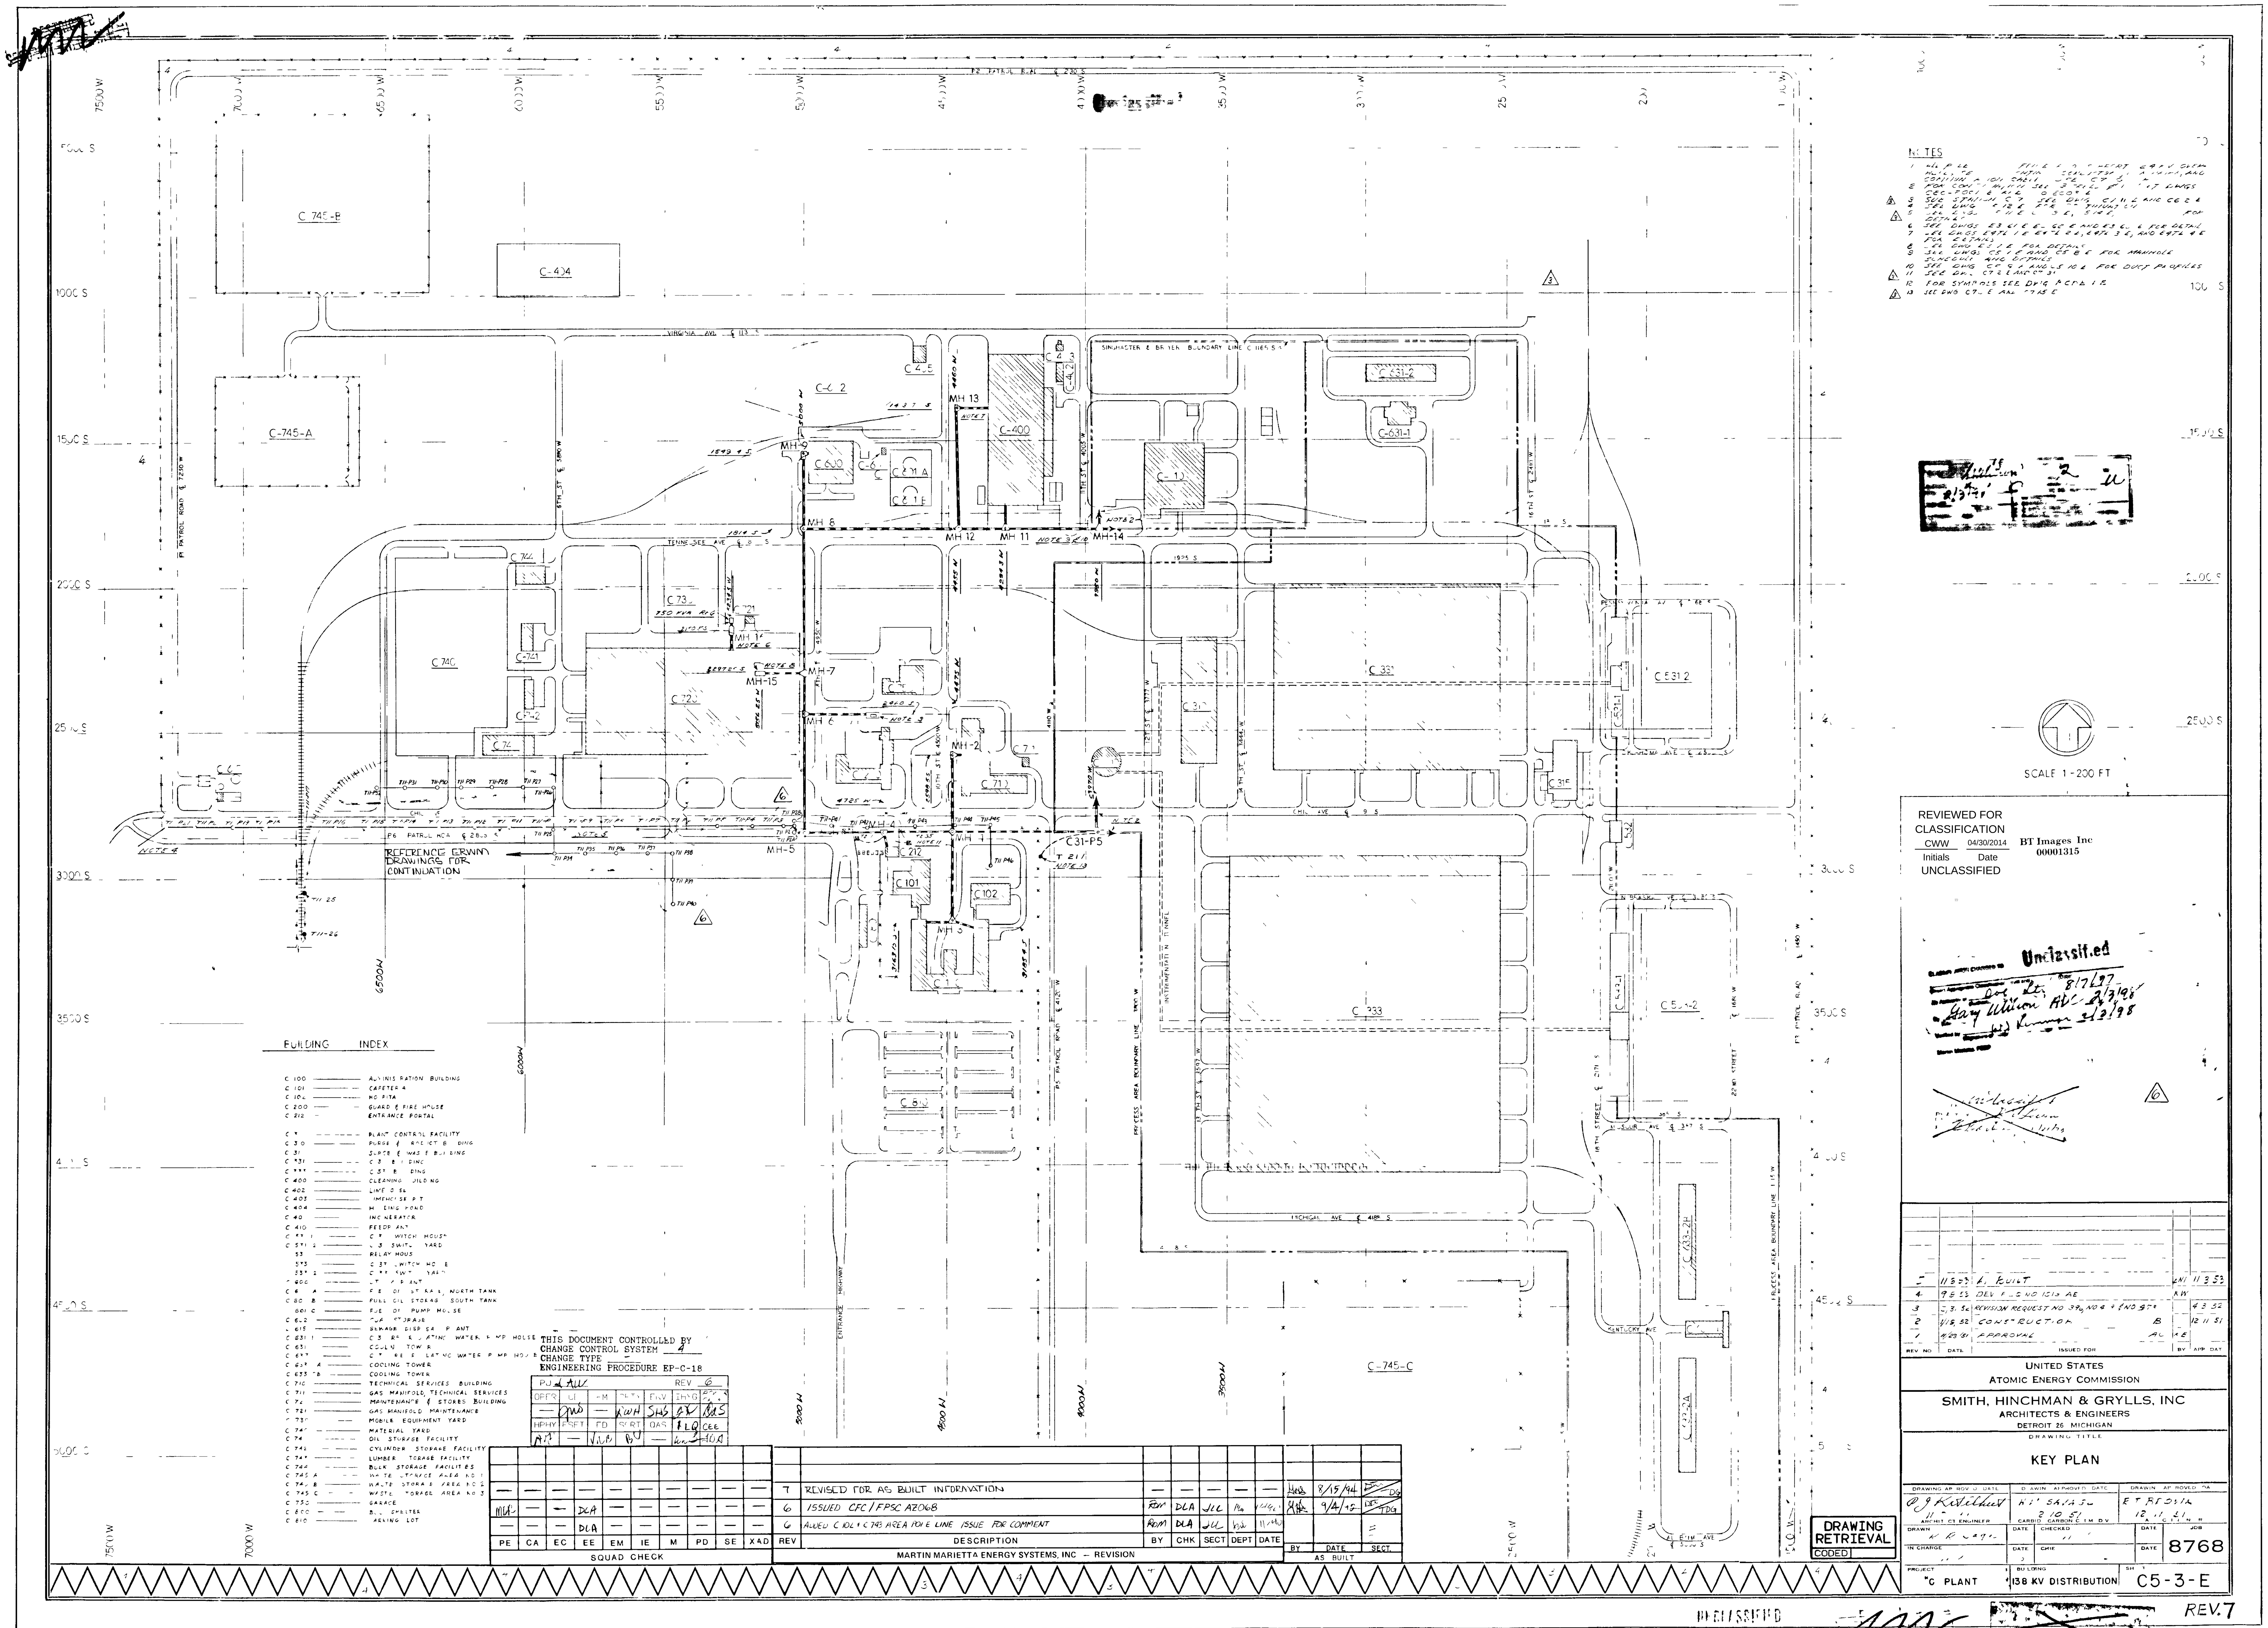

KEY PLAN
UNITED STATES
ATOMIC ENERGY COMMISSION
SMITH, HINCHMAN & GRYLLS, INC
ARCHITECTS & ENGINEERS
DETROIT 26 MICHIGAN
DRAWING TITLE
PROJECT C PLANT
BUILDING 138 KV DISTRIBUTION
JOB 8768
C5-3-E
REV.7
DRAWING RETRIEVAL
CODED
SCALE 1-200 FT
REVIEWED FOR CLASSIFICATION
CWW 04/30/2014
Initials Date
UNCLASSIFIED
BT Images Inc
00001315
Unclassified
MICROFILMED
THIS DOCUMENT CONTROLLED BY
CHANGE CONTROL SYSTEM 4
CHANGE TYPE
ENGINEERING PROCEDURE EP-C-18
REV 6
7 REVISED FOR AS BUILT INFORMATION 8/15/94
6 ISSUED CFC/FPSC AZ068 RDM DLA JLC 9/4/95
6 ADDED C 102 + C 743 AREA POLE LINE ISSUE FOR COMMENT RDM DLA JLC
REV DESCRIPTION BY CHK SECT DEPT DATE
MARTIN MARIETTA ENERGY SYSTEMS, INC — REVISION
BY DATE SECT.
AS BUILT
PE CA EC EE EM IE M PD SE XAD
SQUAD CHECK
5 11 3 53 AS BUILT
4 9 5 53
3 REVISION REQUEST NO 39
2 1/15 52 CONSTRUCTION
1 11/23/51 APPROVAL
REV NO DATE ISSUED FOR BY APP DAT
NOTES
12 FOR SYMBOLS SEE DWG
BUILDING INDEX
C 100 ADMINISTRATION BUILDING
C 101 CAFETERIA
C 200 GUARD & FIRE HOUSE
C 212 ENTRANCE PORTAL
C 400 CLEANING BUILDING
C 410 FEED PLANT
C 600 STEAM PLANT
C 601 B FUEL OIL STORAGE SOUTH TANK
C 615 SEWAGE DISPOSAL PLANT
C 633 A COOLING TOWER
C 710 TECHNICAL SERVICES BUILDING
C 711 GAS MANIFOLD, TECHNICAL SERVICES
C 720 MAINTENANCE & STORES BUILDING
C 721 GAS MANIFOLD MAINTENANCE
C 730 MOBILE EQUIPMENT YARD
C 740 MATERIAL YARD
C 741 OIL STORAGE FACILITY
C 742 CYLINDER STORAGE FACILITY
C 743 LUMBER STORAGE FACILITY
C 744 BULK STORAGE FACILITIES
C 745 A WASTE STORAGE AREA NO 1
C 745 B WASTE STORAGE AREA NO 2
C 745 C WASTE STORAGE AREA NO 3
C 750 GARAGE
C 800 BUS SHELTER
C 810 PARKING LOT
C 745-B
C 745-A
C-404
C 740
C 720
C-400
C 331
C 333
C 531 2
C-631-1
C-631-2
C 101
C 102
C 212
C 810
C-745-C
MH 13
MH 12
MH 11
MH-14
MH-15
MH-7
MH-5
C31-P5
VIRGINIA AVE
TENNESSEE AVE
MICHIGAN AVE
KENTUCKY AVE
ENTRANCE HIGHWAY
P5 PATROL ROAD
PROCESS AREA BOUNDARY LINE
REFERENCE ERWM DRAWINGS FOR CONTINUATION