

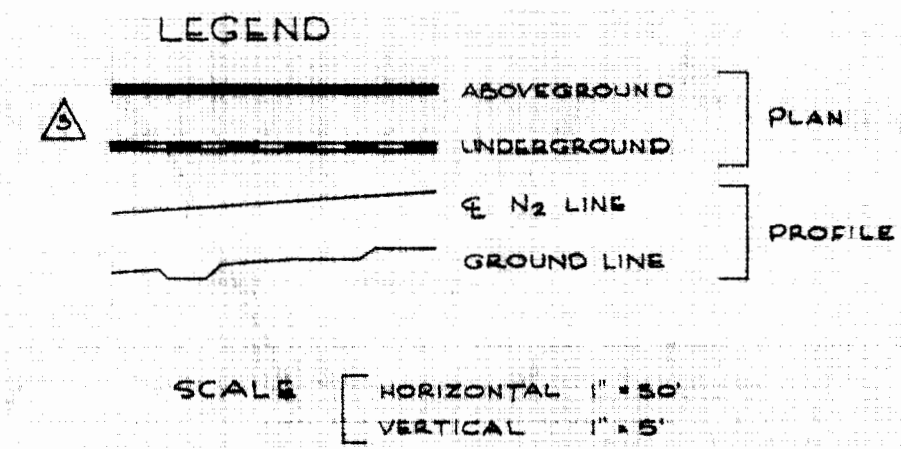
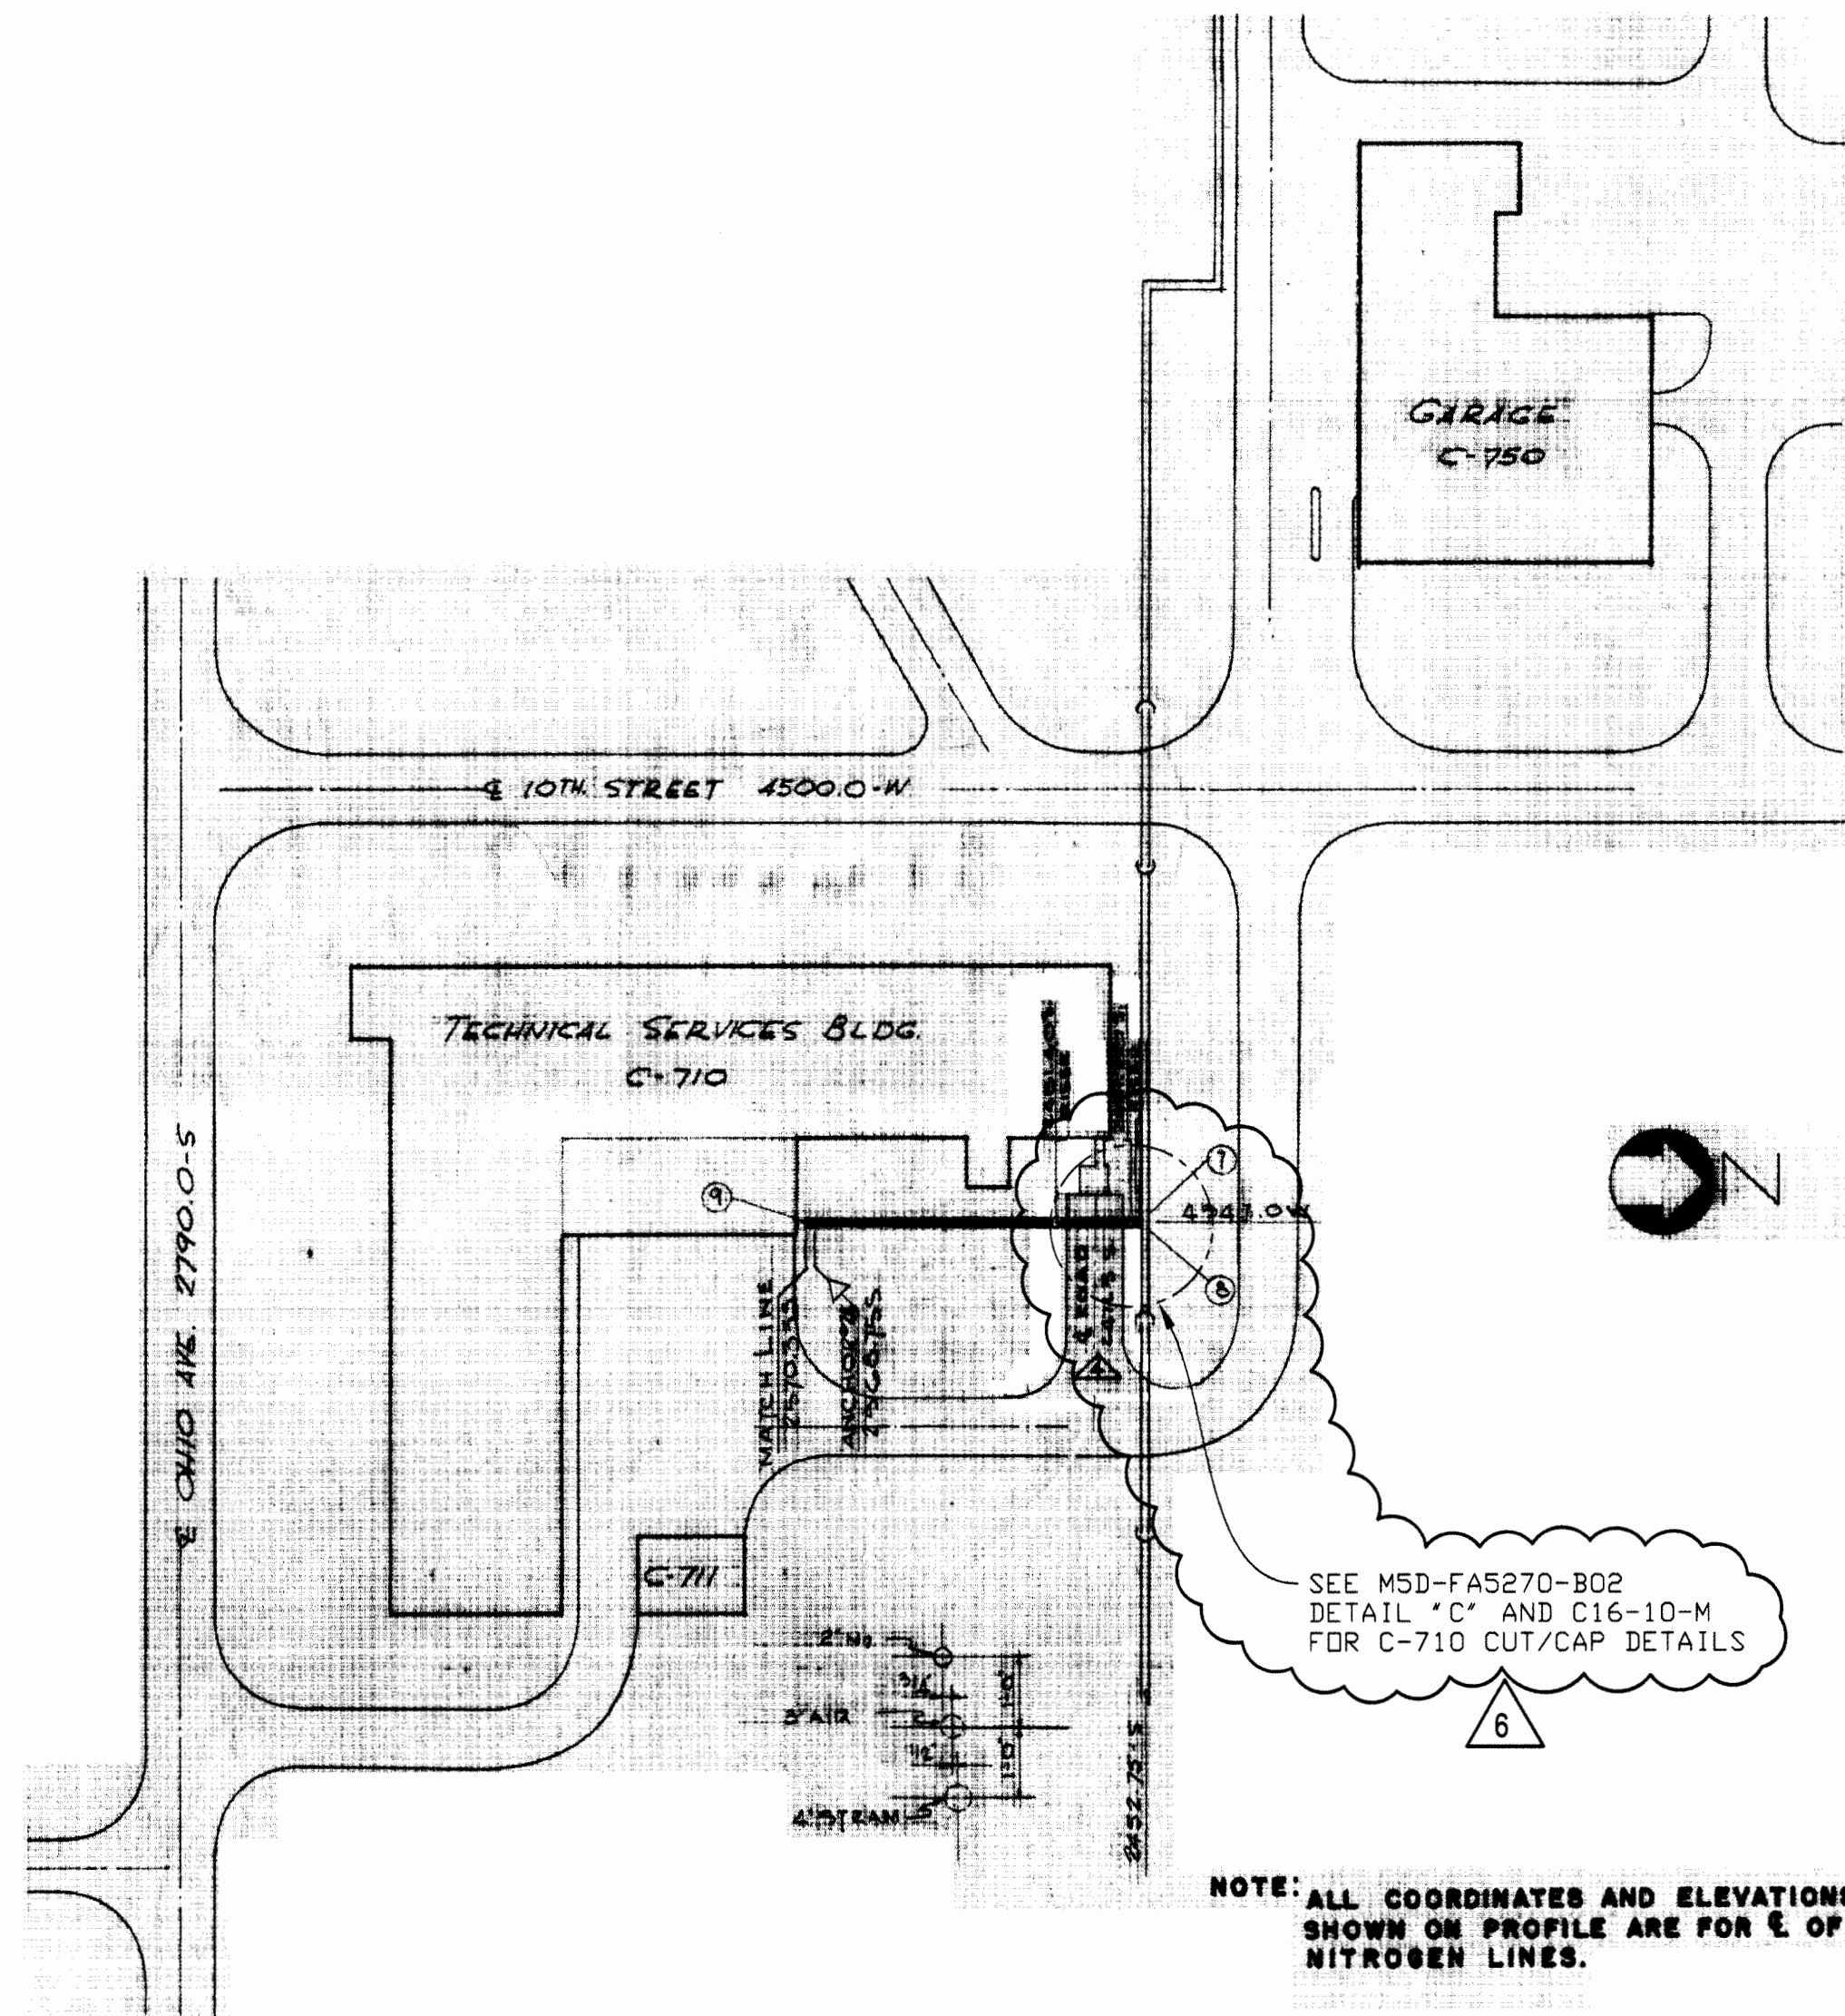


NOTE: ALL COORDINATES SHOWN ON PLAN ARE FOR E OF PIPE SUPPORTS. SEE DWG. C16-1-8

Unclassified

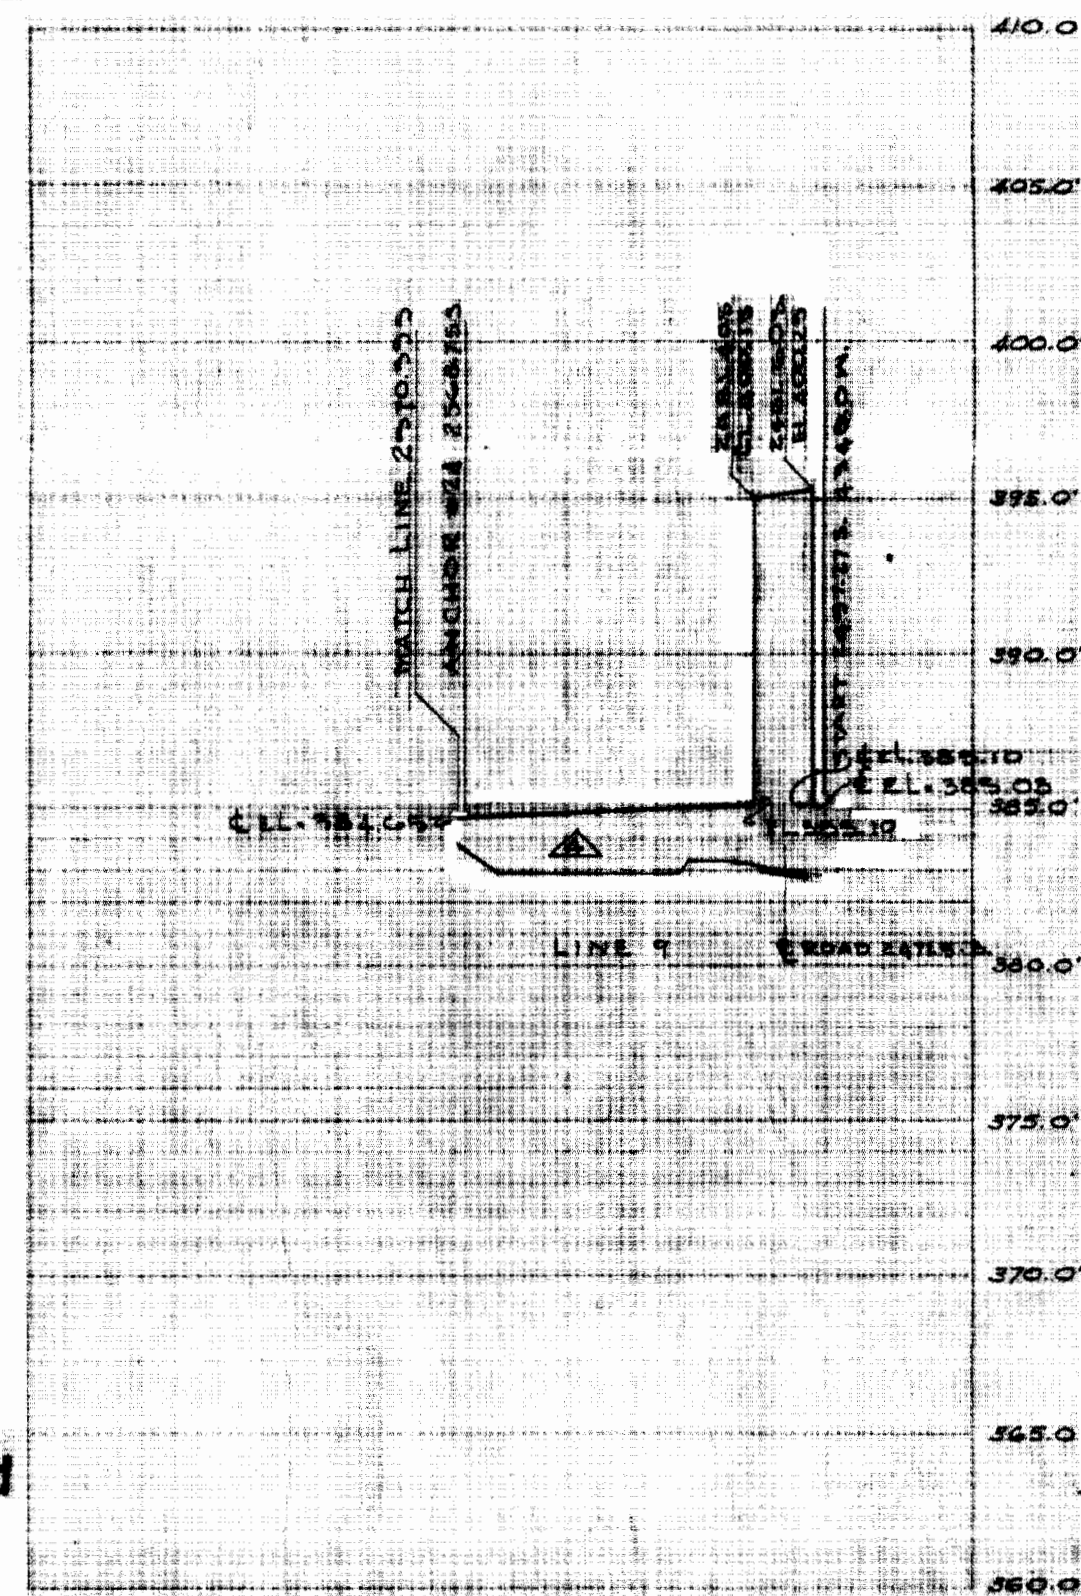

NOTE: ALL COORDINATES AND ELEVATIONS SHOWN ON PROFILE ARE FOR E OF NITROGEN LINES.

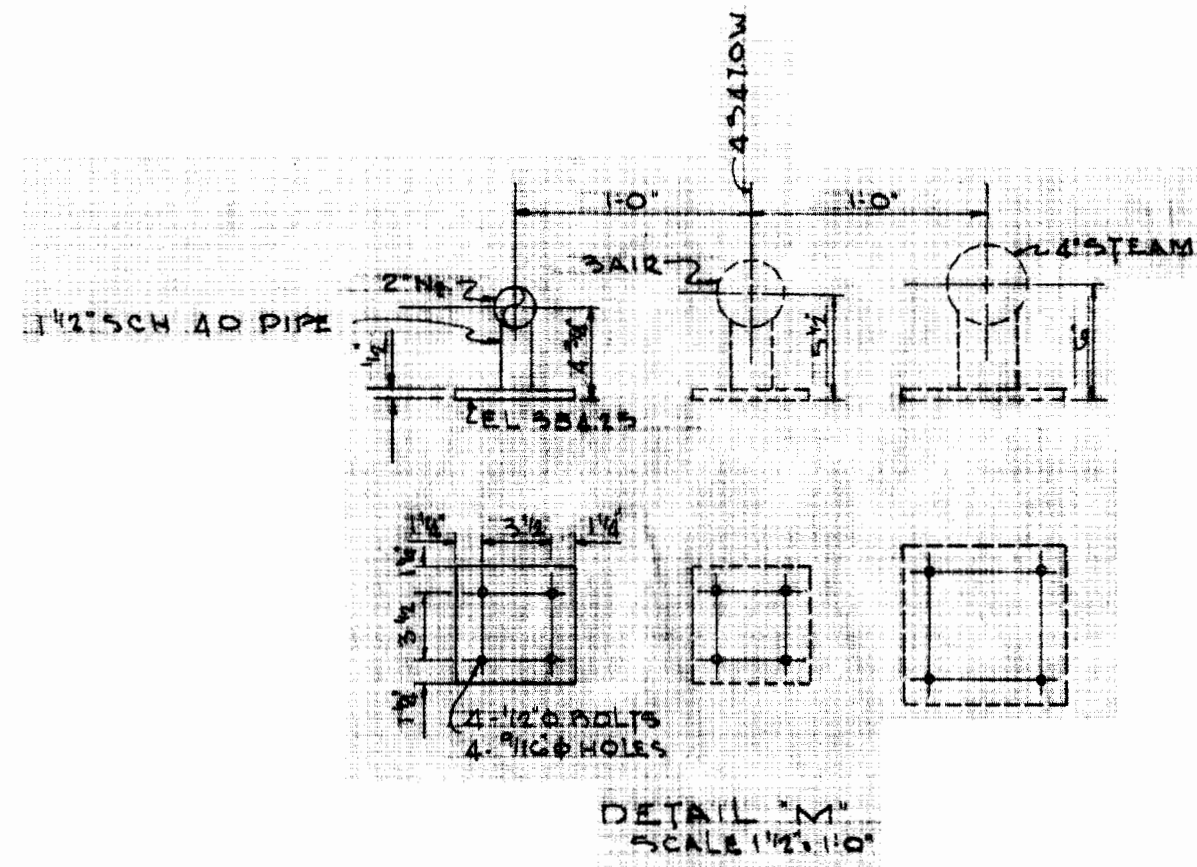

Unclassified

CLASSIFICATION CHANGED TO **Unclassified**
 By Authority of *[Signature]* 1/24/08
 Date *[Signature]* 1/24/08


Unclassified

REV.	6
DRW.	<i>[Signature]</i> 3/27/08
CHKR.	<i>[Signature]</i> 3/27/08
RE.	<i>[Signature]</i> 3/23/08
T.R.	N/A
APPR.	<i>[Signature]</i> 3/23/08
DRAWING APPROVALS	DATE

PRIORITY 3

FOUR RIVERS
 NUCLEAR PARTNERSHIP, LLC
 DOE PRIME CONTRACT # DE-EM0004895

6	CERTIFIED FOR CONSTRUCTION FOR ESO FAS270	DATE	1/24/08

UNITED STATES
 ATOMIC ENERGY COMMISSION
 SMITH, HINCHMAN & GRYLLS, INC.
 ARCHITECTS & ENGINEERS
 DETROIT, MICHIGAN

PLANT PROFILE
 NITROGEN DISTRIBUTION
 LINE 9

 DRAWING NUMBER: C16-12-M
 SHEET: 6

UNCLASSIFIED