

Unclassified

BLDG. C337

BLDG. C335

NO	SUPPORT MARK	TYPE	ELEVATION	Y	X	

1ST REVIEWER	DATE	REVISION	REASON
2ND REVIEWER	DATE	REVISION	REASON

THIS SECTION - LINE 16 - SAME AS FOR LINE 15 - LINE COORDINATE EXCEPTED.

CLASSIFICATION CHANGED TO **Unclassified**

DATE: 11/13/11

- NOTE:**
1. PLACE ALL ANCHOR MARKS AT DEPTH GIVEN IN SECTION 5.5.
 2. CARRY ALL PIPE SUPPORT FOOTINGS DOWN TO 800' SOIL.
 3. CONCRETE TO THE YELLOW BANDS 90' DOWN AT 24' SPAC.
 4. LEVEL EXPOSED ENDS OF ALL CONDUITS - 1" I.D.W.
 5. SET IN-BAND MARKS - ALL SETTING SPEEDS 800' AND MARKS USED IN BANDS ON PIS. MARKS MAY BE OMITTED.
 6. PIPES FROM ALL SUPPORTS TO BE STATIONED STRAIGHT.
 7. WELDED CONNECTIONS TO BE USED THROUGHOUT.

SCALE - 1 IN = 50 FT.





UNITED STATES
ATOMIC ENERGY COMMISSION


SMITH, HINCHMAN & GRYLLS, INC.
ARCHITECTS & ENGINEERS
DETROIT, MICHIGAN

**PLACEMENT PLAN
PIPE SUPPORTS & ANCHORS**


PROJECT	LOCATION	REV.
C PLANT EXTENSION	AREA STEAM DISTRIBUTION	C45-1-S 5

PRIORITY 3

UNCLASSIFIED

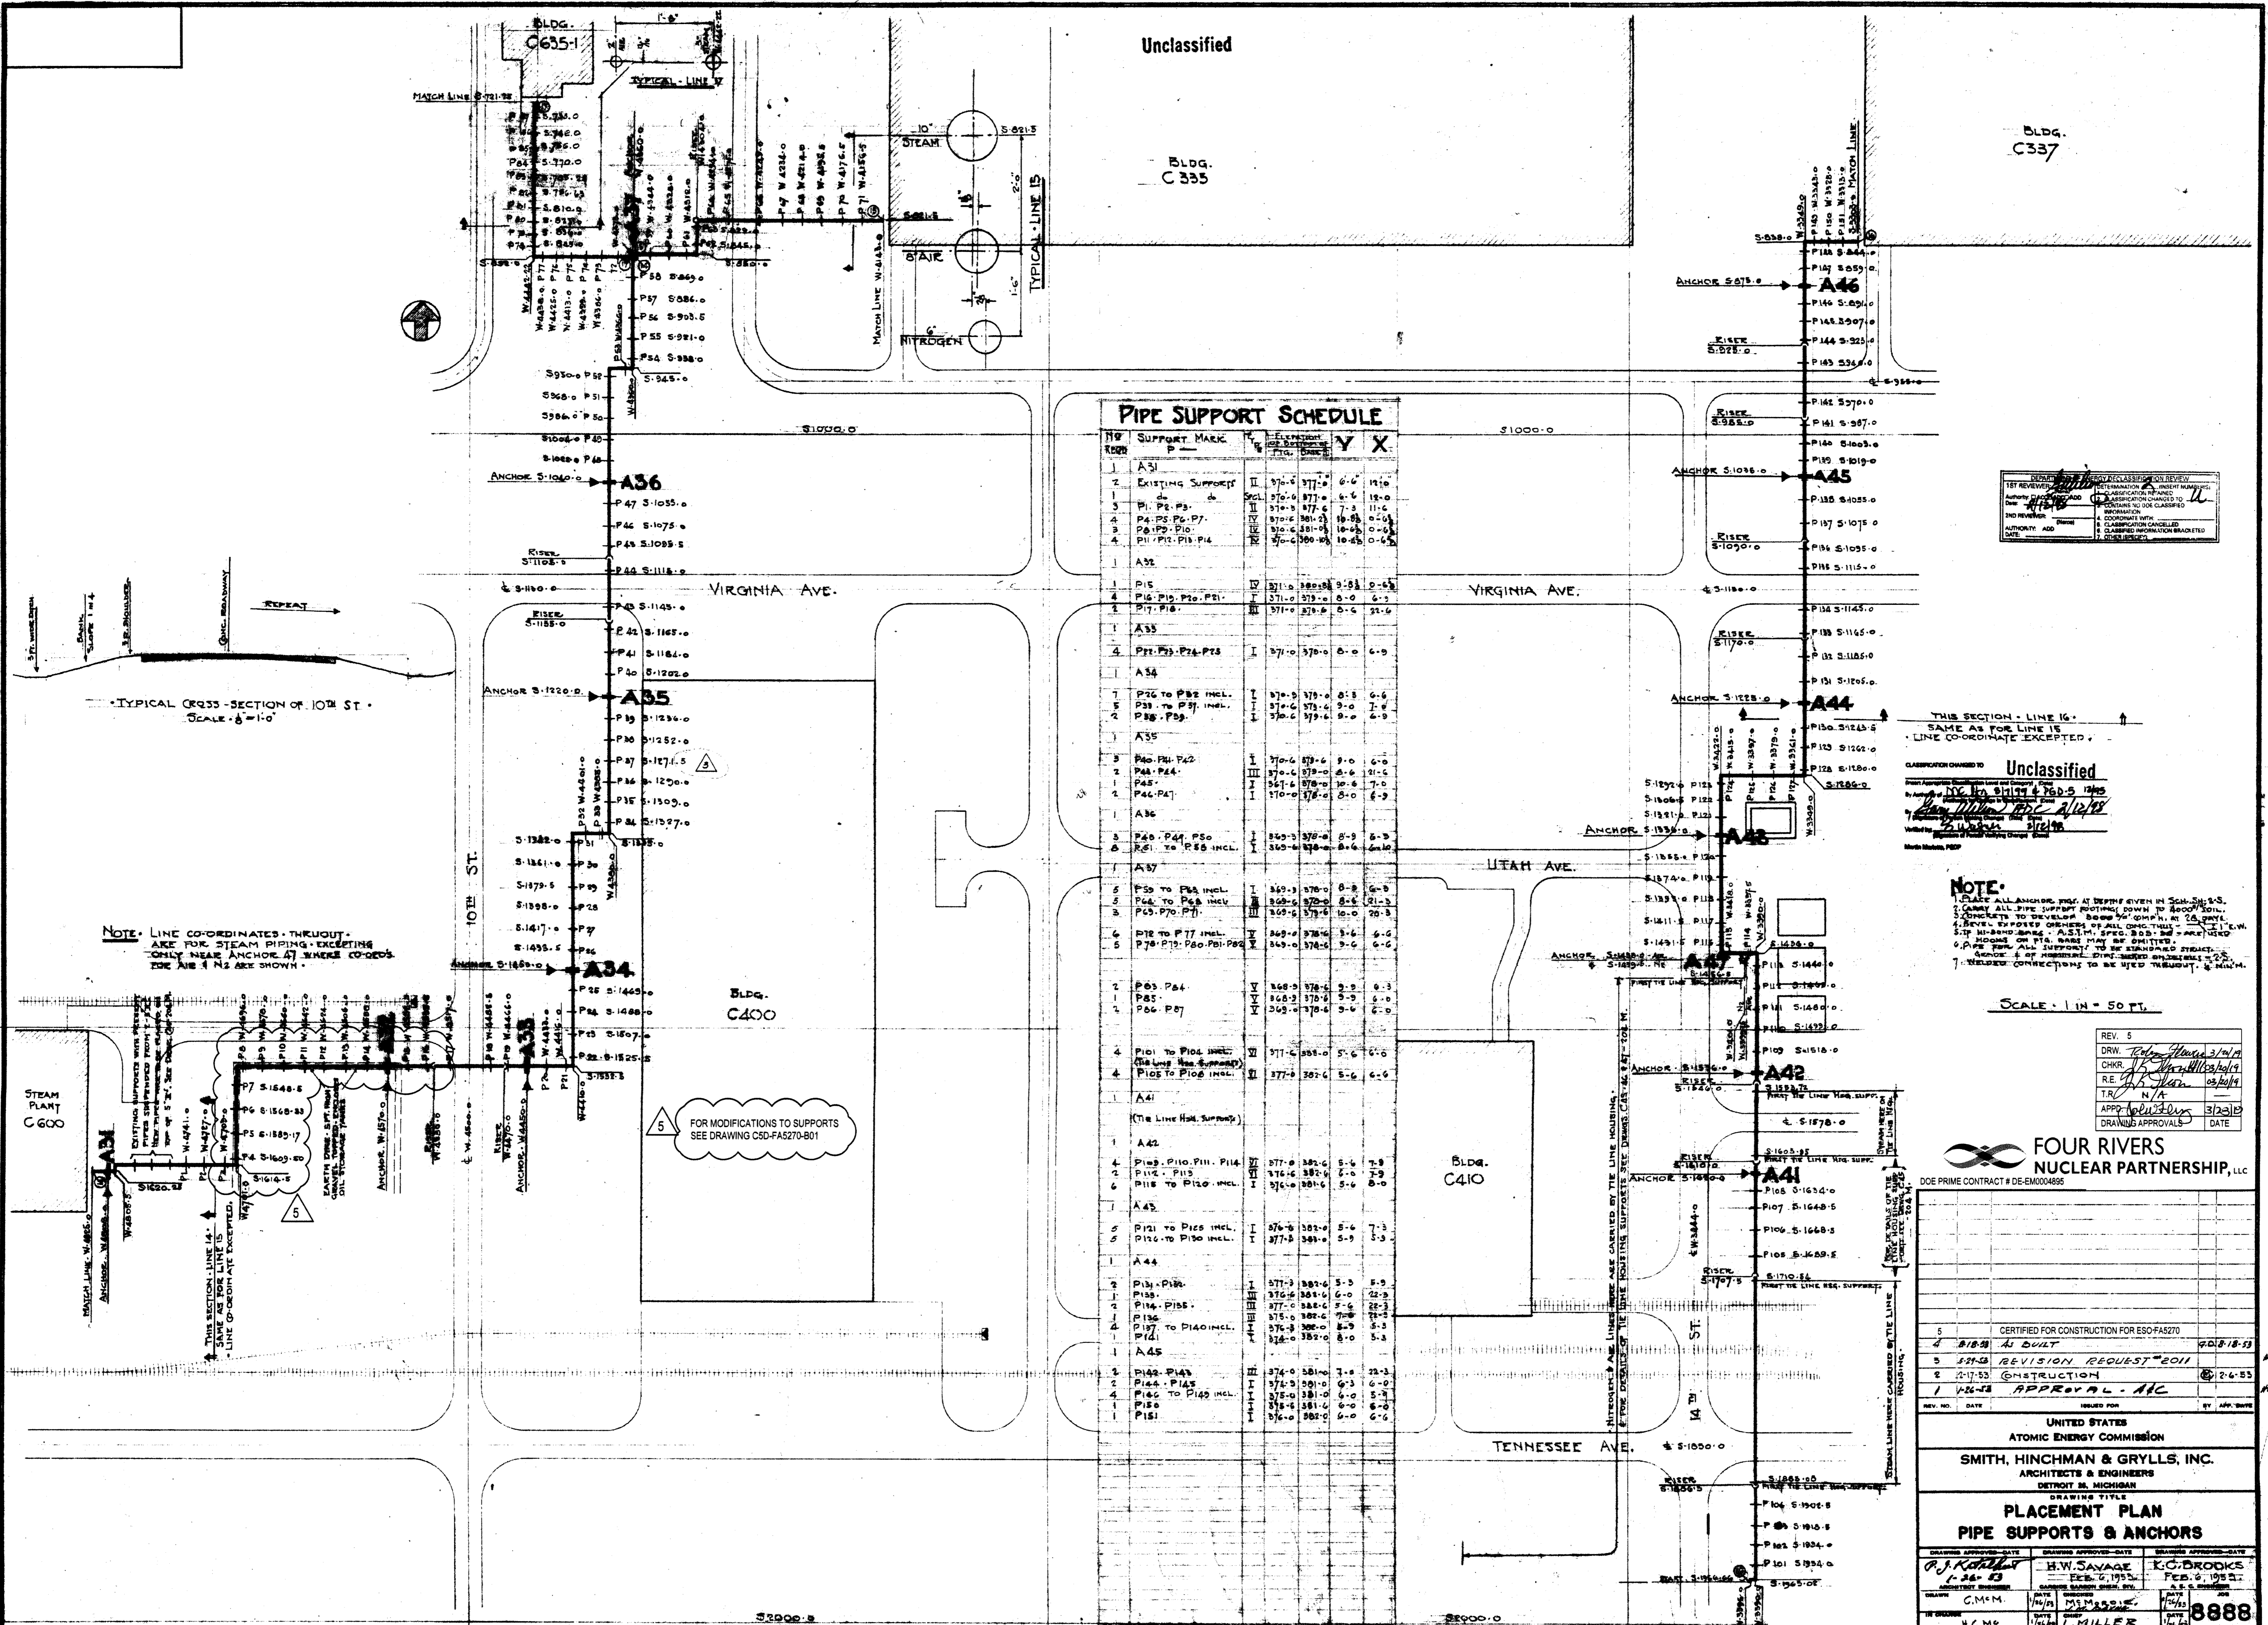

NOTE: LINE COORDINATES THROUGHOUT ARE FOR STEAM PIPING. EXCEPTING ONLY NEAR ANCHOR AT WHERE COORDS. ZONE ARE 1 & 2 ARE SHOWN.

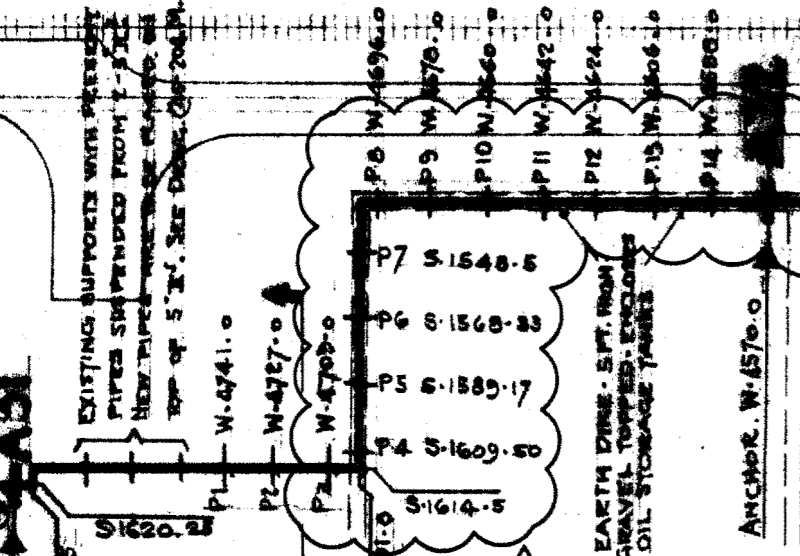

FOR MODIFICATIONS TO SUPPORTS SEE DRAWING CSD-FA5270-B01